
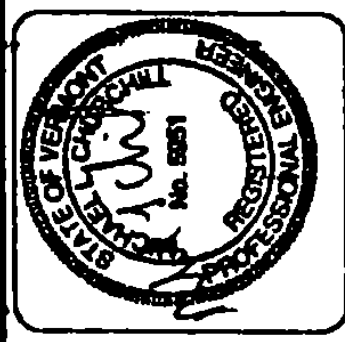
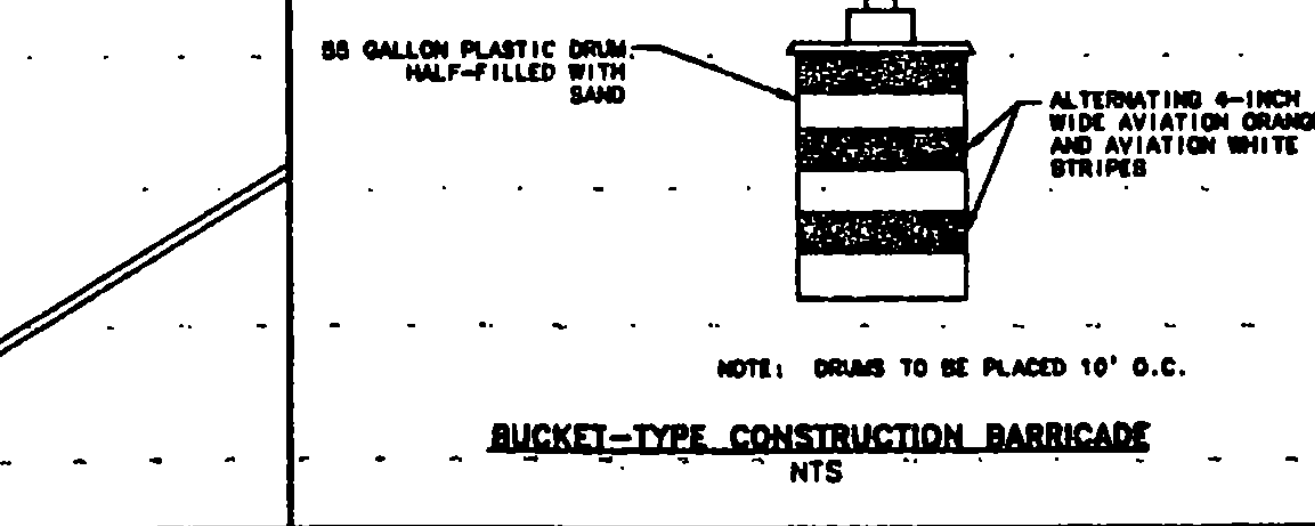
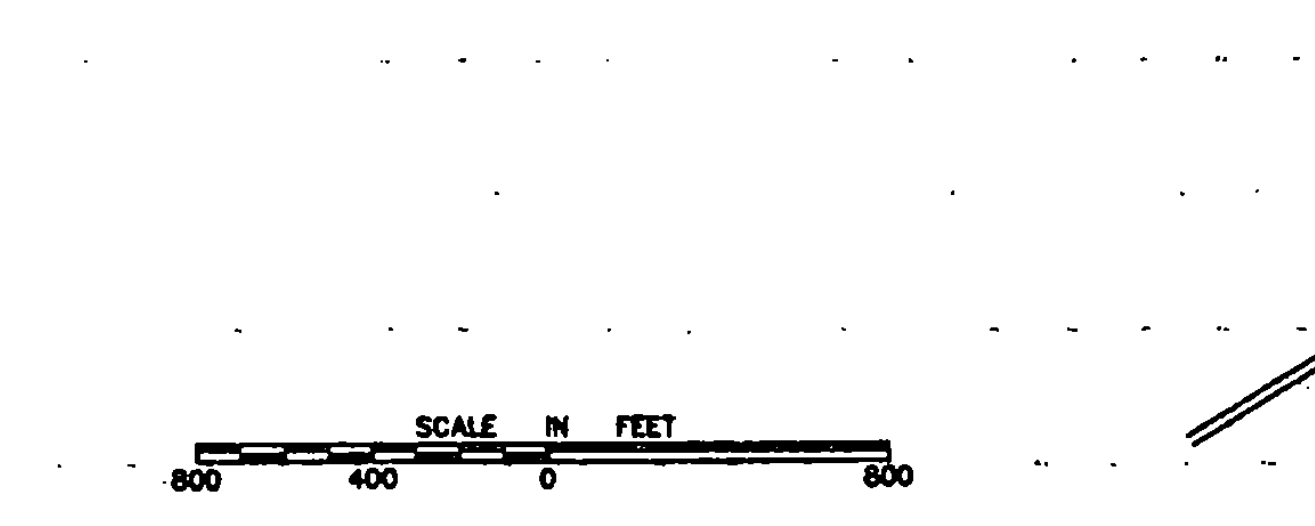
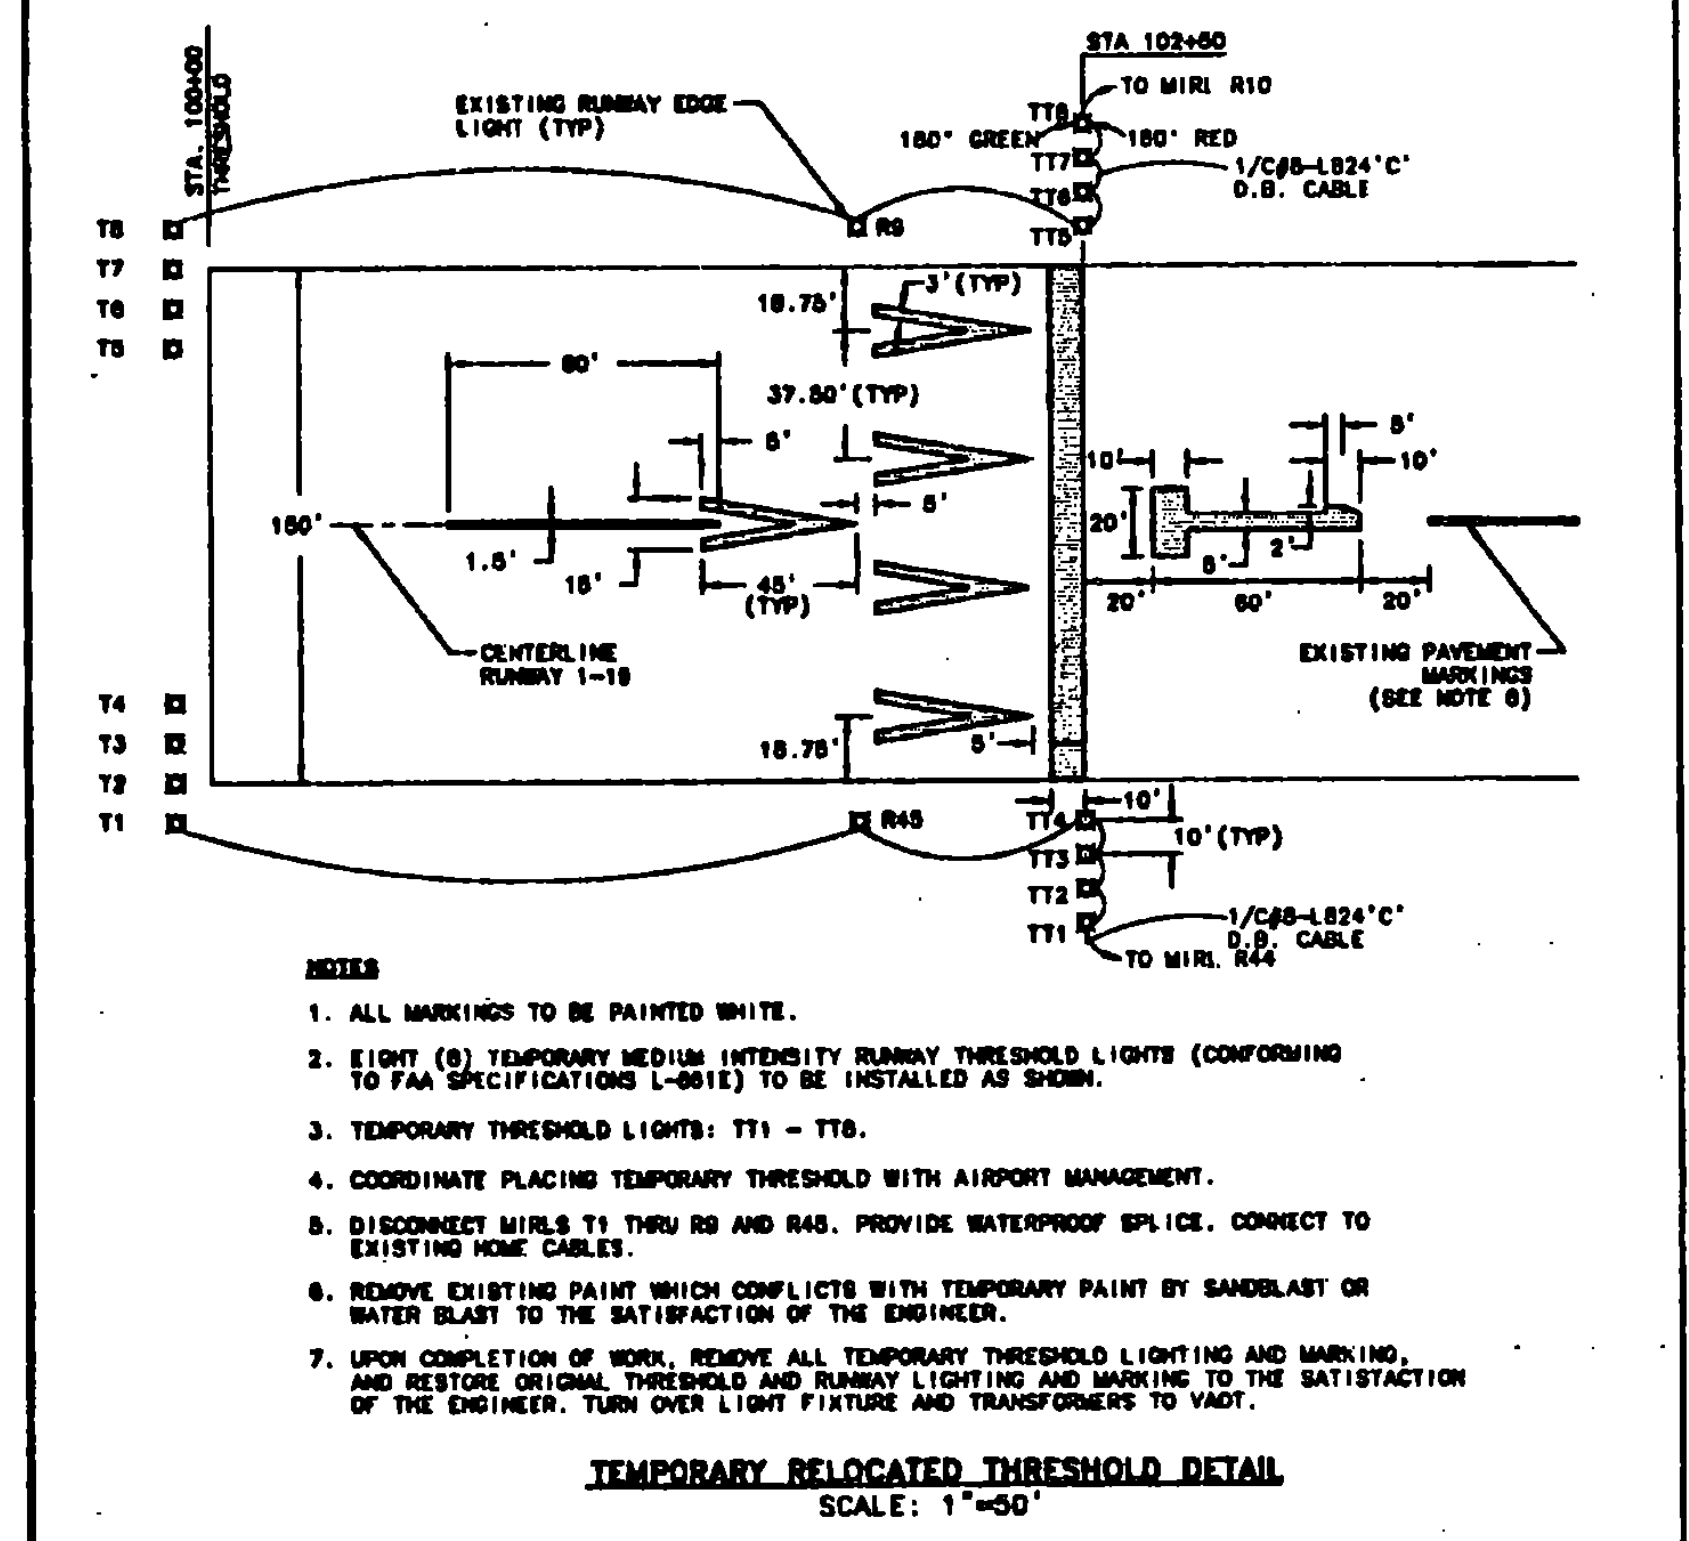


- GENERAL NOTES:**
- CONTRACTOR'S MAIN ACCESS TO SITE TO BE FROM TOWN HIGHWAY NO. 7.
 - CONTRACTOR TO PROVIDE FLAGPERSON AT HAUL / ACCESS ROUTE CROSSING OF RUNWAY 13 SAFETY AREA, WHEN RUNWAY 13-31 IS OPERATIONAL.
 - FLAGPERSON TO CONTROL ACCESS WITHIN RUNWAY 13-31 SAFETY AREA. NO GROUND VEHICLE TRAFFIC WILL BE ALLOWED TO ENTER RUNWAY SAFETY AREA WHEN AIR CRAFT ARE APPROACHING OR DEPARTING RUNWAY 13-31.
 - FLAGPERSON SHALL MONITOR AN AERONAUTICAL RADIO CAPABLE OF TRANSMITTING AND RECEIVING ON RUTLAND UNICOM FREQUENCY 122.8 MHZ.
 - HAUL ROUTE TO BE GRADED AND RETURNED TO TURF UPON COMPLETION OF PROJECT.
 - PHASING OF CONSTRUCTION ACTIVITIES. CONTRACTOR SHALL COORDINATE ALL RUNWAY CLOSURES WITH THE AIRPORT MANAGER.
 - CONTRACTOR MAY INSTALL TEMPORARY THRESHOLD LIGHTING WHILE RUNWAY IS ACTIVE. HOWEVER, WHEN AIRCRAFT ARE UTILIZING THE RUNWAY, THE CONTRACTOR SHALL REMOVE HIS EQUIPMENT AND MEN FROM THE RUNWAY SAFETY AREA.
 - WHEN THE CONTRACTOR IS PREPARED TO CONNECT THE ELECTRICAL CIRCUITRY AND INSTALL THE THRESHOLD MARKINGS, HE SHALL CLOSE RUNWAY 1-19 WITH RUNWAY CLOSED MARKERS. THIS WORK SHALL BE DONE WITHIN 1 1/2 HOUR PERIOD, BETWEEN THE HOURS OF 7:00 PM AND 7:00 AM. AT THE END OF THIS TIME PERIOD THE RUNWAY SHALL BE REOPENED TO AIRCRAFT ACTIVITY.
 - INSTALL LOCALIZER ANTENNA AND SHELTER FOUNDATION AND OTHER RELATED INFRASTRUCTURE WORK.
 - AT COMPLETION OF INFRASTRUCTURE WORK, THE CONTRACTOR SHALL REMOVE THE TEMPORARY THRESHOLD AND MARKINGS. RUNWAY 1-19 SHALL BE CLOSED WITH RUNWAY CLOSED MARKERS, AND REMOVAL OF THE RELOCATED THRESHOLD EQUIPMENT AND MARKINGS, AND INSTALLATION OF ORIGINAL MARKINGS SHALL BE ACCOMPLISHED. THIS WORK SHALL BE DONE WITHIN 1 1/2 HOUR PERIOD, BETWEEN THE HOURS OF 7:00 PM AND 7:00 AM. AT THE END OF THIS TIME PERIOD THE RUNWAY SHALL BE REOPENED TO AIRCRAFT ACTIVITY.

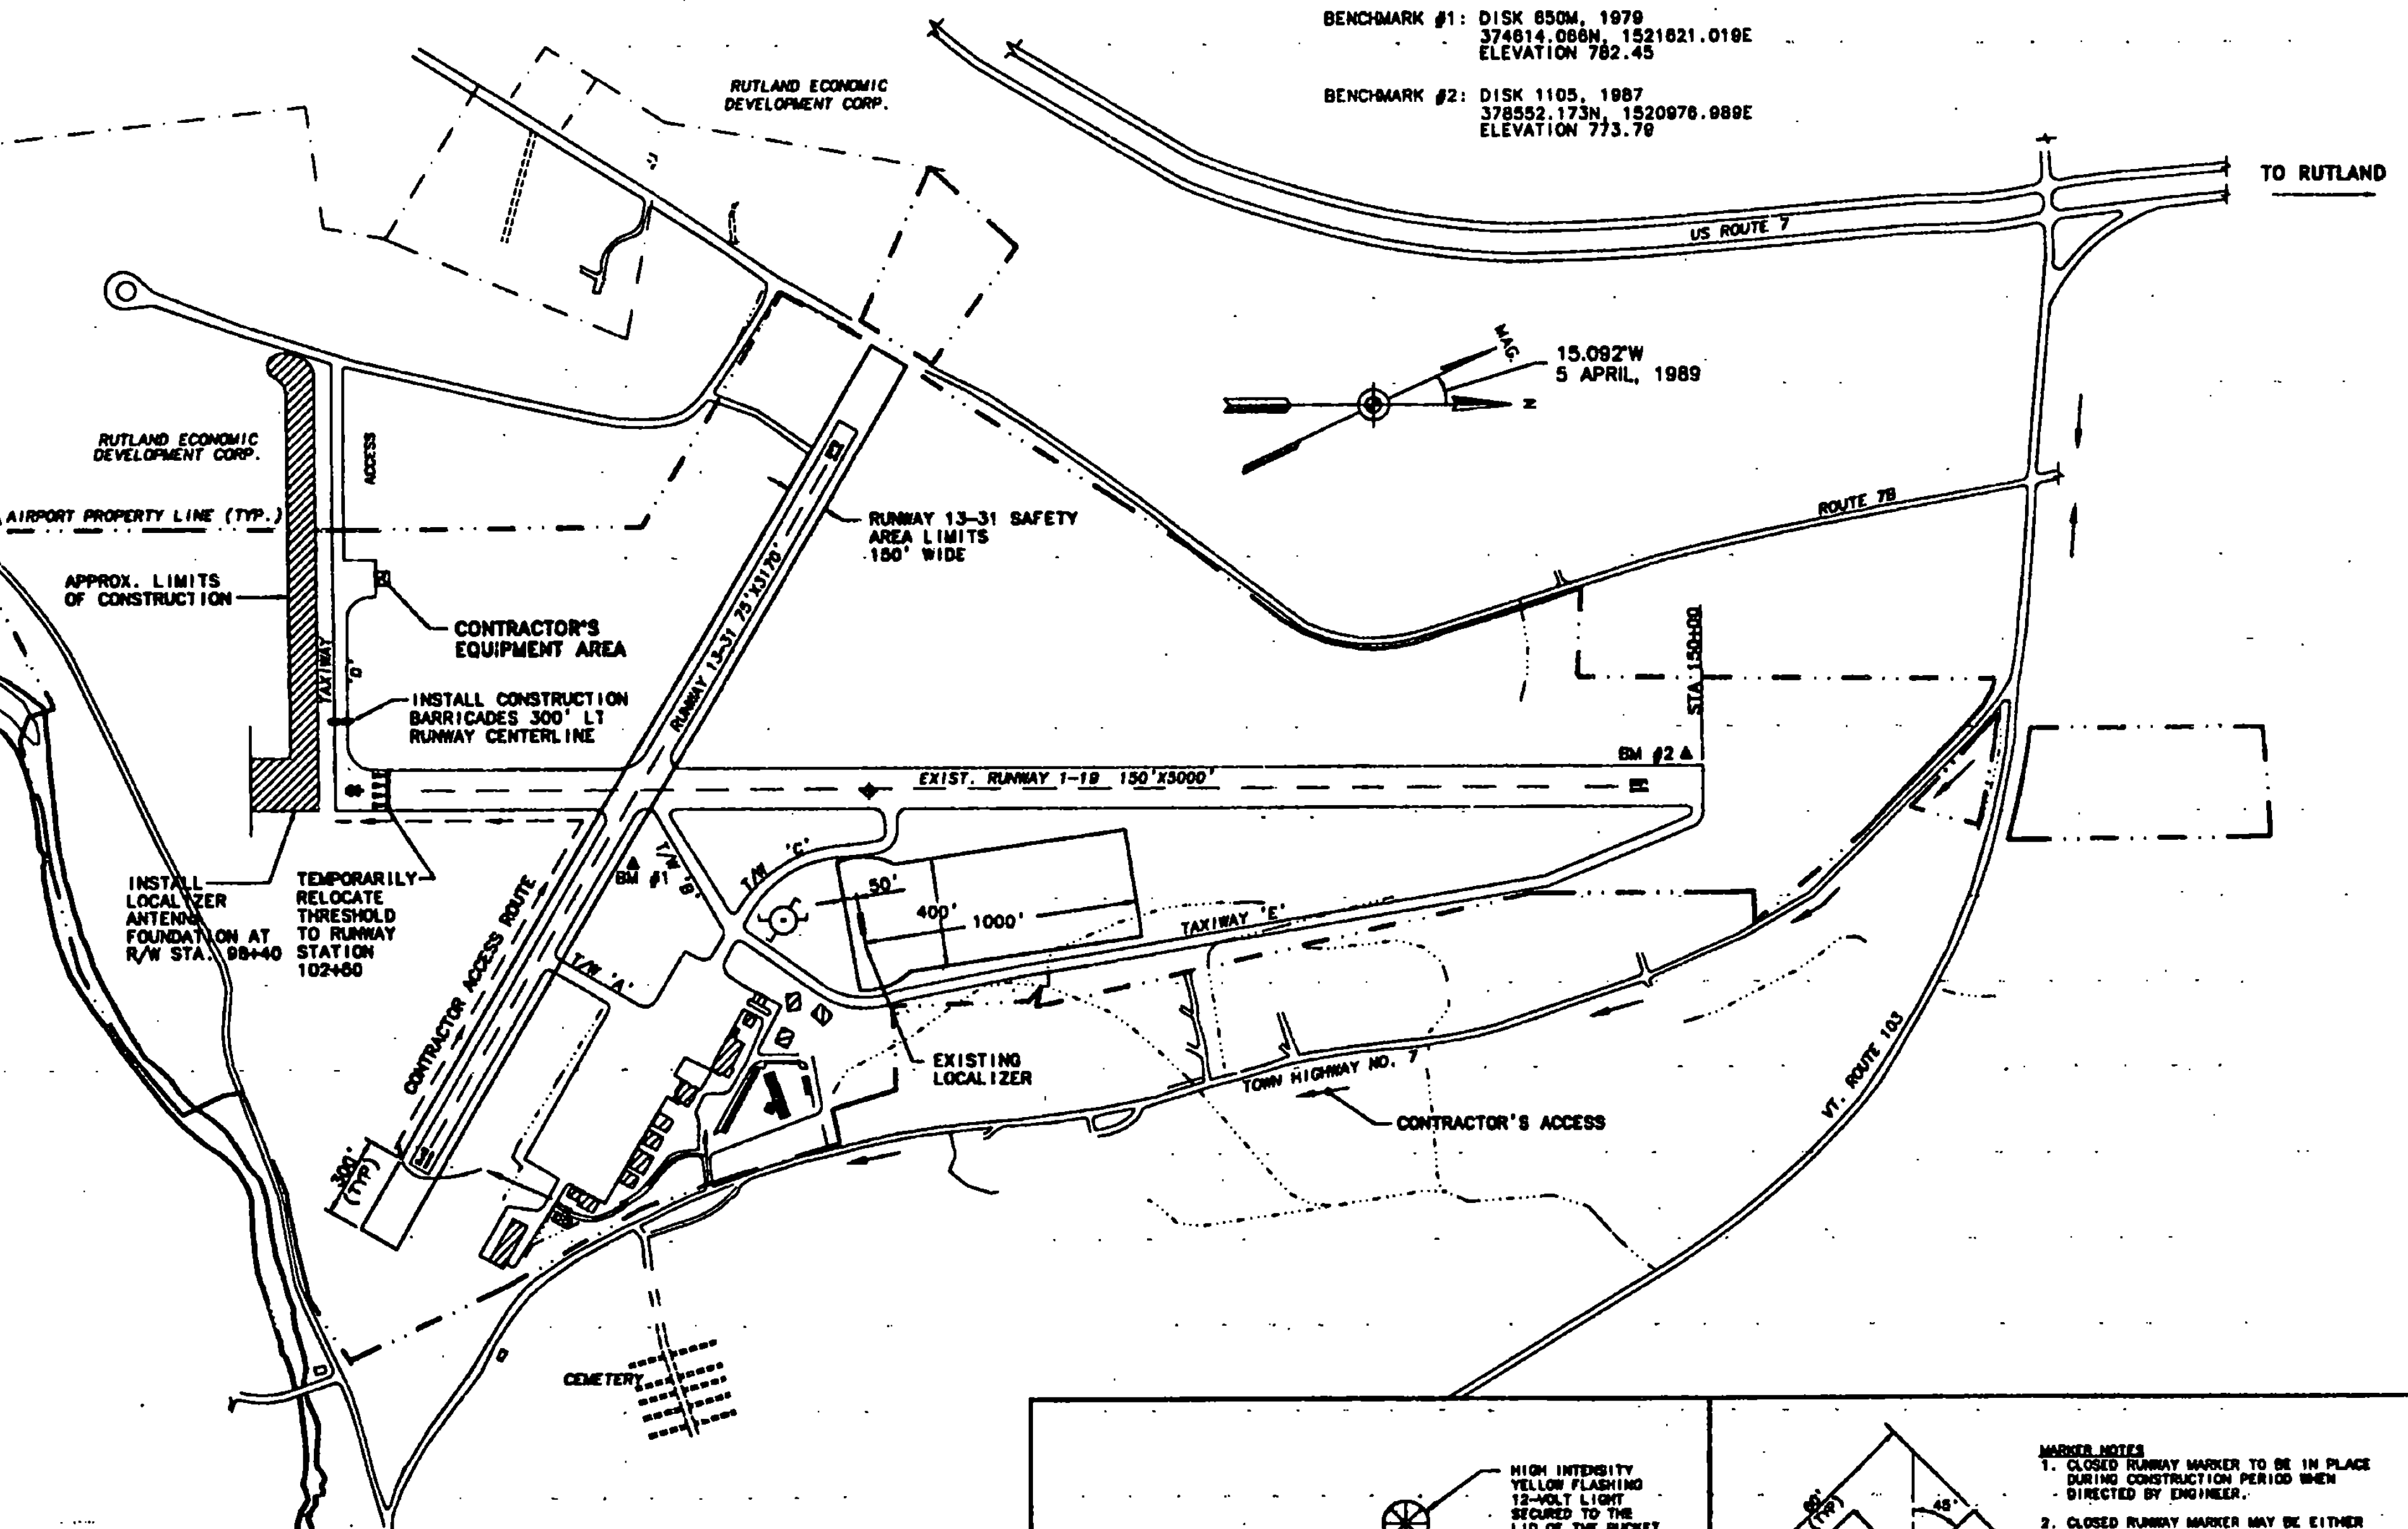

REV.	DATE	DESCRIPTION

Job No. 748122.00
File No. 11/14/1987

RUTLAND STATE AIRPORT
CLARENDON, VERMONT

GENERAL PROJECT LAYOUT

JRS Greiner, Inc.
3 MARCUS BOULEVARD
ALBANY, NEW YORK

Designed by: JRS	Drawn by: JRS	Checked by: JRS	Approved by: JRS
Date: 04/08/87	Scale: HOR. - 1" = 400'	VERT. - 1/4"	Sheet 2 of 3
Sheet No. 2			