





Sheet No. 4  
 Sheet 4 of 9  
 Date: 04/09/77  
 Scale: HOR. - 1" = 50'  
 VERT. - NONE  
 Designed by: Date  
 0 07/000 or 2/27/77  
 Drawn by: M. W. C. / M. W. C.  
 Checked by: M. W. C.  
 Approved by: M. W. C.  
 in CONSULT.

**URS**  
**Contractor, Inc.**  
 3 MARCUS BOULEVARD  
 ALBANY, NEW YORK

RUTLAND STATE AIRPORT  
 CLAREMONT, VERMONT  
 LOCALIZER RELOCATION - SITE PLAN

REV.	DATE	DESCRIPTION

Job No. 7402320  
 File No. 11/48715/34-40

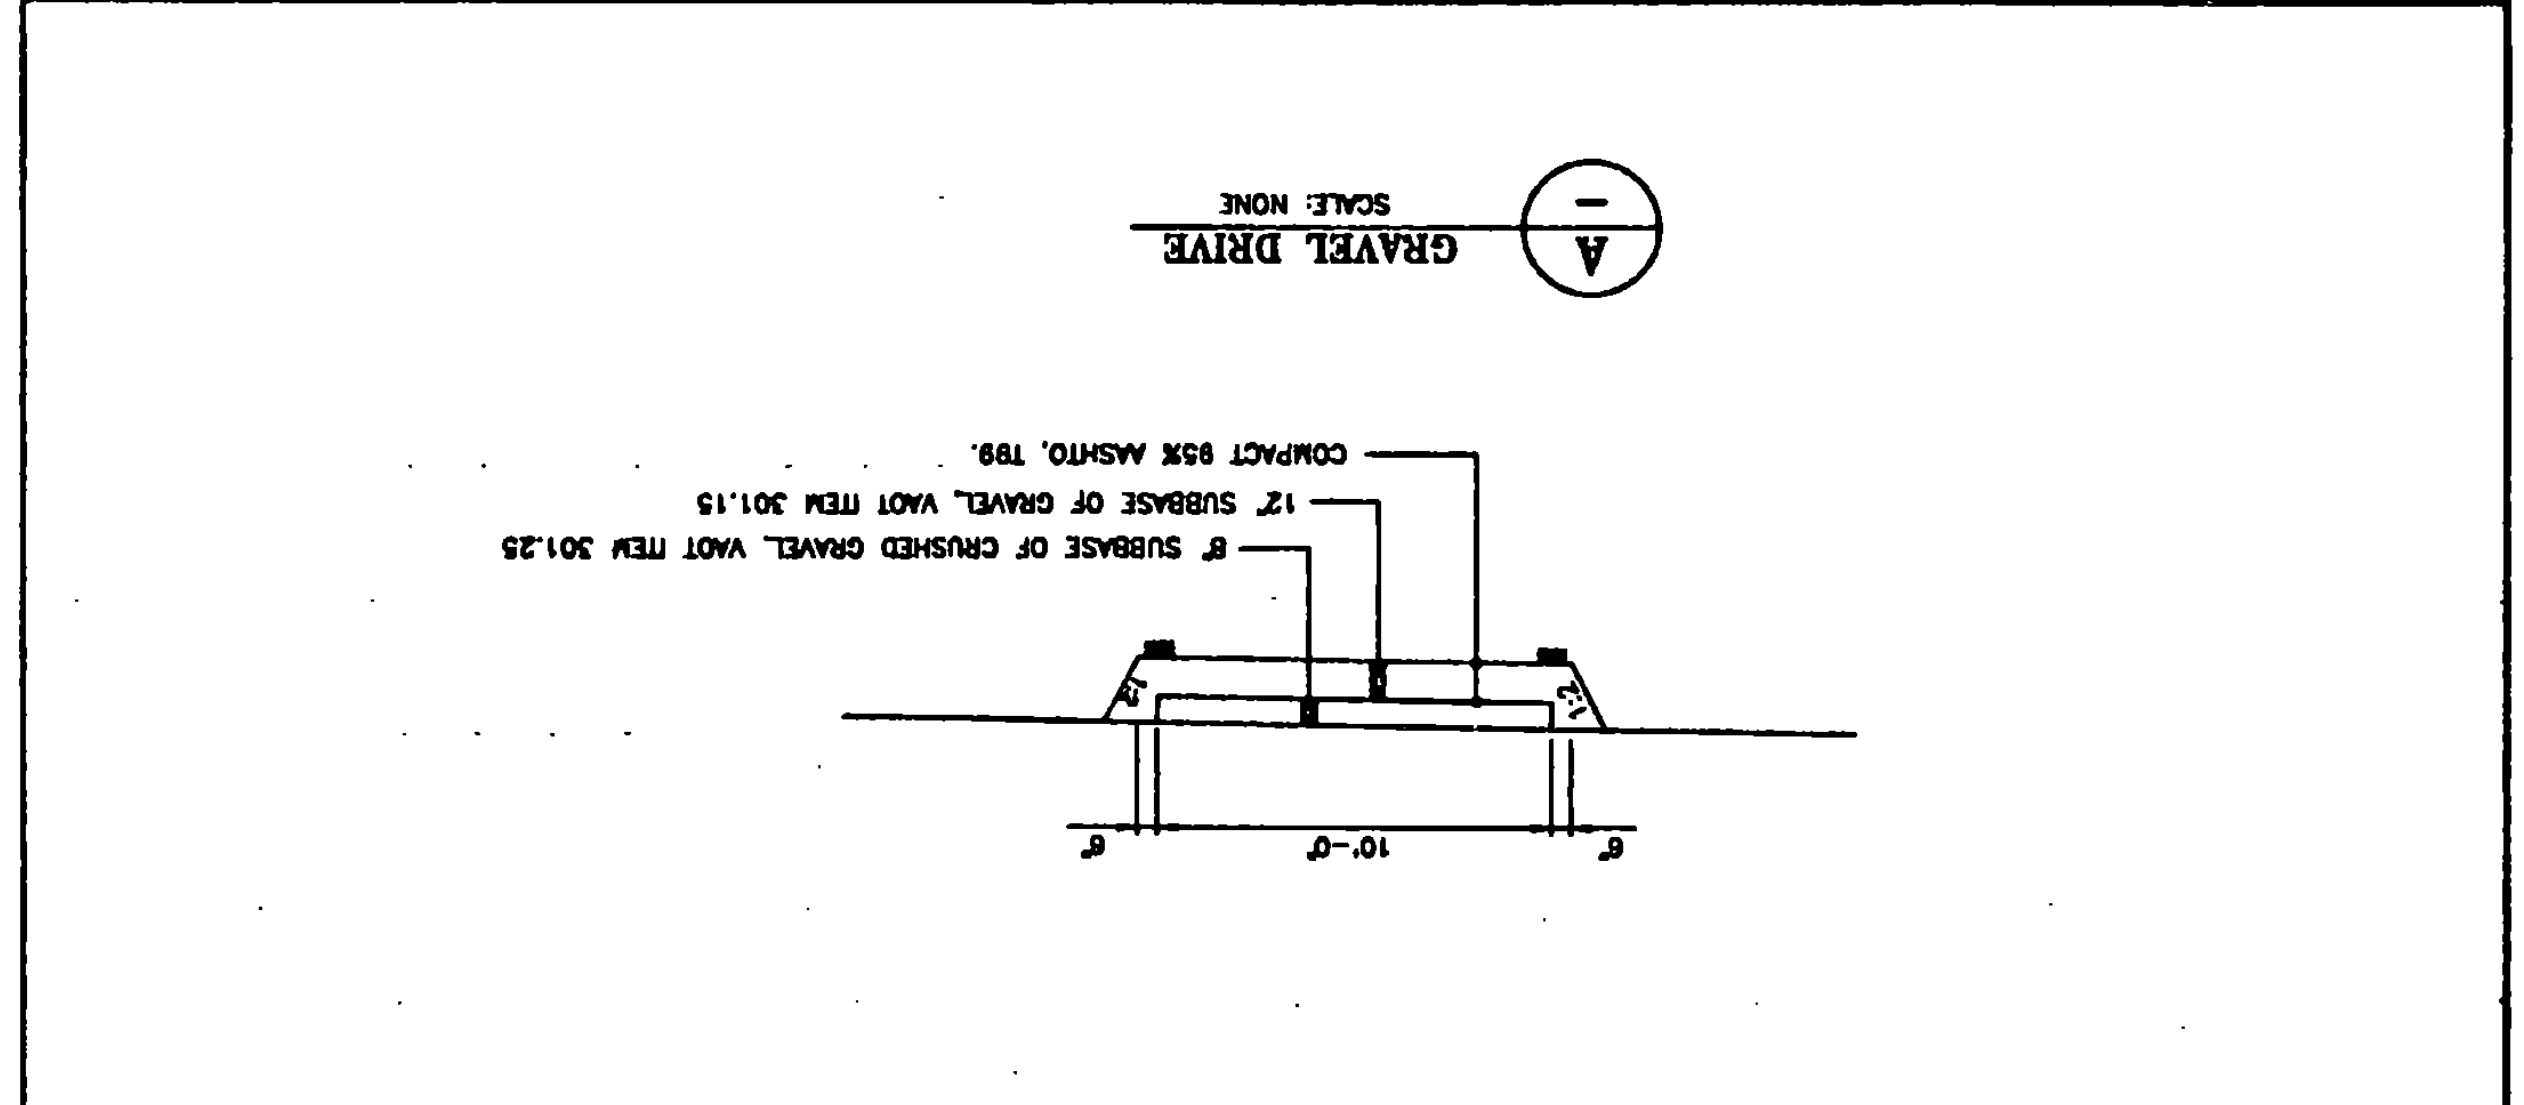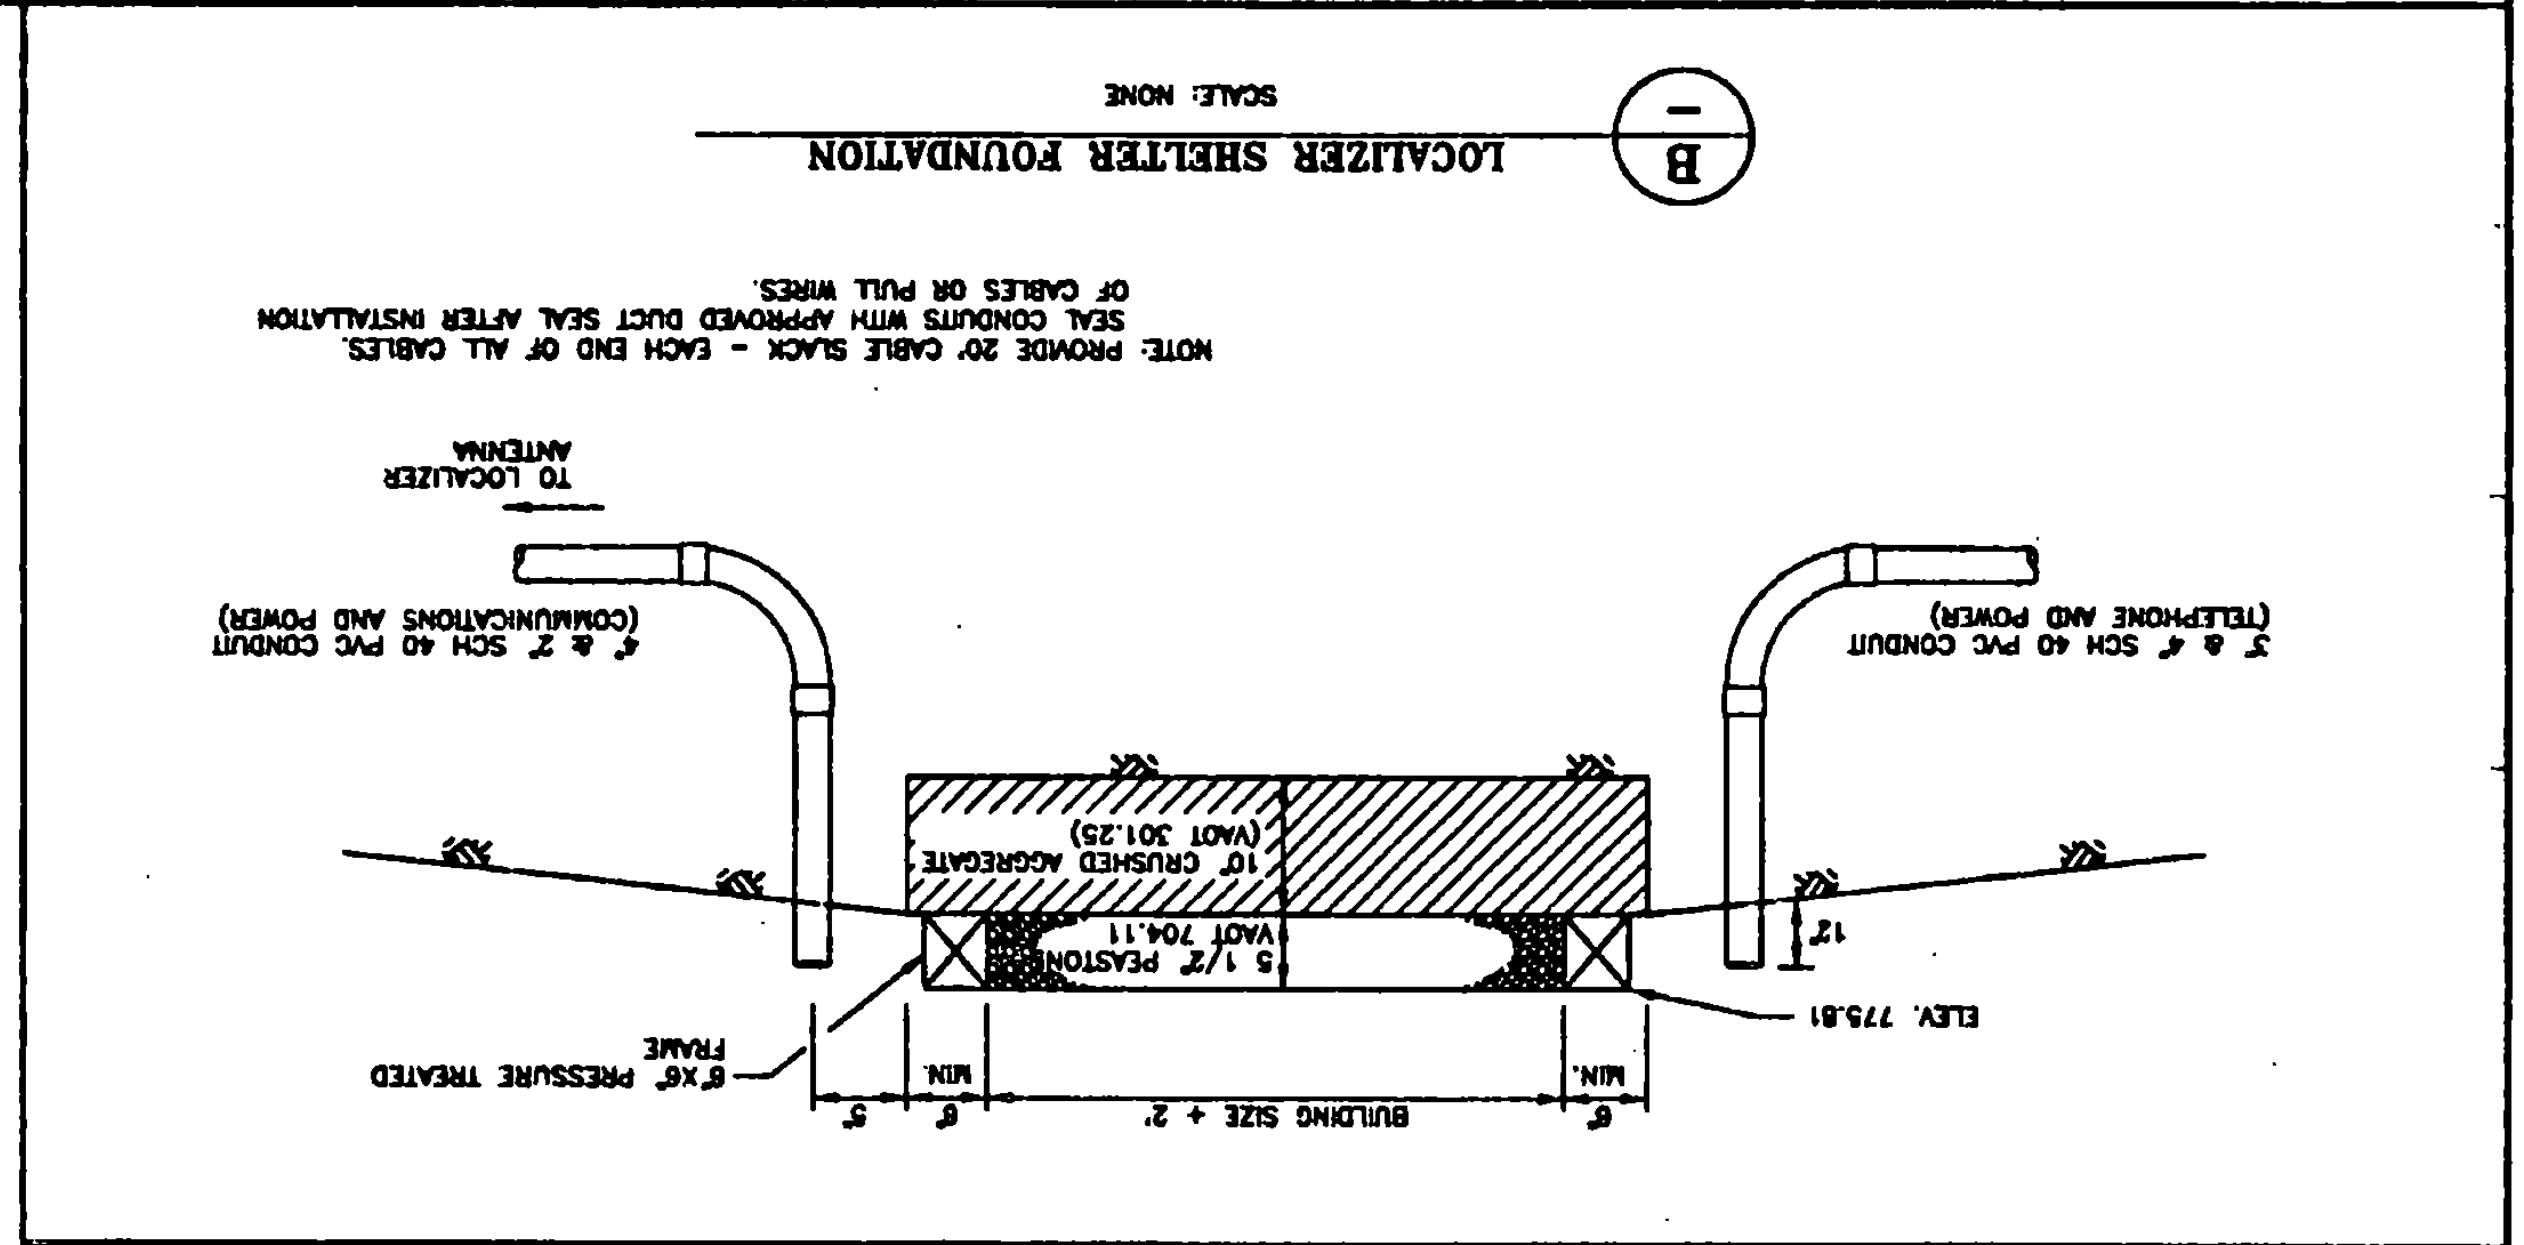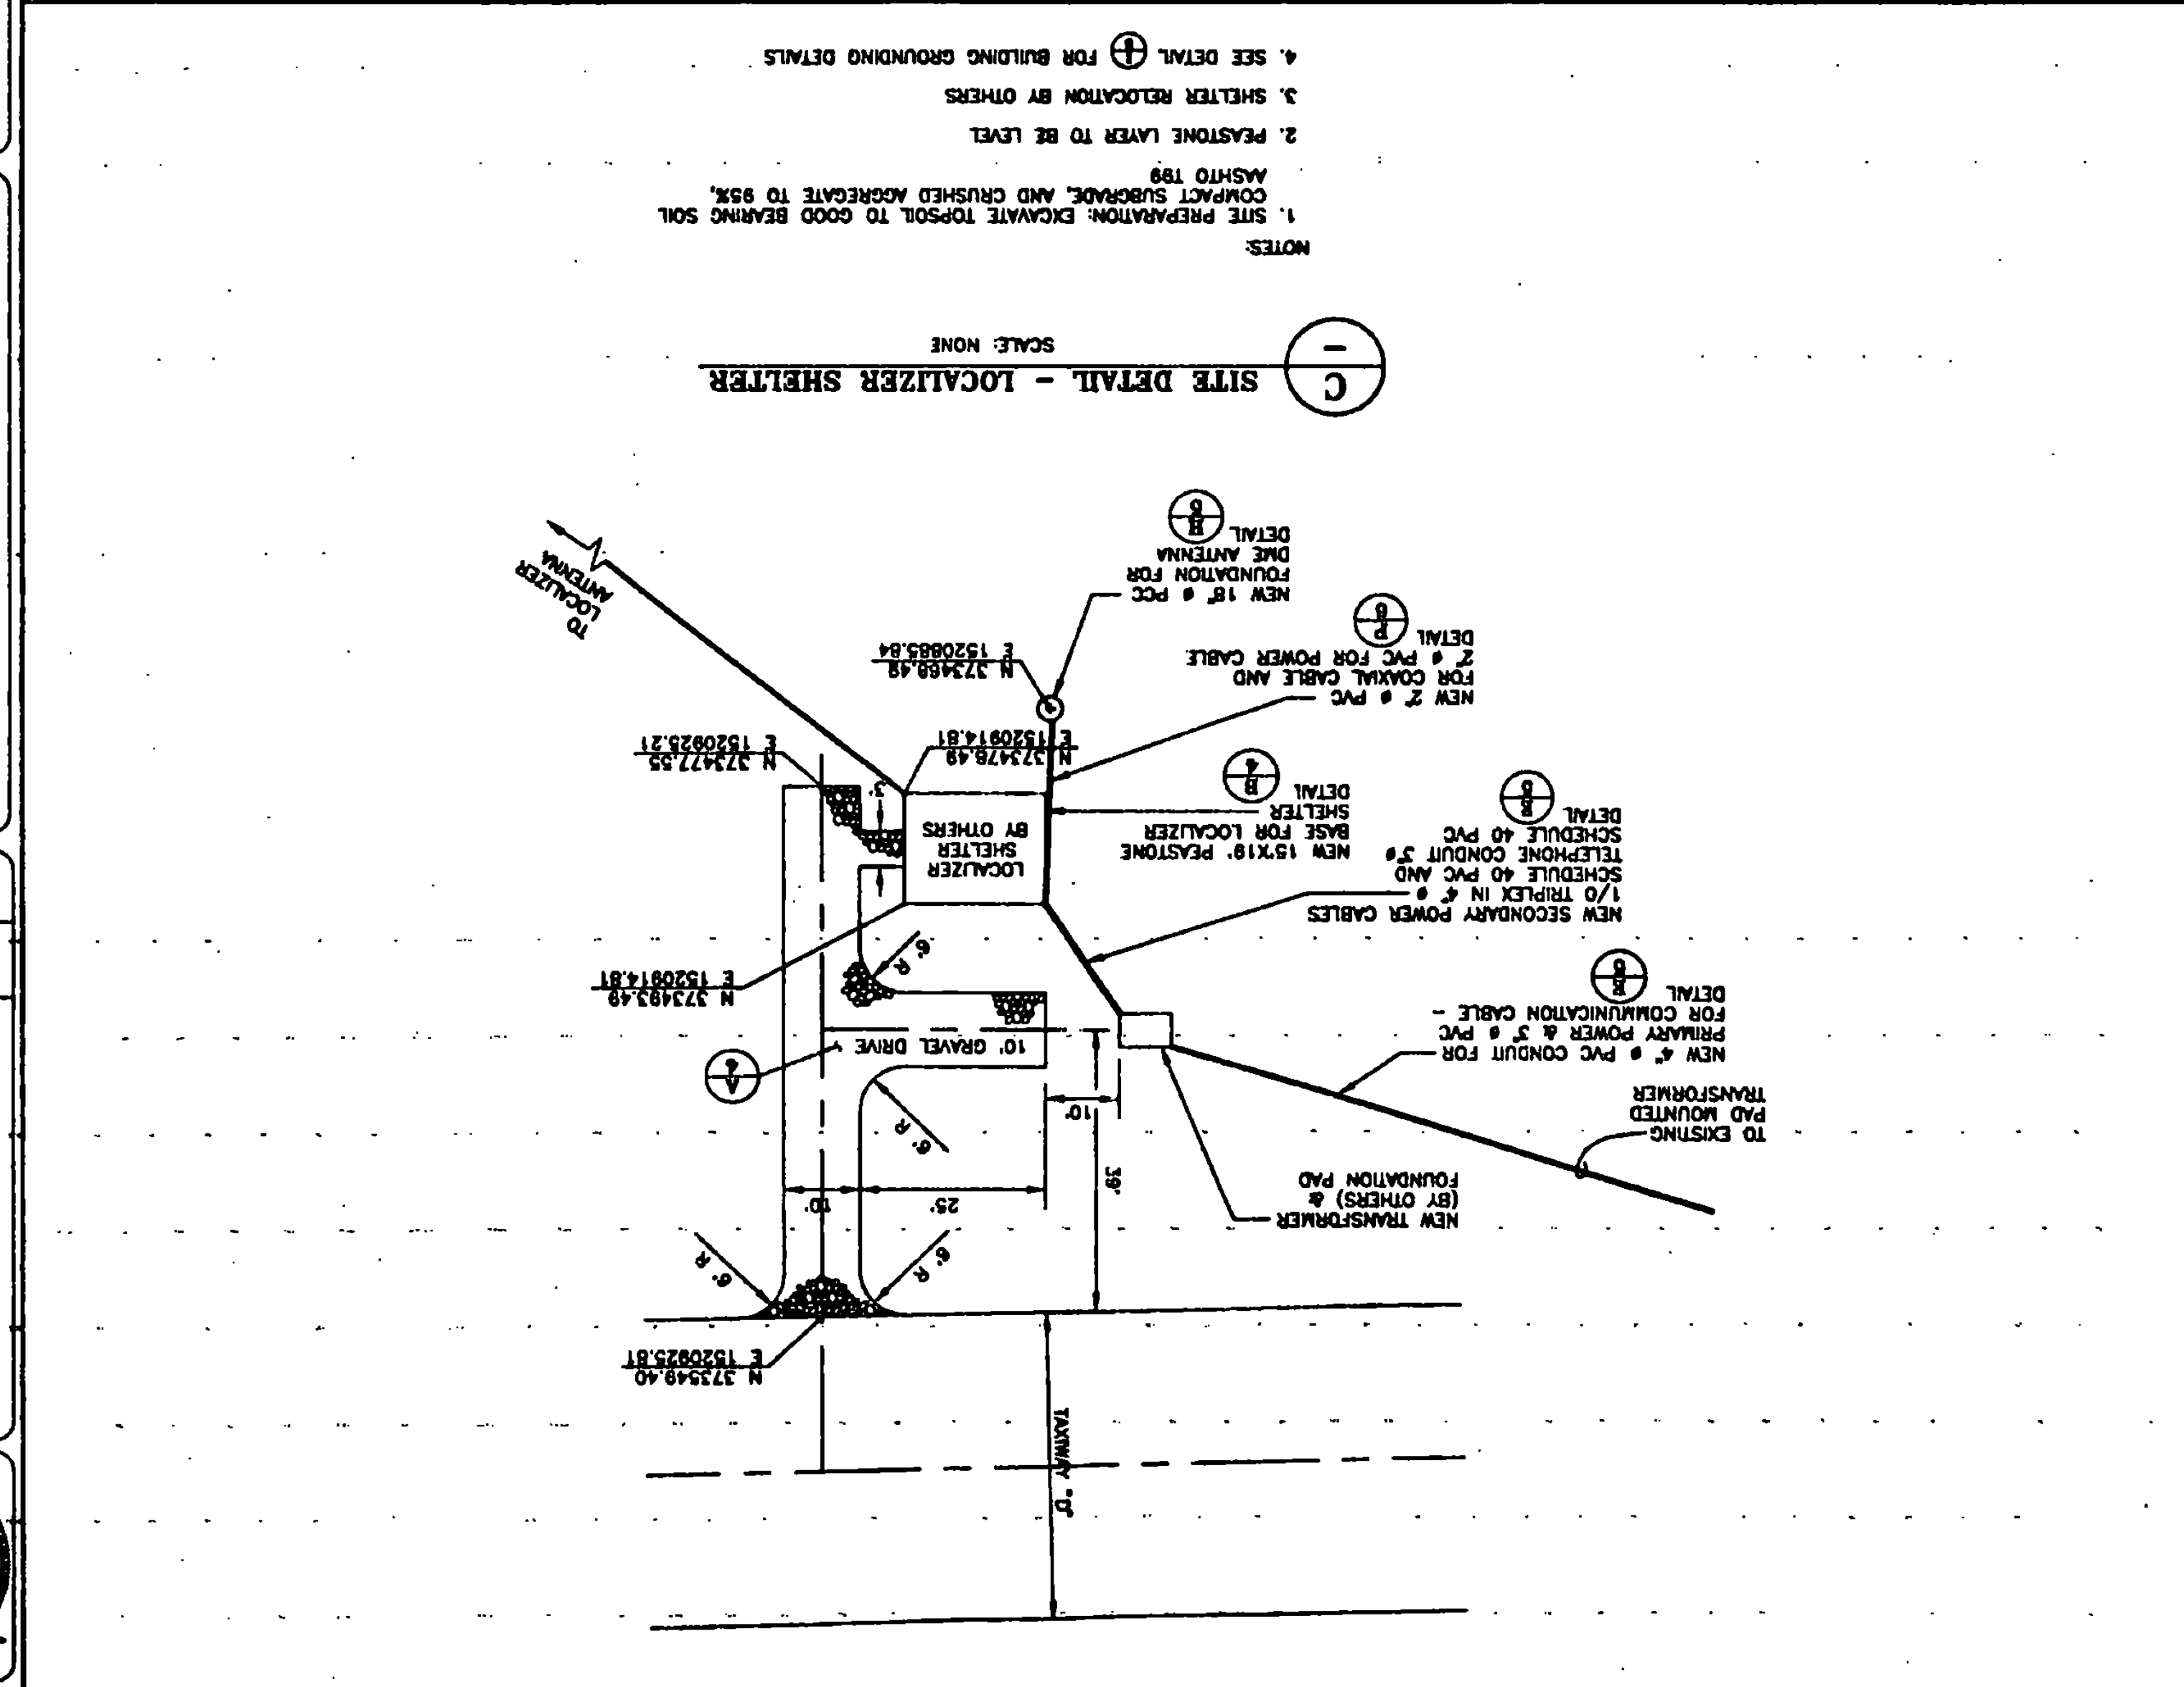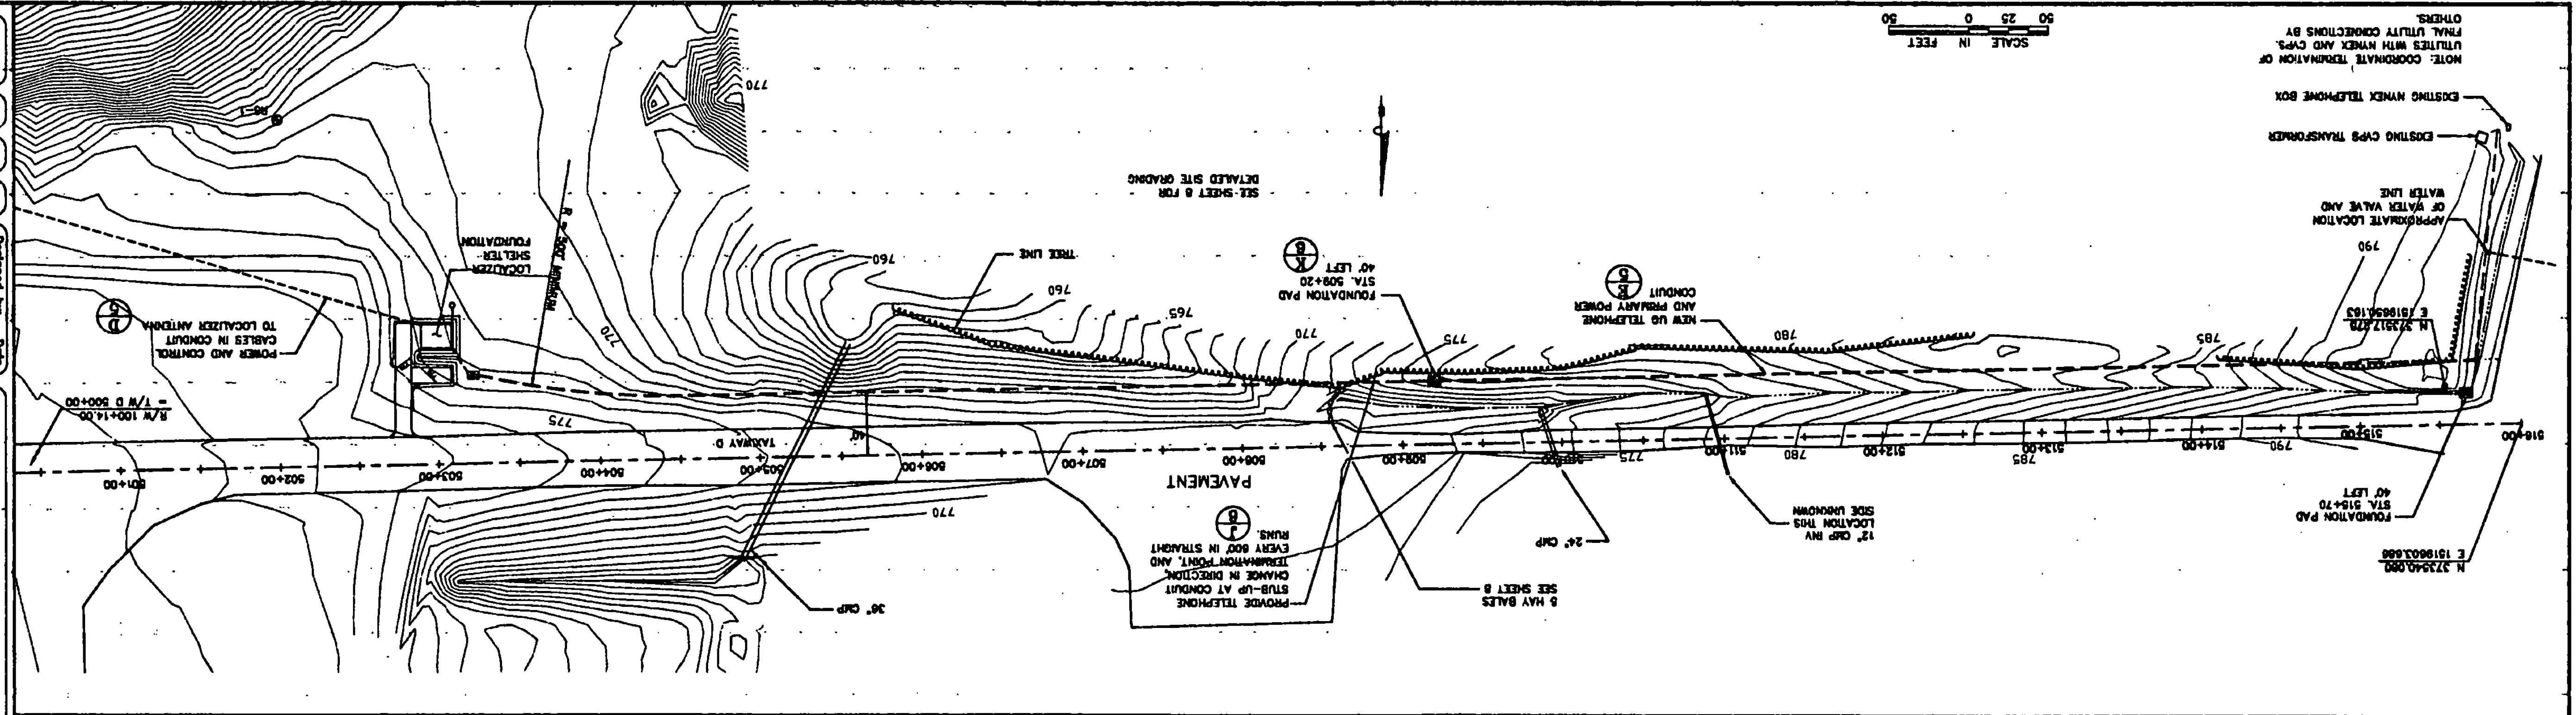

SCALE IN FEET  
 50 25 0

NOTE: COORDINATE TERMINATION OF UTILITIES WITH NINEK AND C/P'S. FINAL UTILITY CONNECTIONS BY OTHERS.