



**RUNWAY 1-19 PROFILE
STA 108+50 TO 121+00**

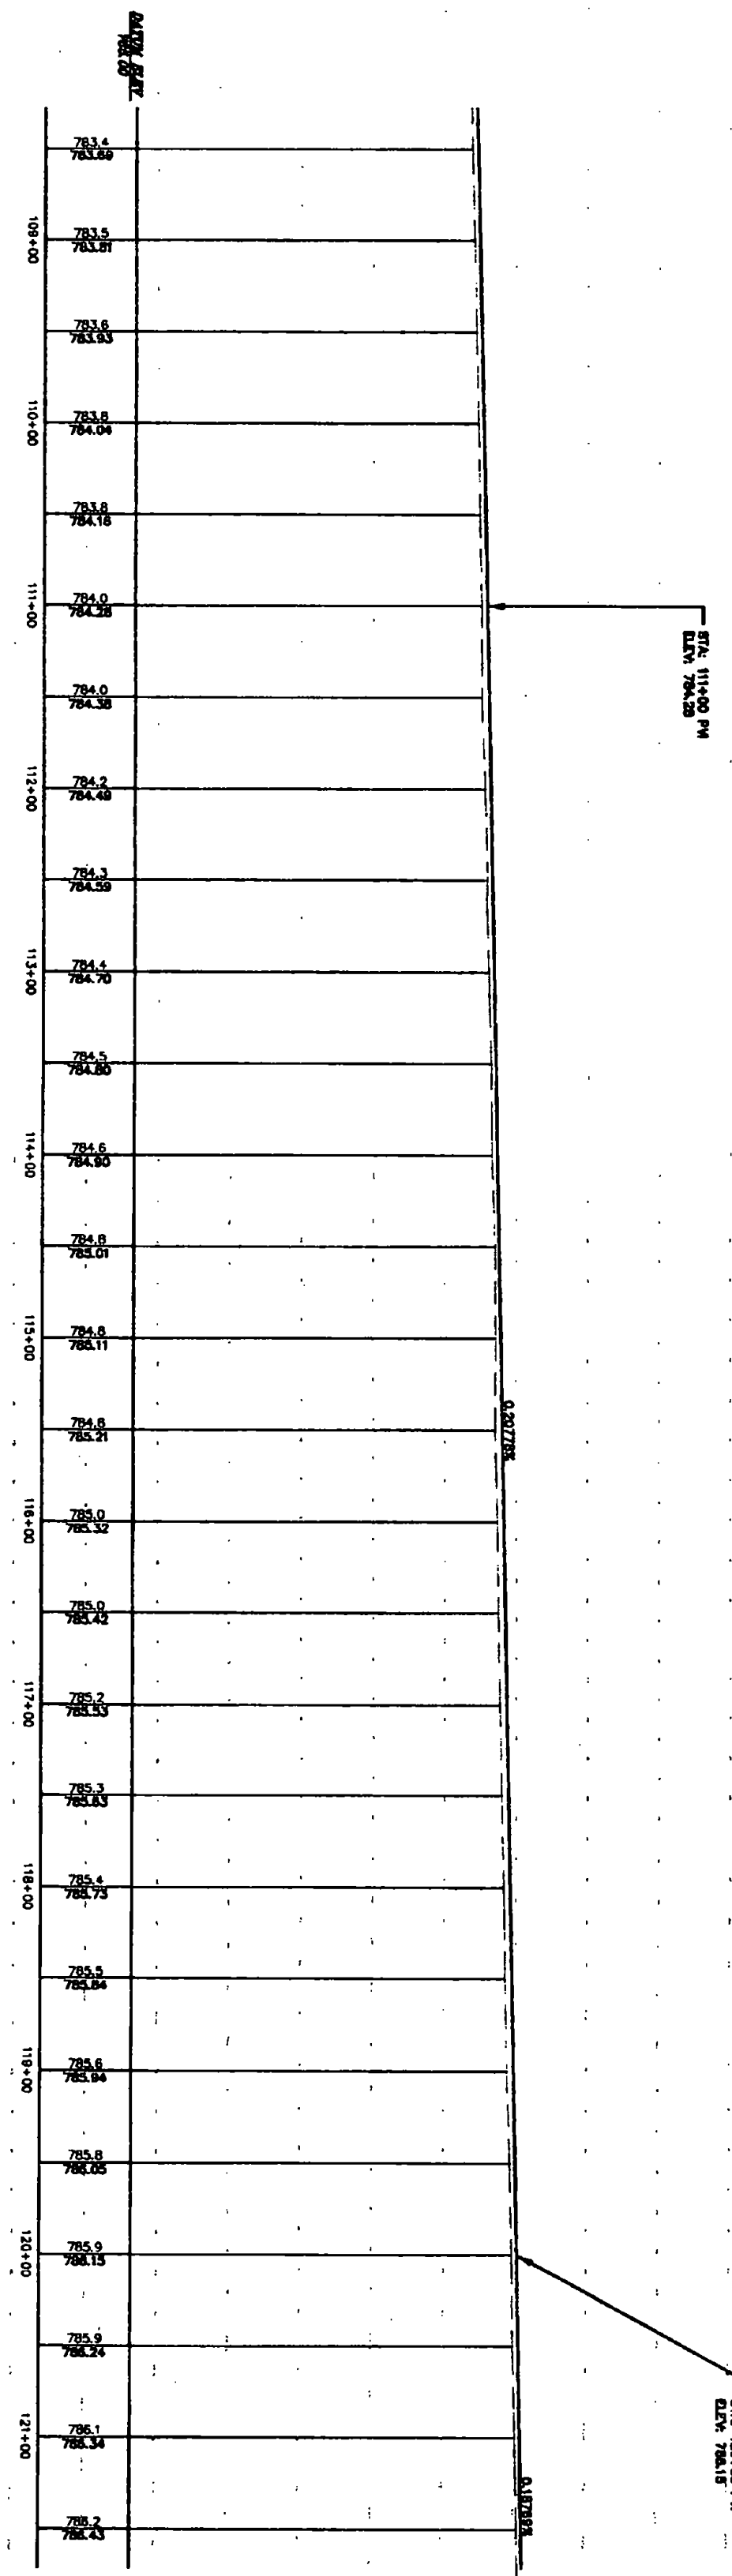

**RUNWAY 1-19 PROFILE
STA 94+00 TO 108+00**

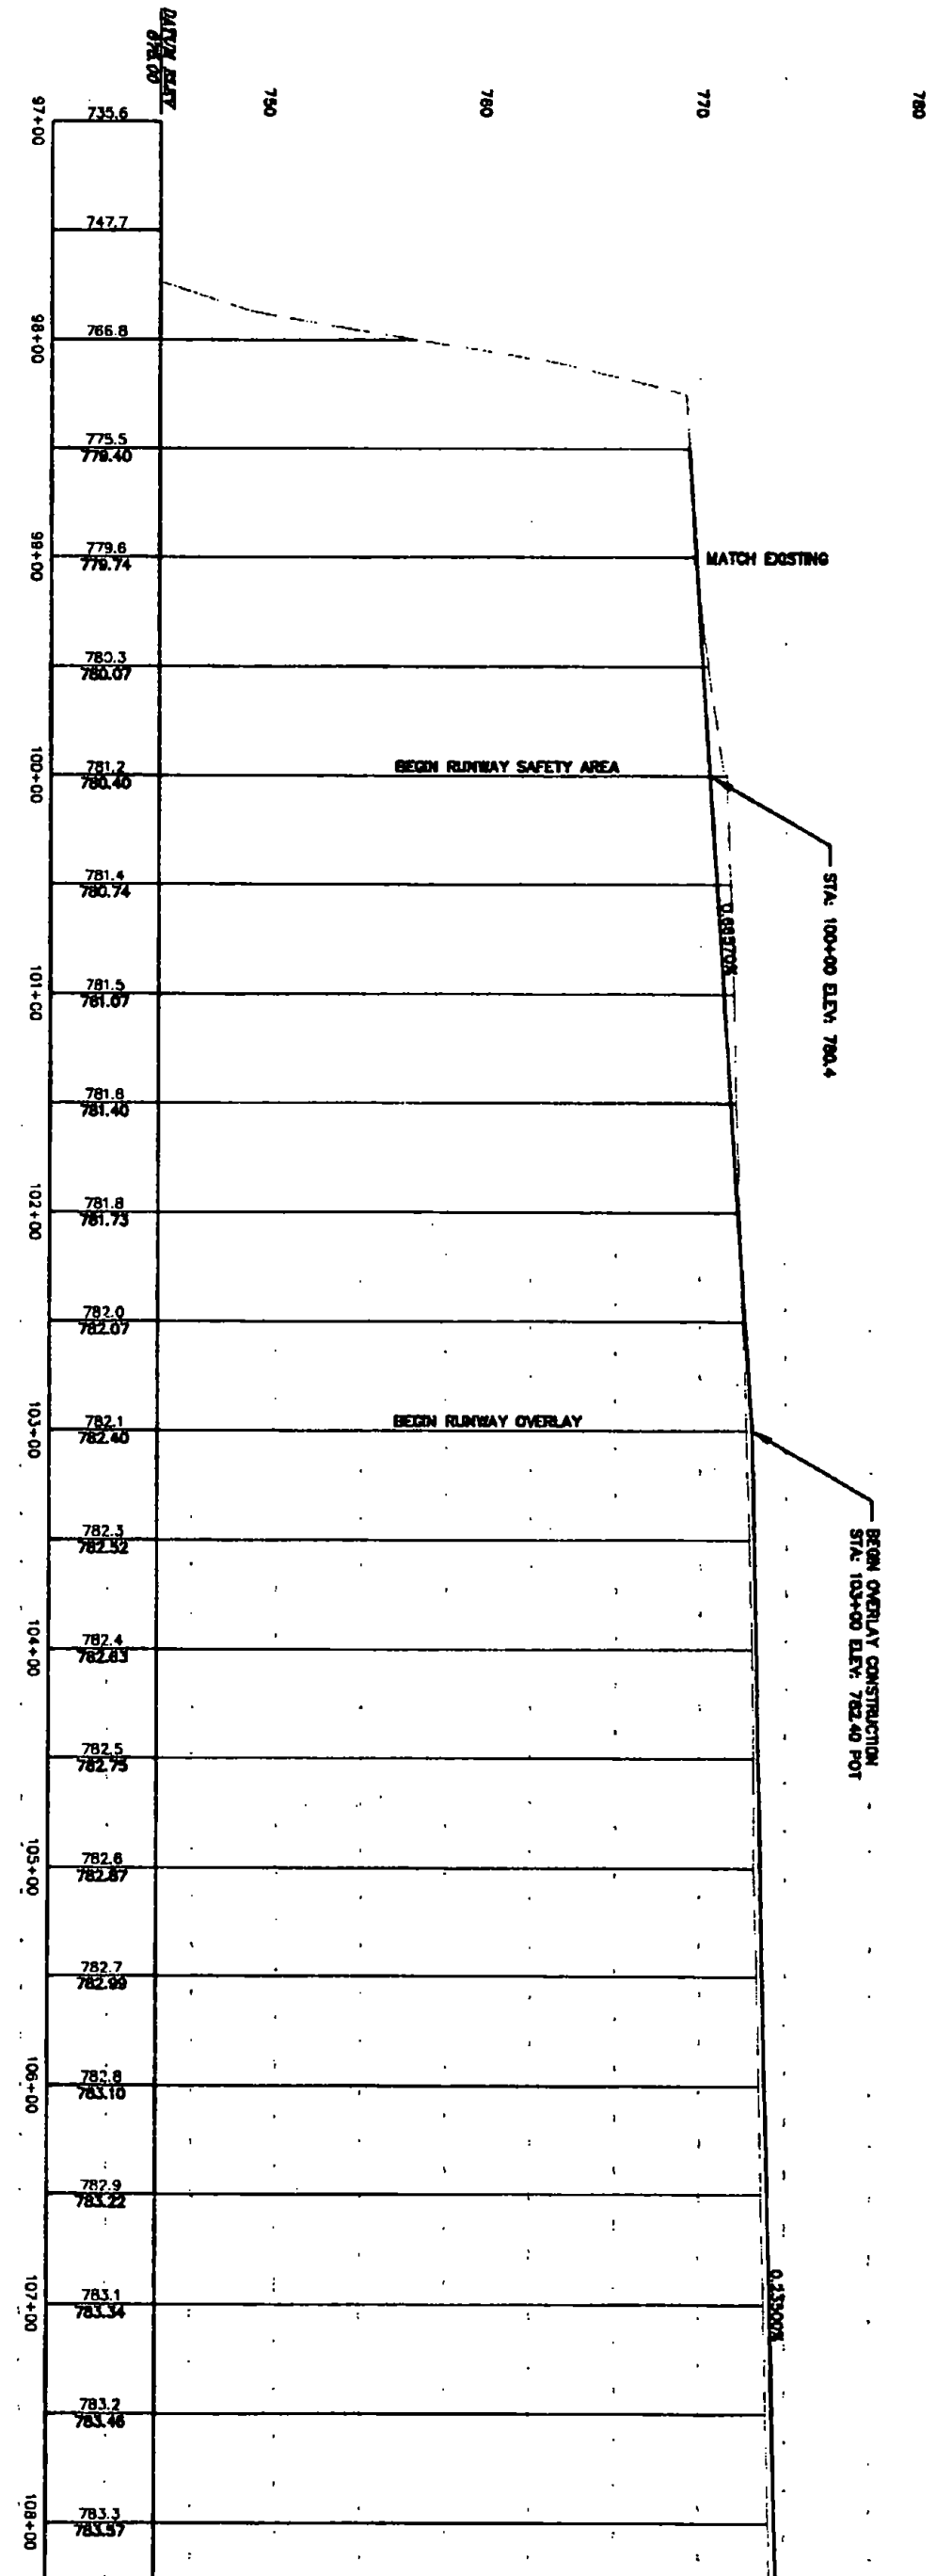

AIP 3-50-001-3-11

	Designed by: G. F. WOOD 3/87	RUTLAND STATE AIRPORT CLARENDON, VERMONT RUNWAY 1-19 PROFILE	
	Drawn by: W. MICHAEL 3/87		
	Checked by: G. F. WOOD 3/87		
	Approved by: W. MICHAEL 3/87		
3 MARCUS BOULEVARD ALBANY, NEW YORK		REV. DATE DESCRIPTION Job No. 14000 File No. 14000/0010	