


RUNWAY 1-19 PROFILE
STA 122+00 TO 136+00

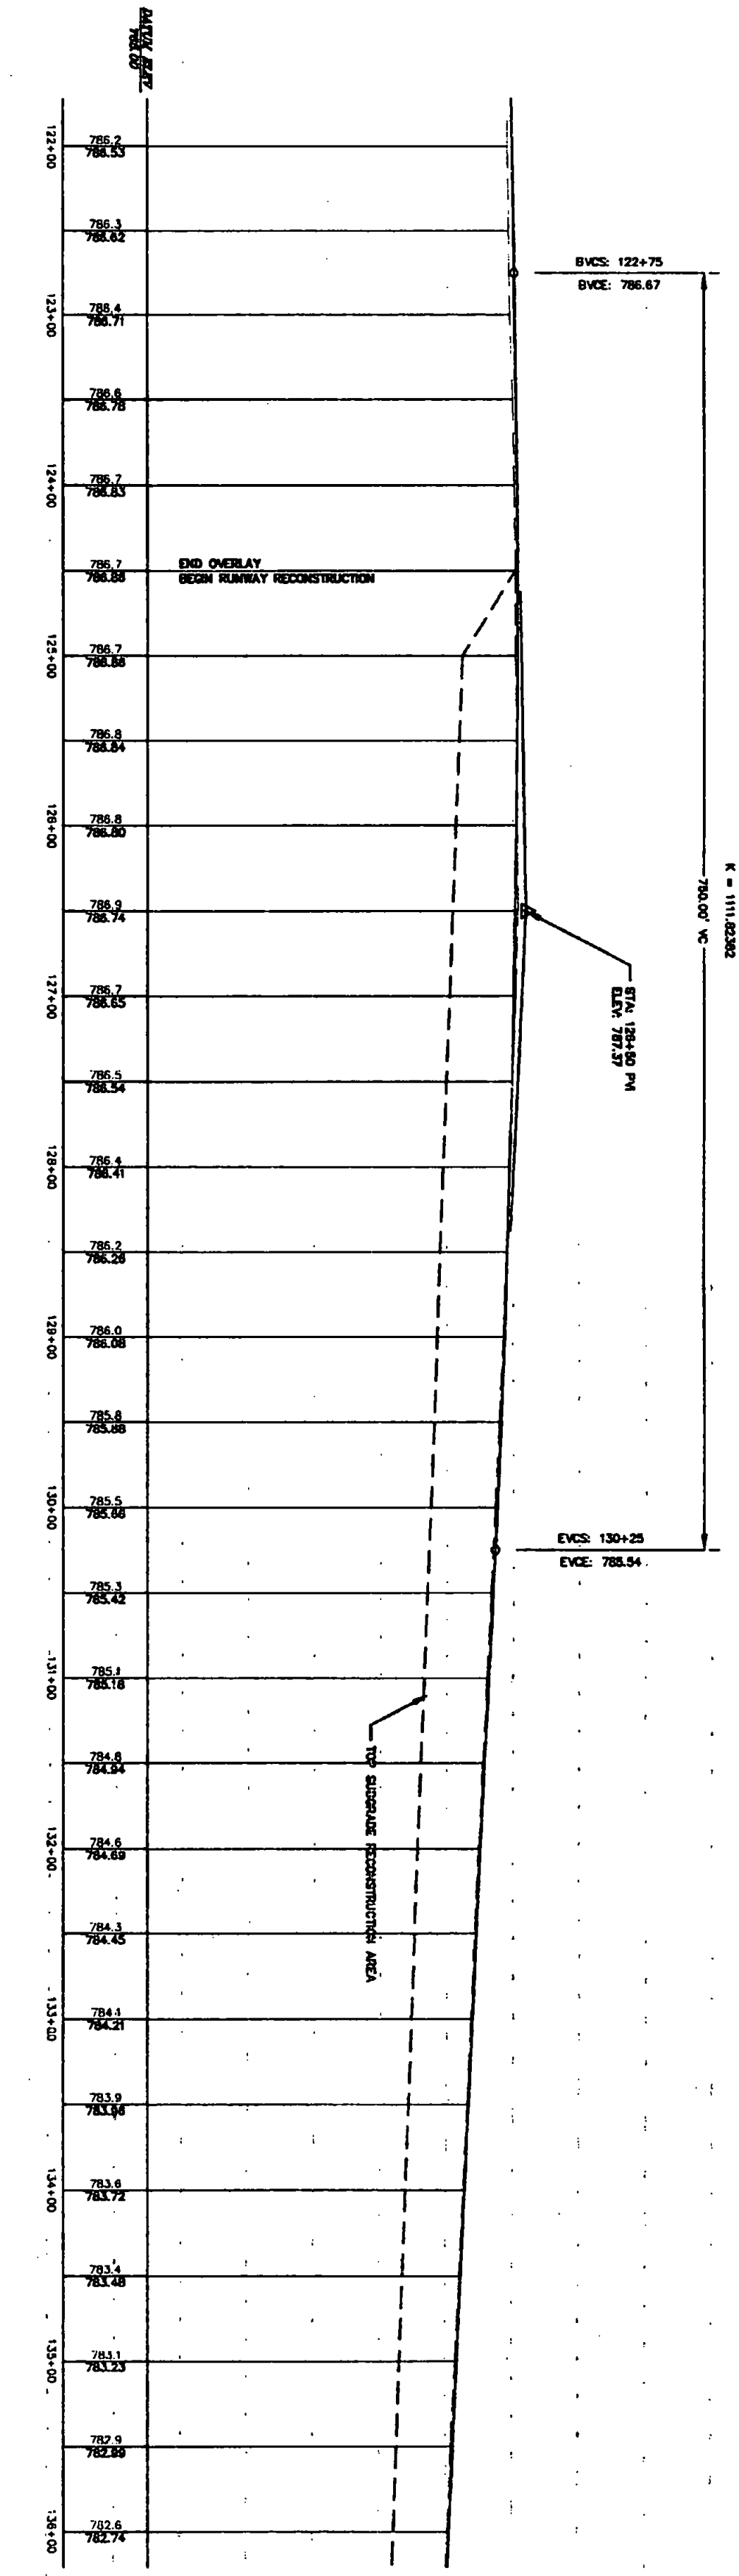

VERTICAL CURVE DATA
 PVI STA = 127+50
 HIGHEST POINT STA = 127+50
 ELEV. = 790.00
 L = 110.00 FT
 GRADE % = 0.00

Sheet No. 11 of 11 Date: 5/2/97 Scale: 1" = 40'	Designed by: CGB 5/2/97	URS Greiner, Inc. 3 MARCUS BOULEVARD ALBANY, NEW YORK	RUTLAND STATE AIRPORT CLARENDON, VERMONT RUNWAY 1-19 PROFILE	REV. DATE DESCRIPTION Job No. 920210 File No. 1740270200	
	Drawn by: M. MICHALA 5/2/97				
	Checked by: C. D'AMICO 5/2/97				
	Approved by: S. CHAMBERS 5/2/97				