



TAXIWAY 'D' PROFILE  
STA 500+00 TO 507+00

AIP 3-50-0015-11

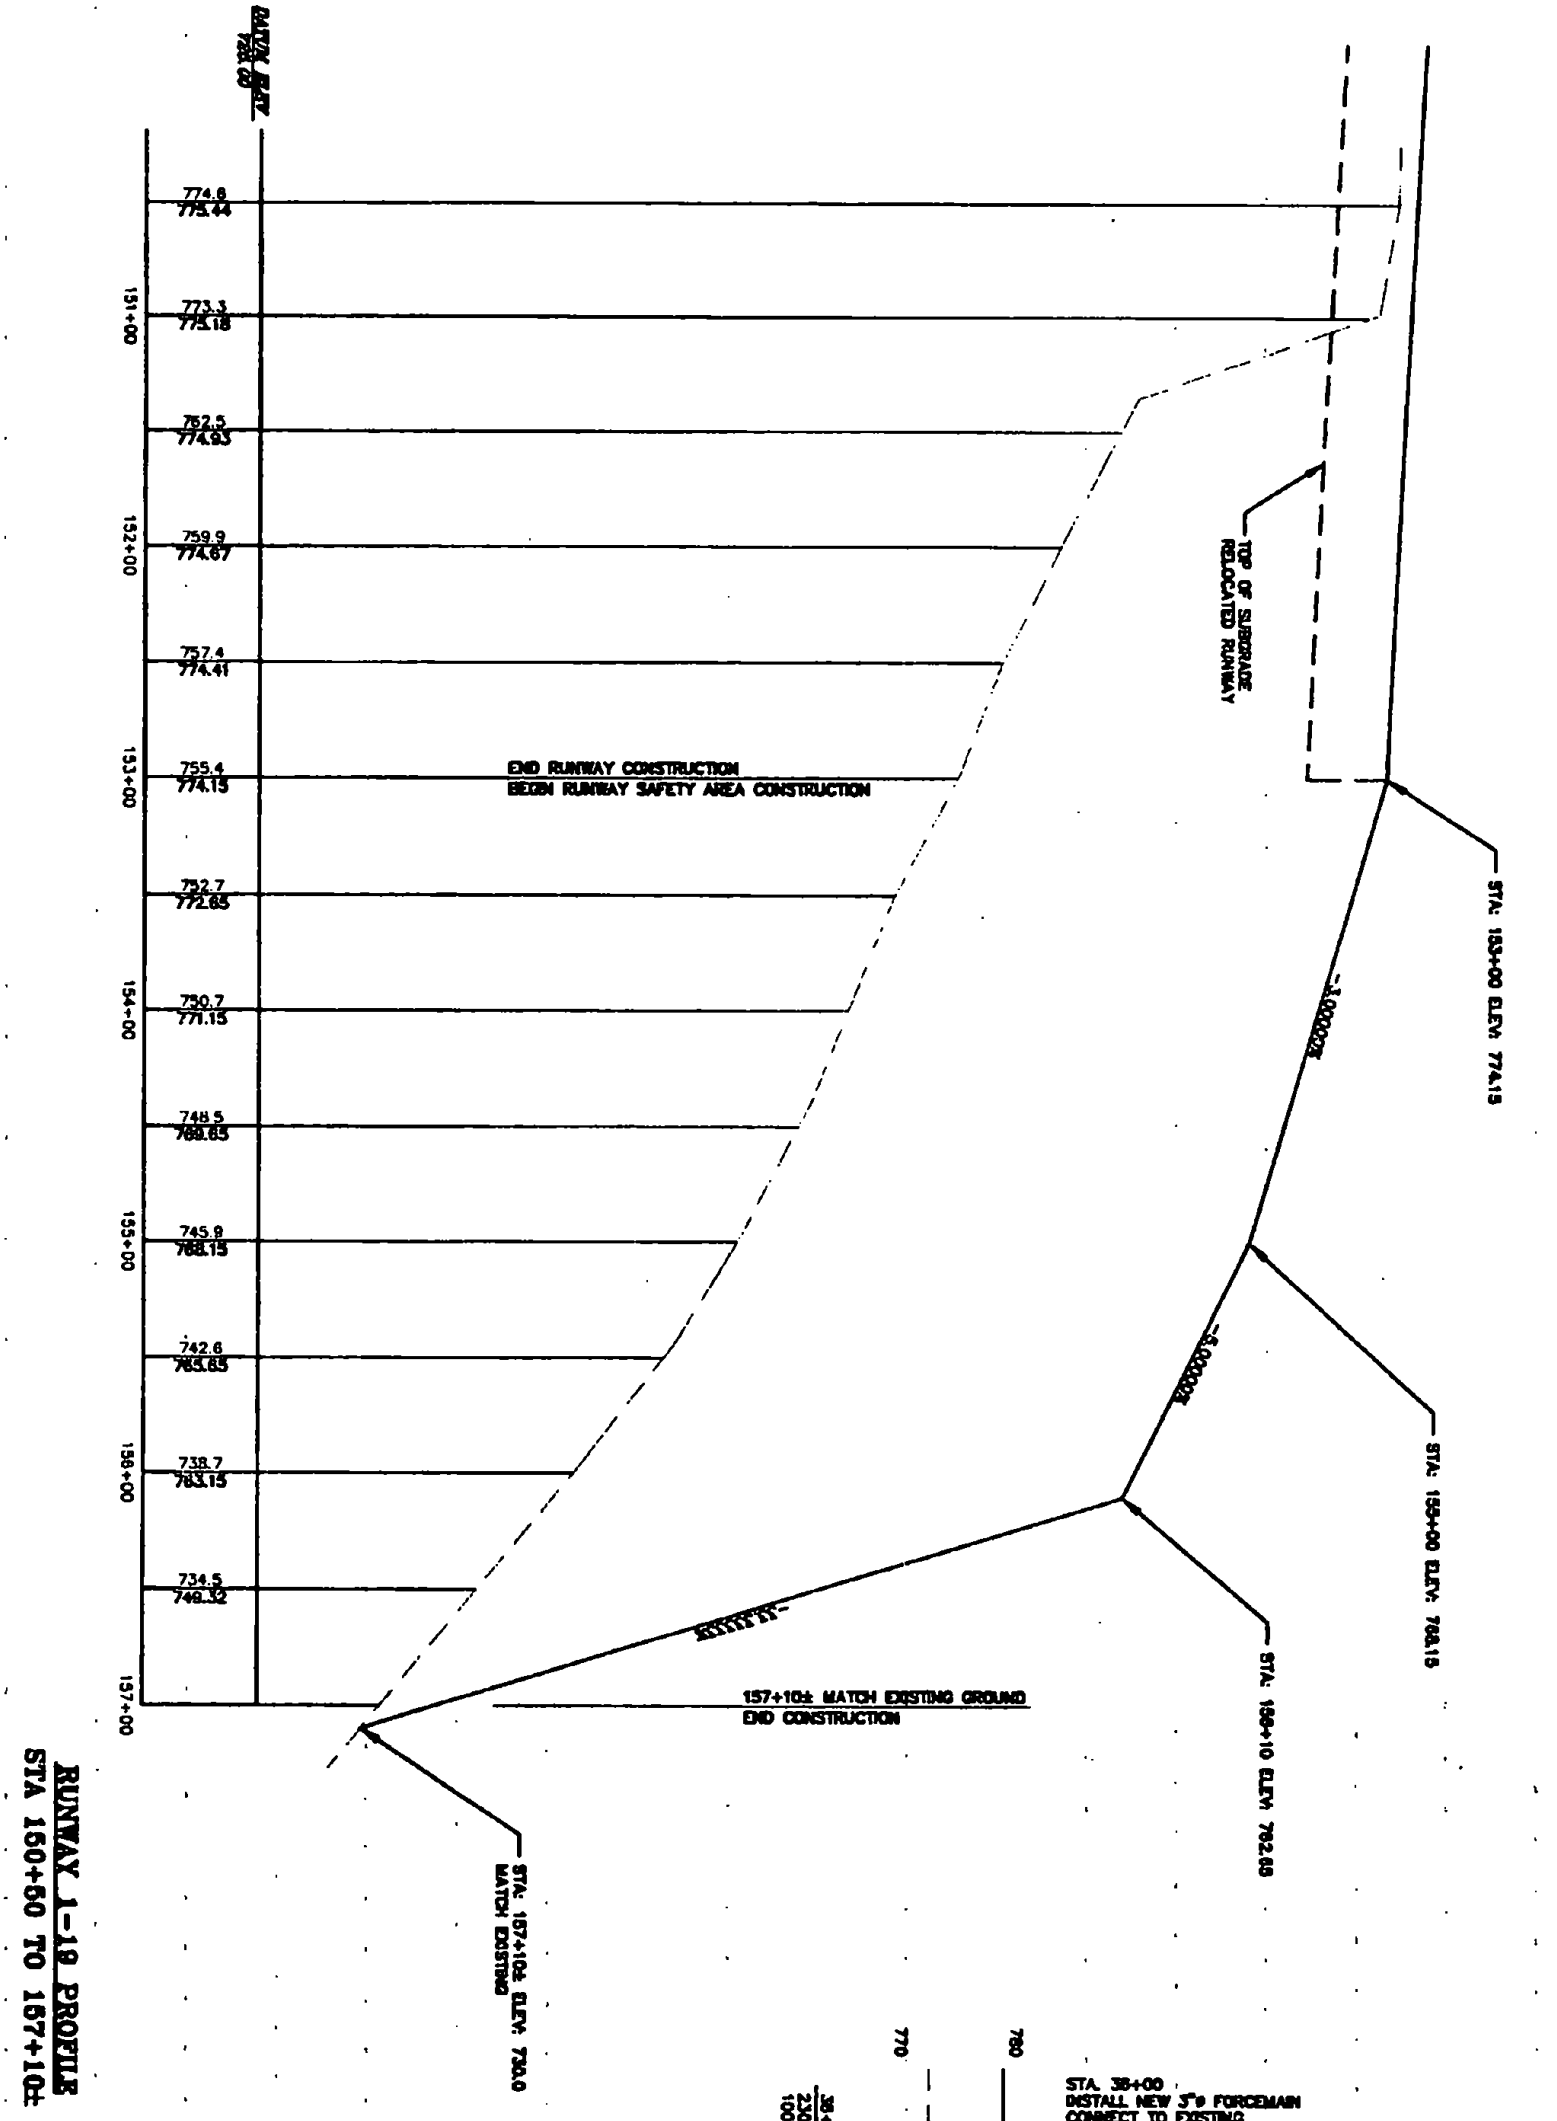

RUNWAY 1-19 PROFILE  
STA 150+00 TO 157+10

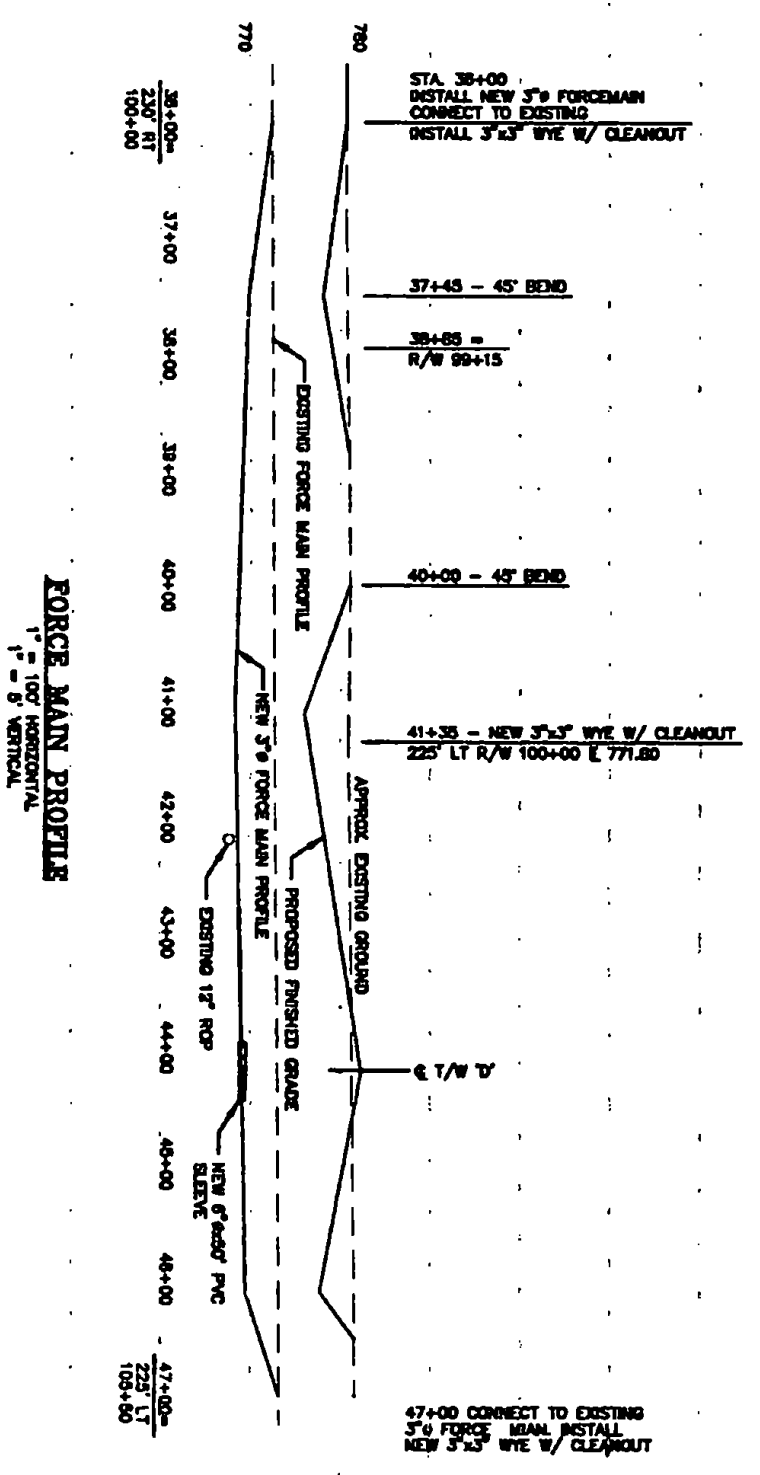

FORCE MAIN PROFILE  
1' = 8' VERTICAL

Drawn by: M. SCALIA 3/77	Checked by: G. V'ARCO 5/1/77	Approved by: M. CHAMBERLAIN 5/5/77		RUTLAND STATE AIRPORT CLARENDON, VERMONT  RUNWAY 1-19 PROFILE	
Sheet No. 2	Date: 5/1/77	Scale: 1" = 8' VERTICAL	URS Greiner, Inc. 3 MARCUS BOULEVARD ALBANY, NEW YORK	REV. DATE DESCRIPTION	Job No. 000000 File No. 1542000000