


MATCH LINE SHEET 14

LEGEND	
	3 1/4" OVERLAY
	CONSTRUCT NEW PAVEMENT SECTION
	APPROXIMATE LIMITS OF PAVEMENT
	CONCRETE CURB
	MANHOLE #33
	PROP. INLET #33
	EXISTING MANHOLE LIGHTS (TO BE REMOVED)
	SEE LIGHTING PLANS "T" TO FORM NEW
	SHOW CUT EXISTING PAV'T TO FORM NEW
	ROADS

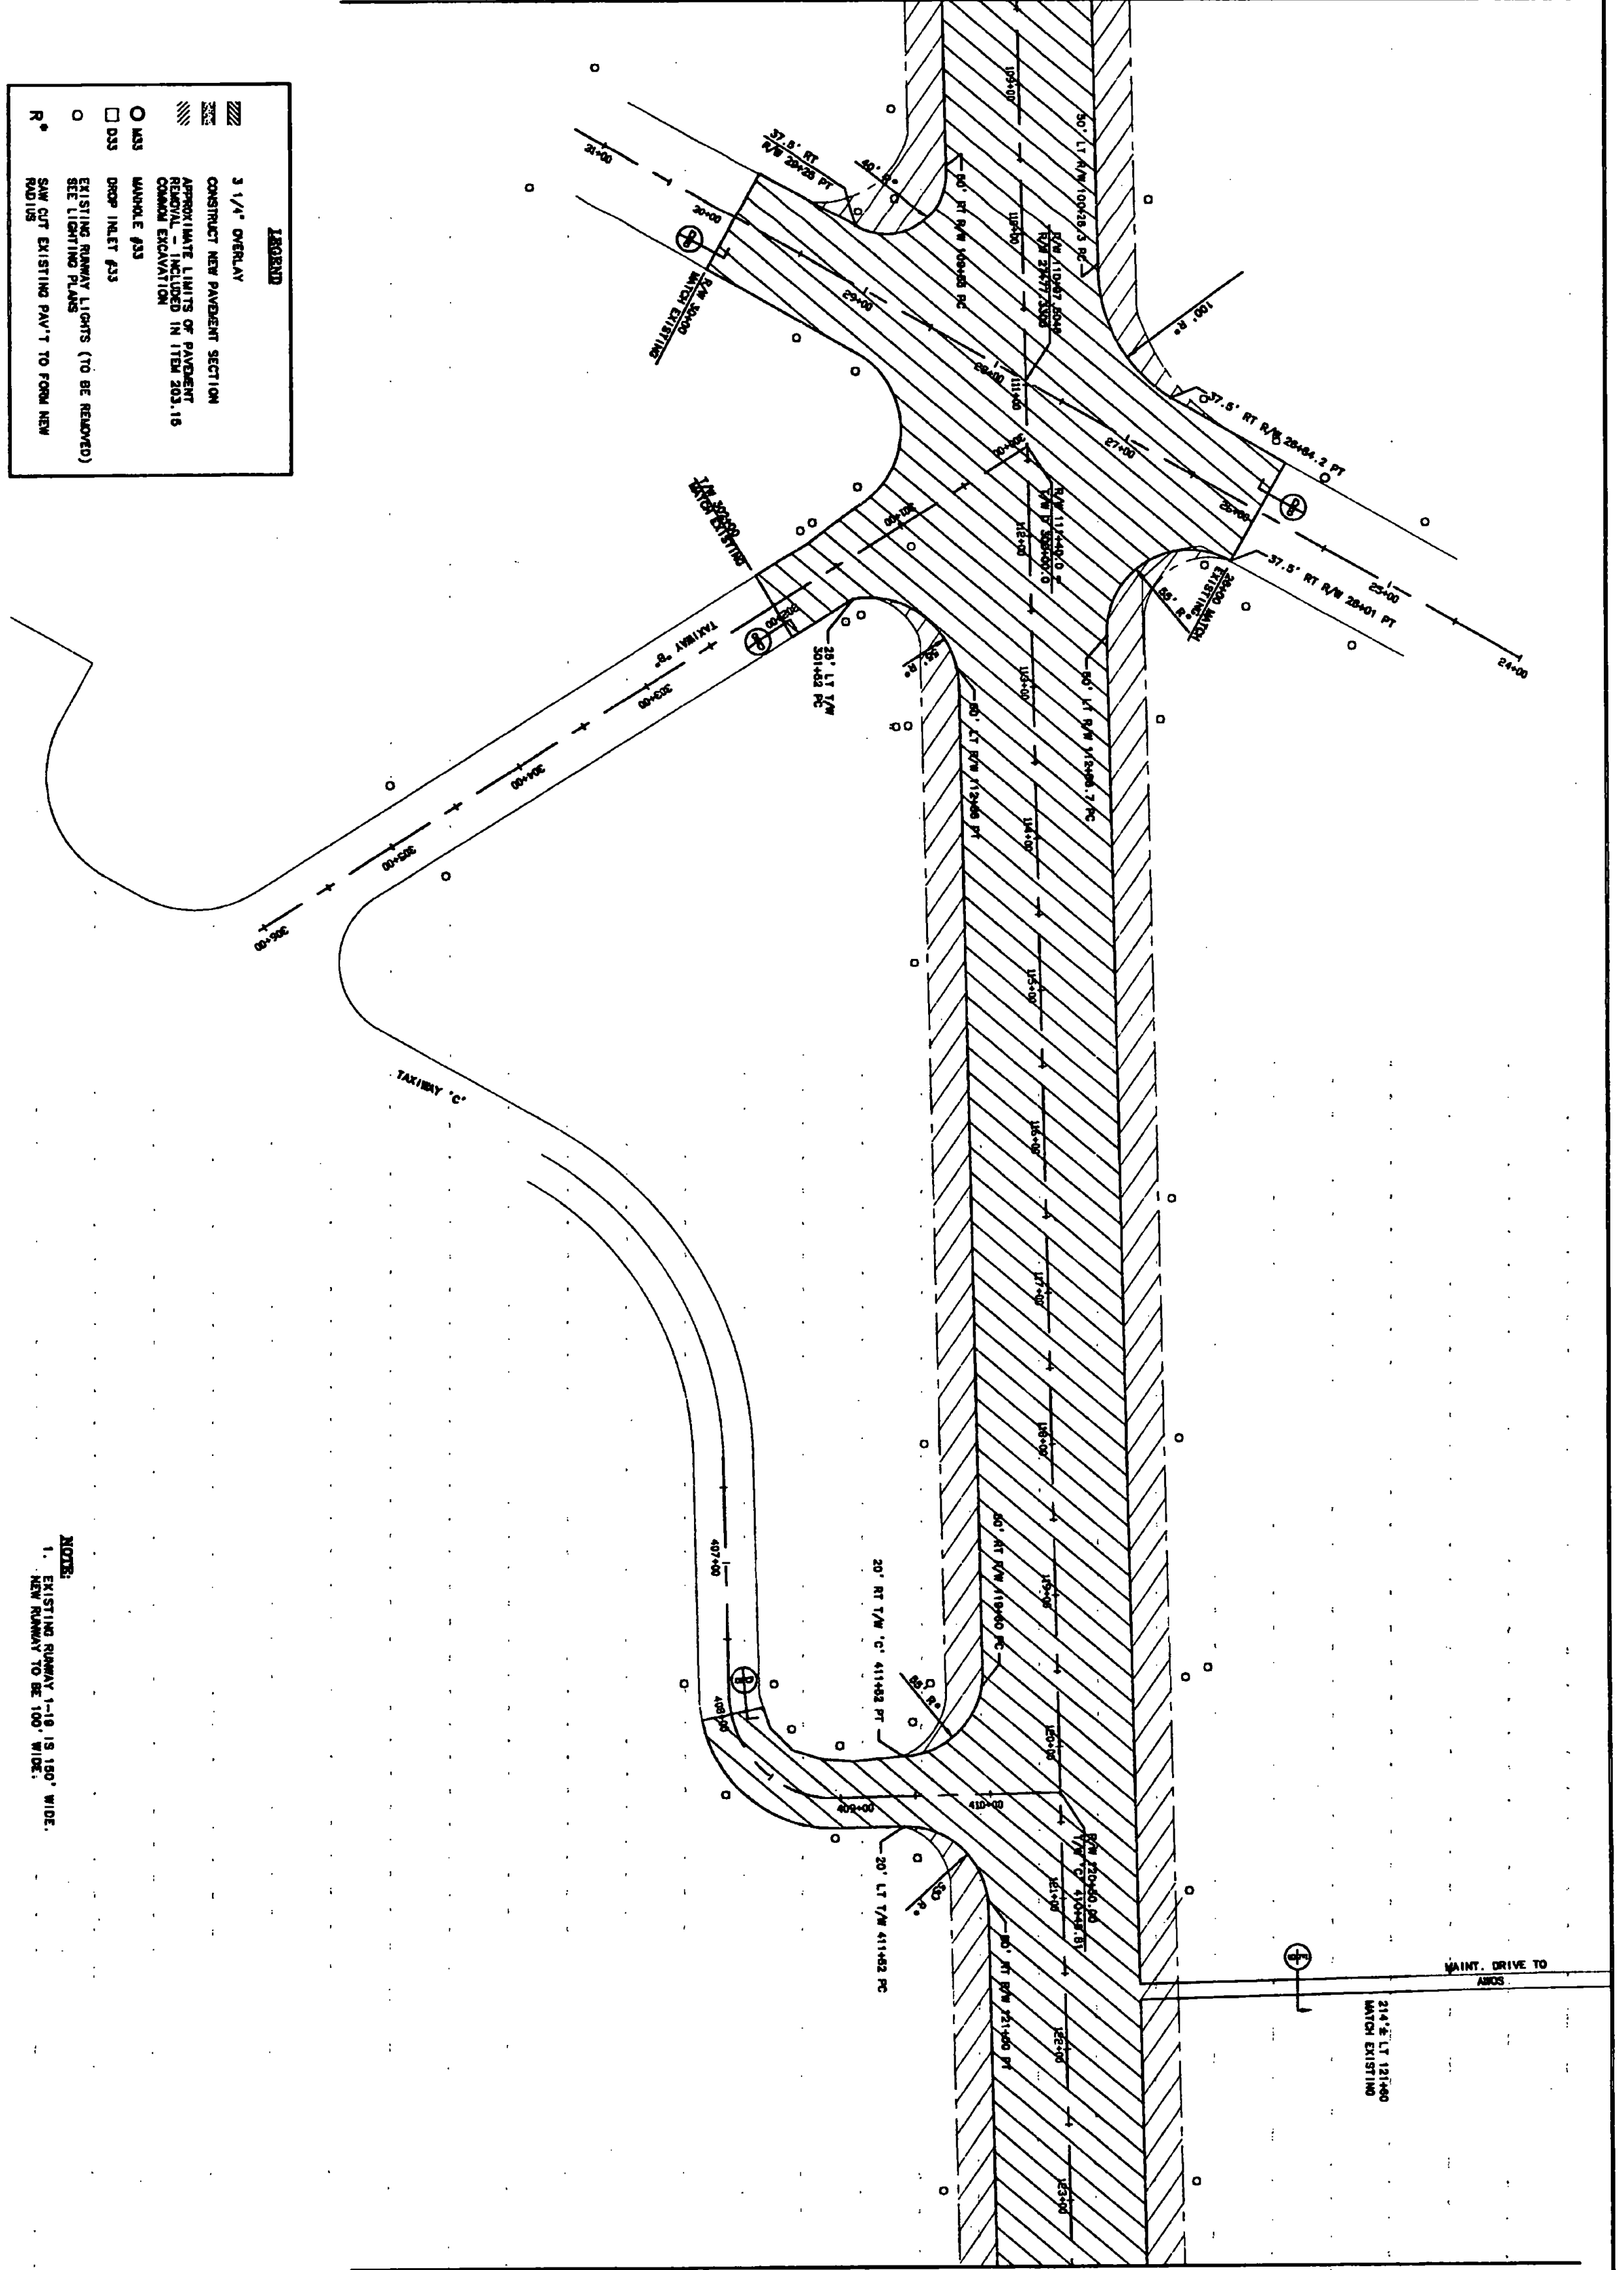

MATCH LINE SHEET 16

NOTES:  
1. EXISTING MANHOLE #118 IS 180" WIDE.  
MANHOLE #118 IS TO BE REMOVED.

Alp 3-50-0013-11

 <b>URS Greiner, Inc.</b> 3 MARCUS BOULEVARD ALBANY, NEW YORK	RUTLAND STATE AIRPORT CLARNDON, VERMONT	
	PAVING PLAN & GEOMETRIC LAYOUT	
Designed by: C. O'NEILL Checked by: C. O'NEILL Approved by: M. CHAPMAN	Date: 2/97 Date: 2/97 Date: 2/97	Job No. 48212.02 Title No. 11VTR12W-P014