


MATCH LINE SHEET 15

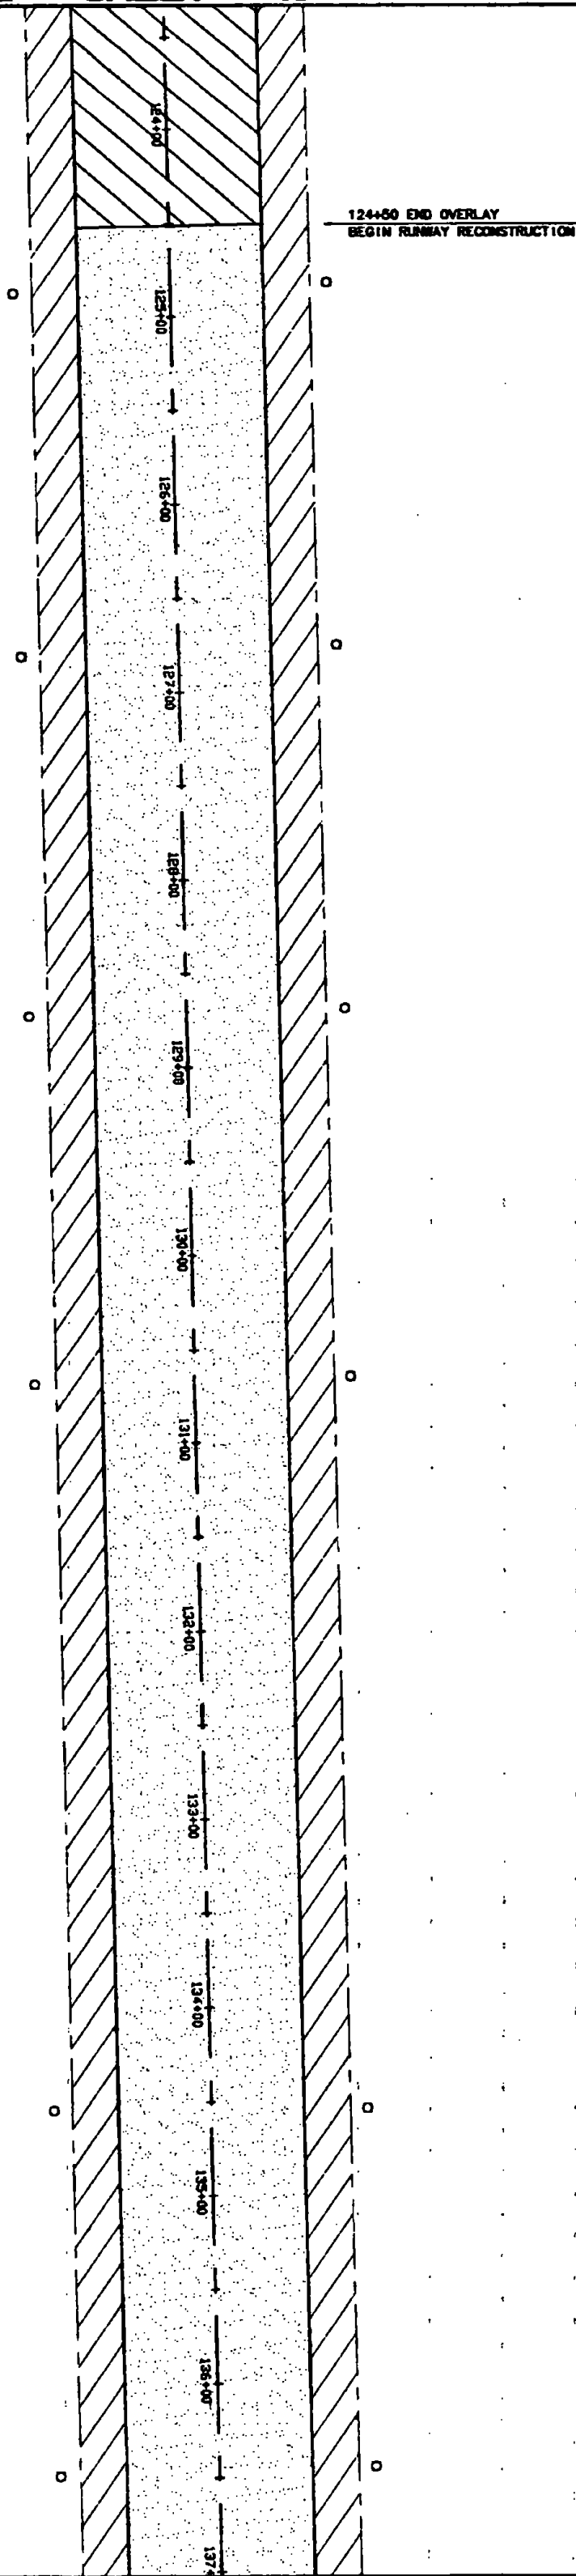

MATCH LINE SHEET 17

LEGEND	
	3 1/4" OVERLAY
	CONTRACT NEW PAVEMENT SECTION
	APPROPRIATE LAYOUT OF PAVEMENT
	REMOVE EXISTING PAVEMENT
	MANHOLE P23
	SHOW HOLE P23
	EXISTING MANHOLE LIGHTS (TO BE REMOVED)
	REMOVE EXISTING MANHOLE LIGHTS

NOTES:
1. EXISTING ROADWAY 1-18 IS 180' WIDE.
NEW ROADWAY TO BE 100' WIDE.

ALP 3-50-0015-11

 3 MARCUS BOULEVARD ALBANY, NEW YORK	Designed by: C. J. MCGO Date: 2/97	RUTLAND STATE AIRPORT CLARENDON, VERMONT PAVING PLAN & GEOMETRIC LAYOUT	
	Drawn by: M. METCALA Date: 2/97		
	Checked by: C. J. MCGO Date: 2/97		
	Approved by: M. CHURCHILL Date: 2/97		
Job No. 100121.00 File No. 1-V012720-0001	REV. DATE DESCRIPTION	Job No. 100121.00 File No. 1-V012720-0001	