

AIP 3-50-0015-11


Drawn by: S. W. WILSON 3/77	Checked by: S. W. WILSON 5/77	Approved by: S. W. WILSON 5/77
Designated by: S. W. WILSON 2/77		
Date: 3/77		

**URS Greiner, Inc.**  
3 MARCUS BOULEVARD  
ALBANY, NEW YORK

**RUTLAND STATE AIRPORT**  
CLARENDON, VERMONT

**RUNWAY CROSS SECTIONS**

REV.	DATE	DESCRIPTION

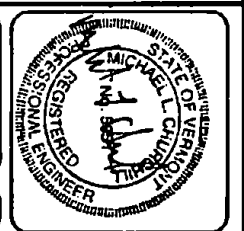

Job No. 444444  
File No. 444444-123-45