
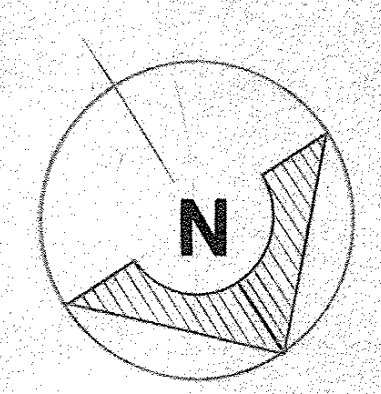


1/24
/BA G. White

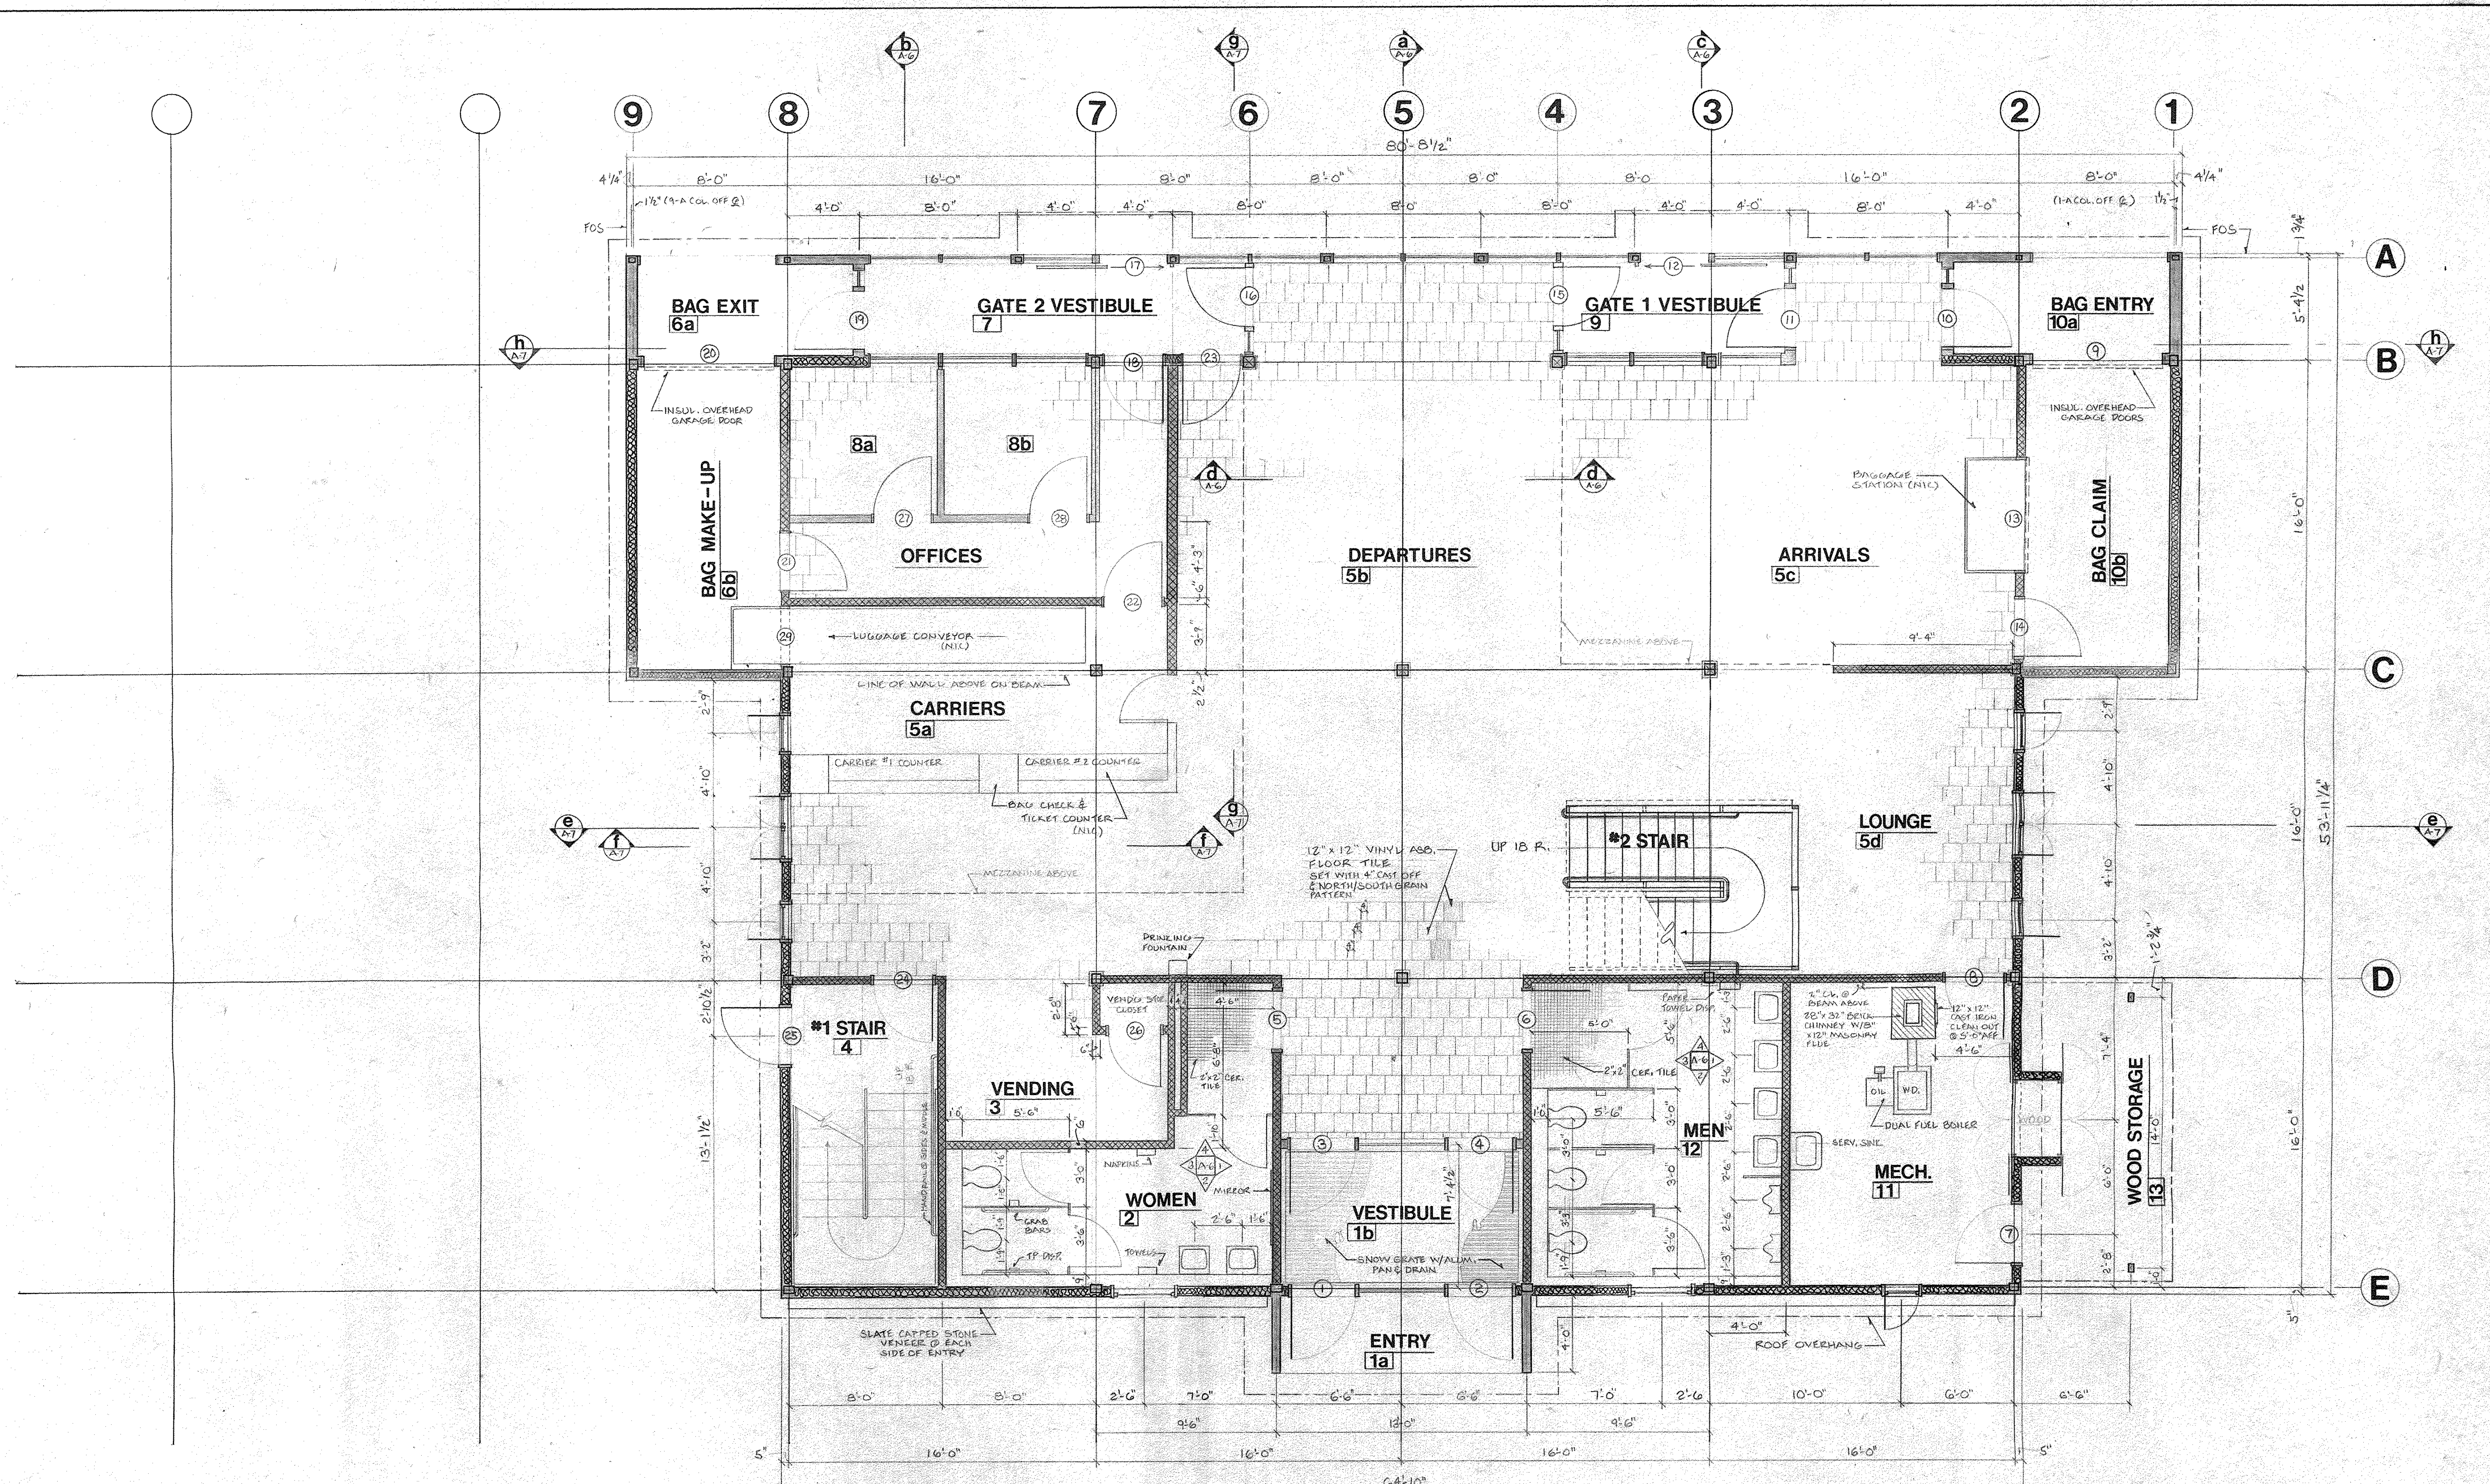

STATE OF VERMONT
DIVISION OF STATE BUILDINGS
AGENCY OF ADMINISTRATION
MONTPELIER, VERMONT

RUTLAND TERMINAL BUILDING AIR 23-2024
FIRST FLOOR PLAN
RUTLAND STATE AIRPORT
CLARENDON, VERMONT

DATE: 6/8/24	SCALE: 1/4" = 1'-0"	REVISIONS: 1/2, 1/4, 5, A, MULHERN	DWG. NO. A-2
DRAWN BY: JPO	APPROVED BY: DA FOR DSP		4 OF 19

6/10/24