
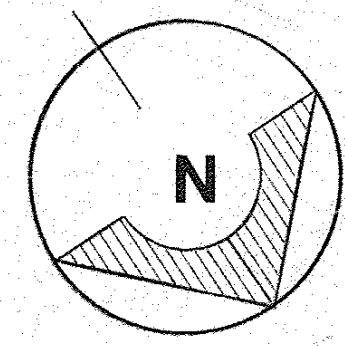


ated
1/24 for Wake

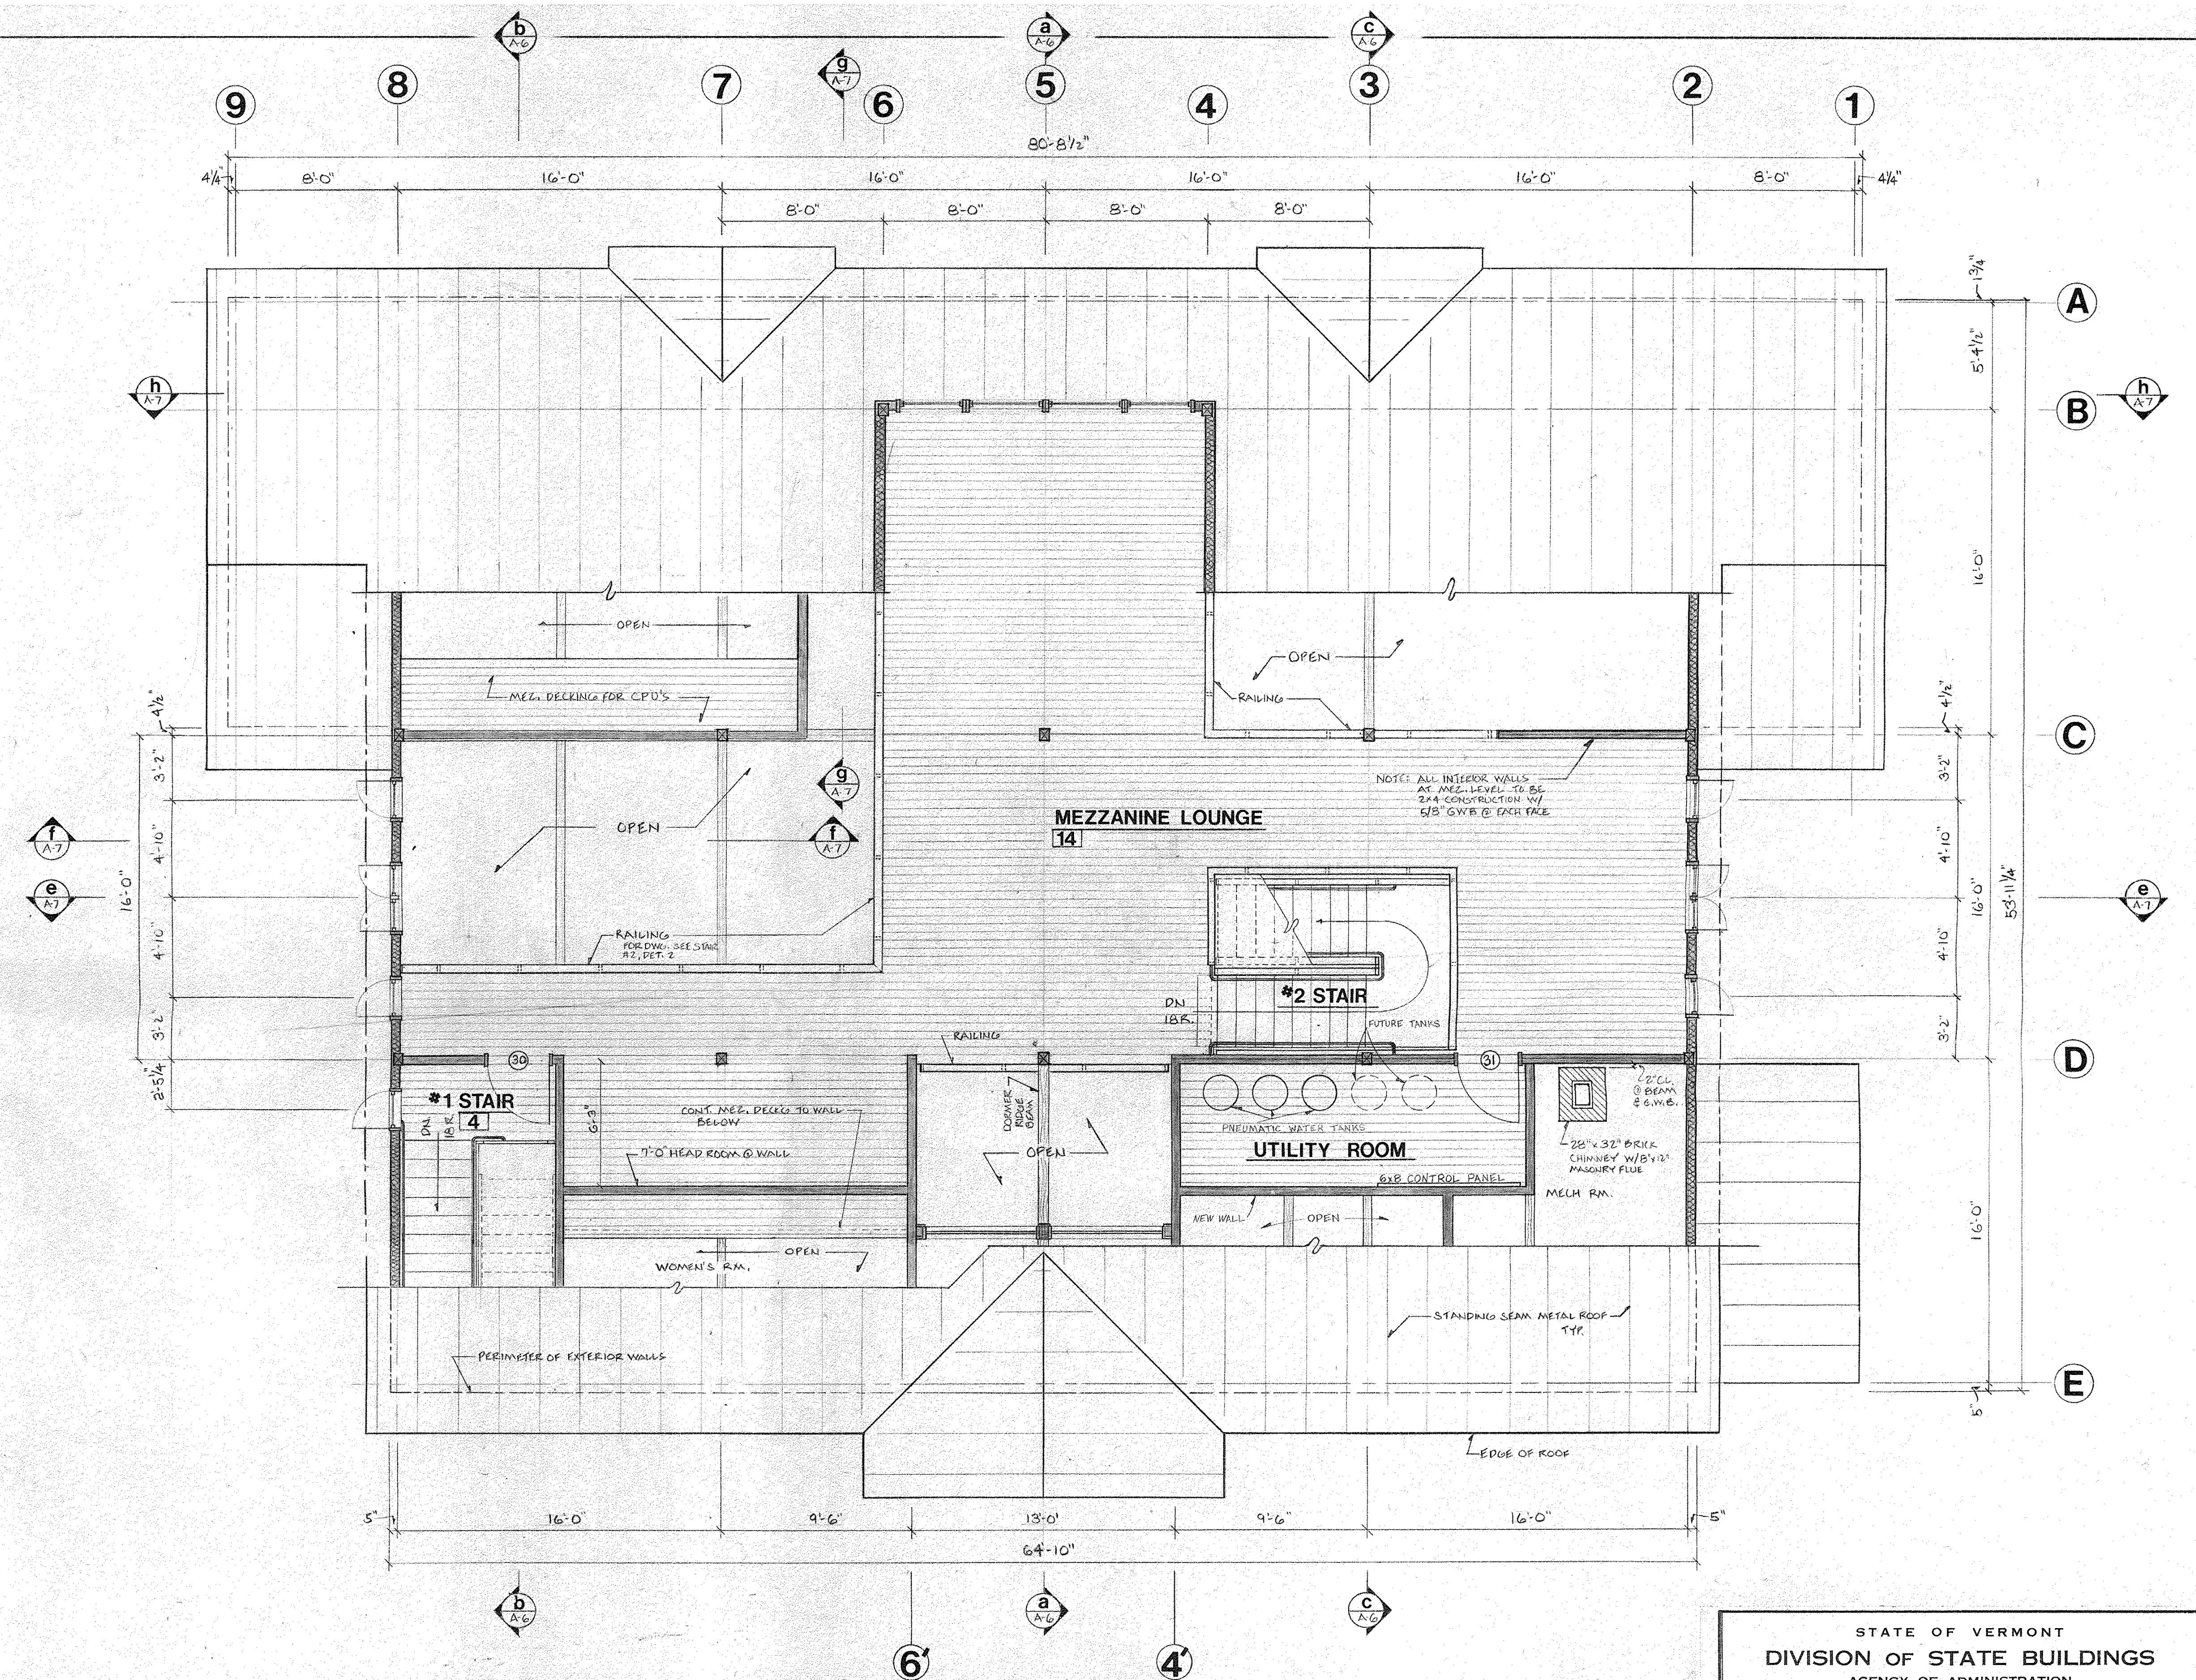

STATE OF VERMONT DIVISION OF STATE BUILDINGS AGENCY OF ADMINISTRATION MONTPELIER, VERMONT			
RUTLAND TERMINAL BUILDING AIR 23-2024 MEZZANINE PLAN RUTLAND STATE AIRPORT CLARENDON, VERMONT			
DATE: 6-8-84	SCALE: 1/4" = 1'-0"	REVISIONS: 01/21/84 SAMUELHERN	DWG. NO. A-3
DRAWN BY: JPO	APPROVED BY: RA FOR DGB		6 OF 19

8/10/84