


NOTE: 1. TOP OF ALL BEAMS AT 10'-2 3/8" EXCEPT AS NOTED AT ENTRANCE (13'-0" SPAN)
 *2 FOR CONNECTIONS (C) ETC. SEE STRUCTURAL CONNECTION DETAIL DWGS. SERIES SC-1 TO SC-21. 1/2" SCHEDULE OF BEAM TO BEAM OR COL CONNECTION FOR (A) (B) (C) ... ETC. DESIGNATED *3 STANDARD CORRECTIONS I.E.: 1212 HT. BBL, HST 2-12, 1212HL, 1212L, ETC. AS INDICATED BY THE SIMPSON CO. - "STRONG-TIE"

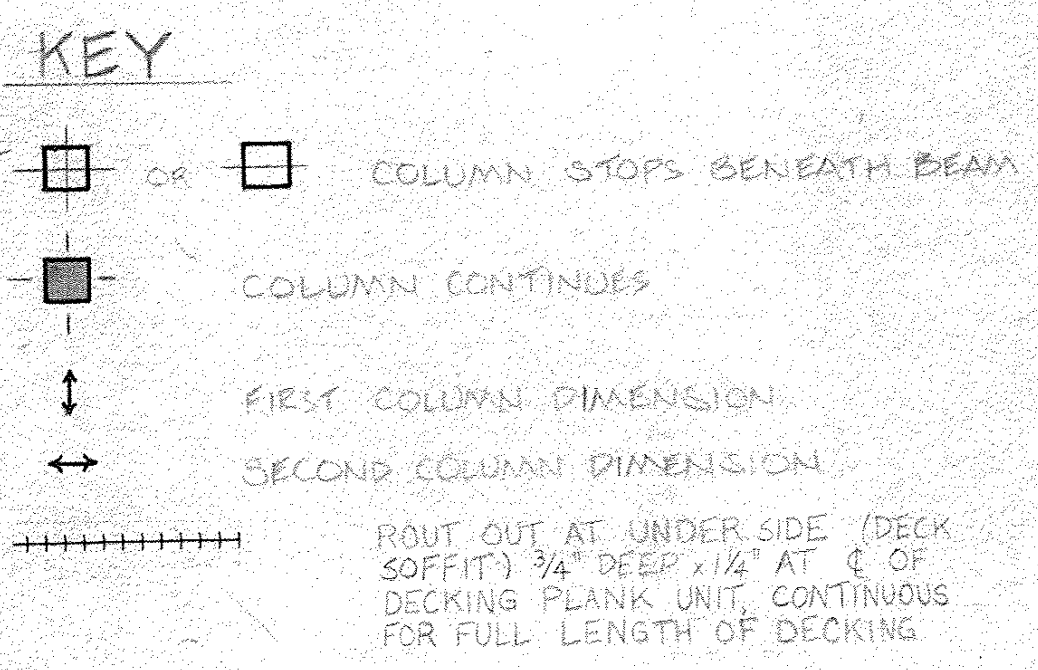

STATE OF VERMONT
 DIVISION OF STATE BUILDINGS
 AGENCY OF ADMINISTRATION
 MONTPELIER, VERMONT

RUTLAND TERMINAL BUILDING AIR 23-2024
MEZZANINE FRAMING
 RUTLAND STATE AIRPORT
 CLARENDON, VERMONT

DATE: 6-8-84	SCALE: 1/4" = 1'-0"	REVISIONS: 7/26/84 - J.A. MULHERN	DWG. NO. SF-1
DRAWN BY: JPD	APPROVED BY: D. F. O. S. E.	11 OF 19	

810184