


DATE	PLANT	NO.	NO.
NO.	NO.	NO.	NO.
NO.	NO.	NO.	NO.

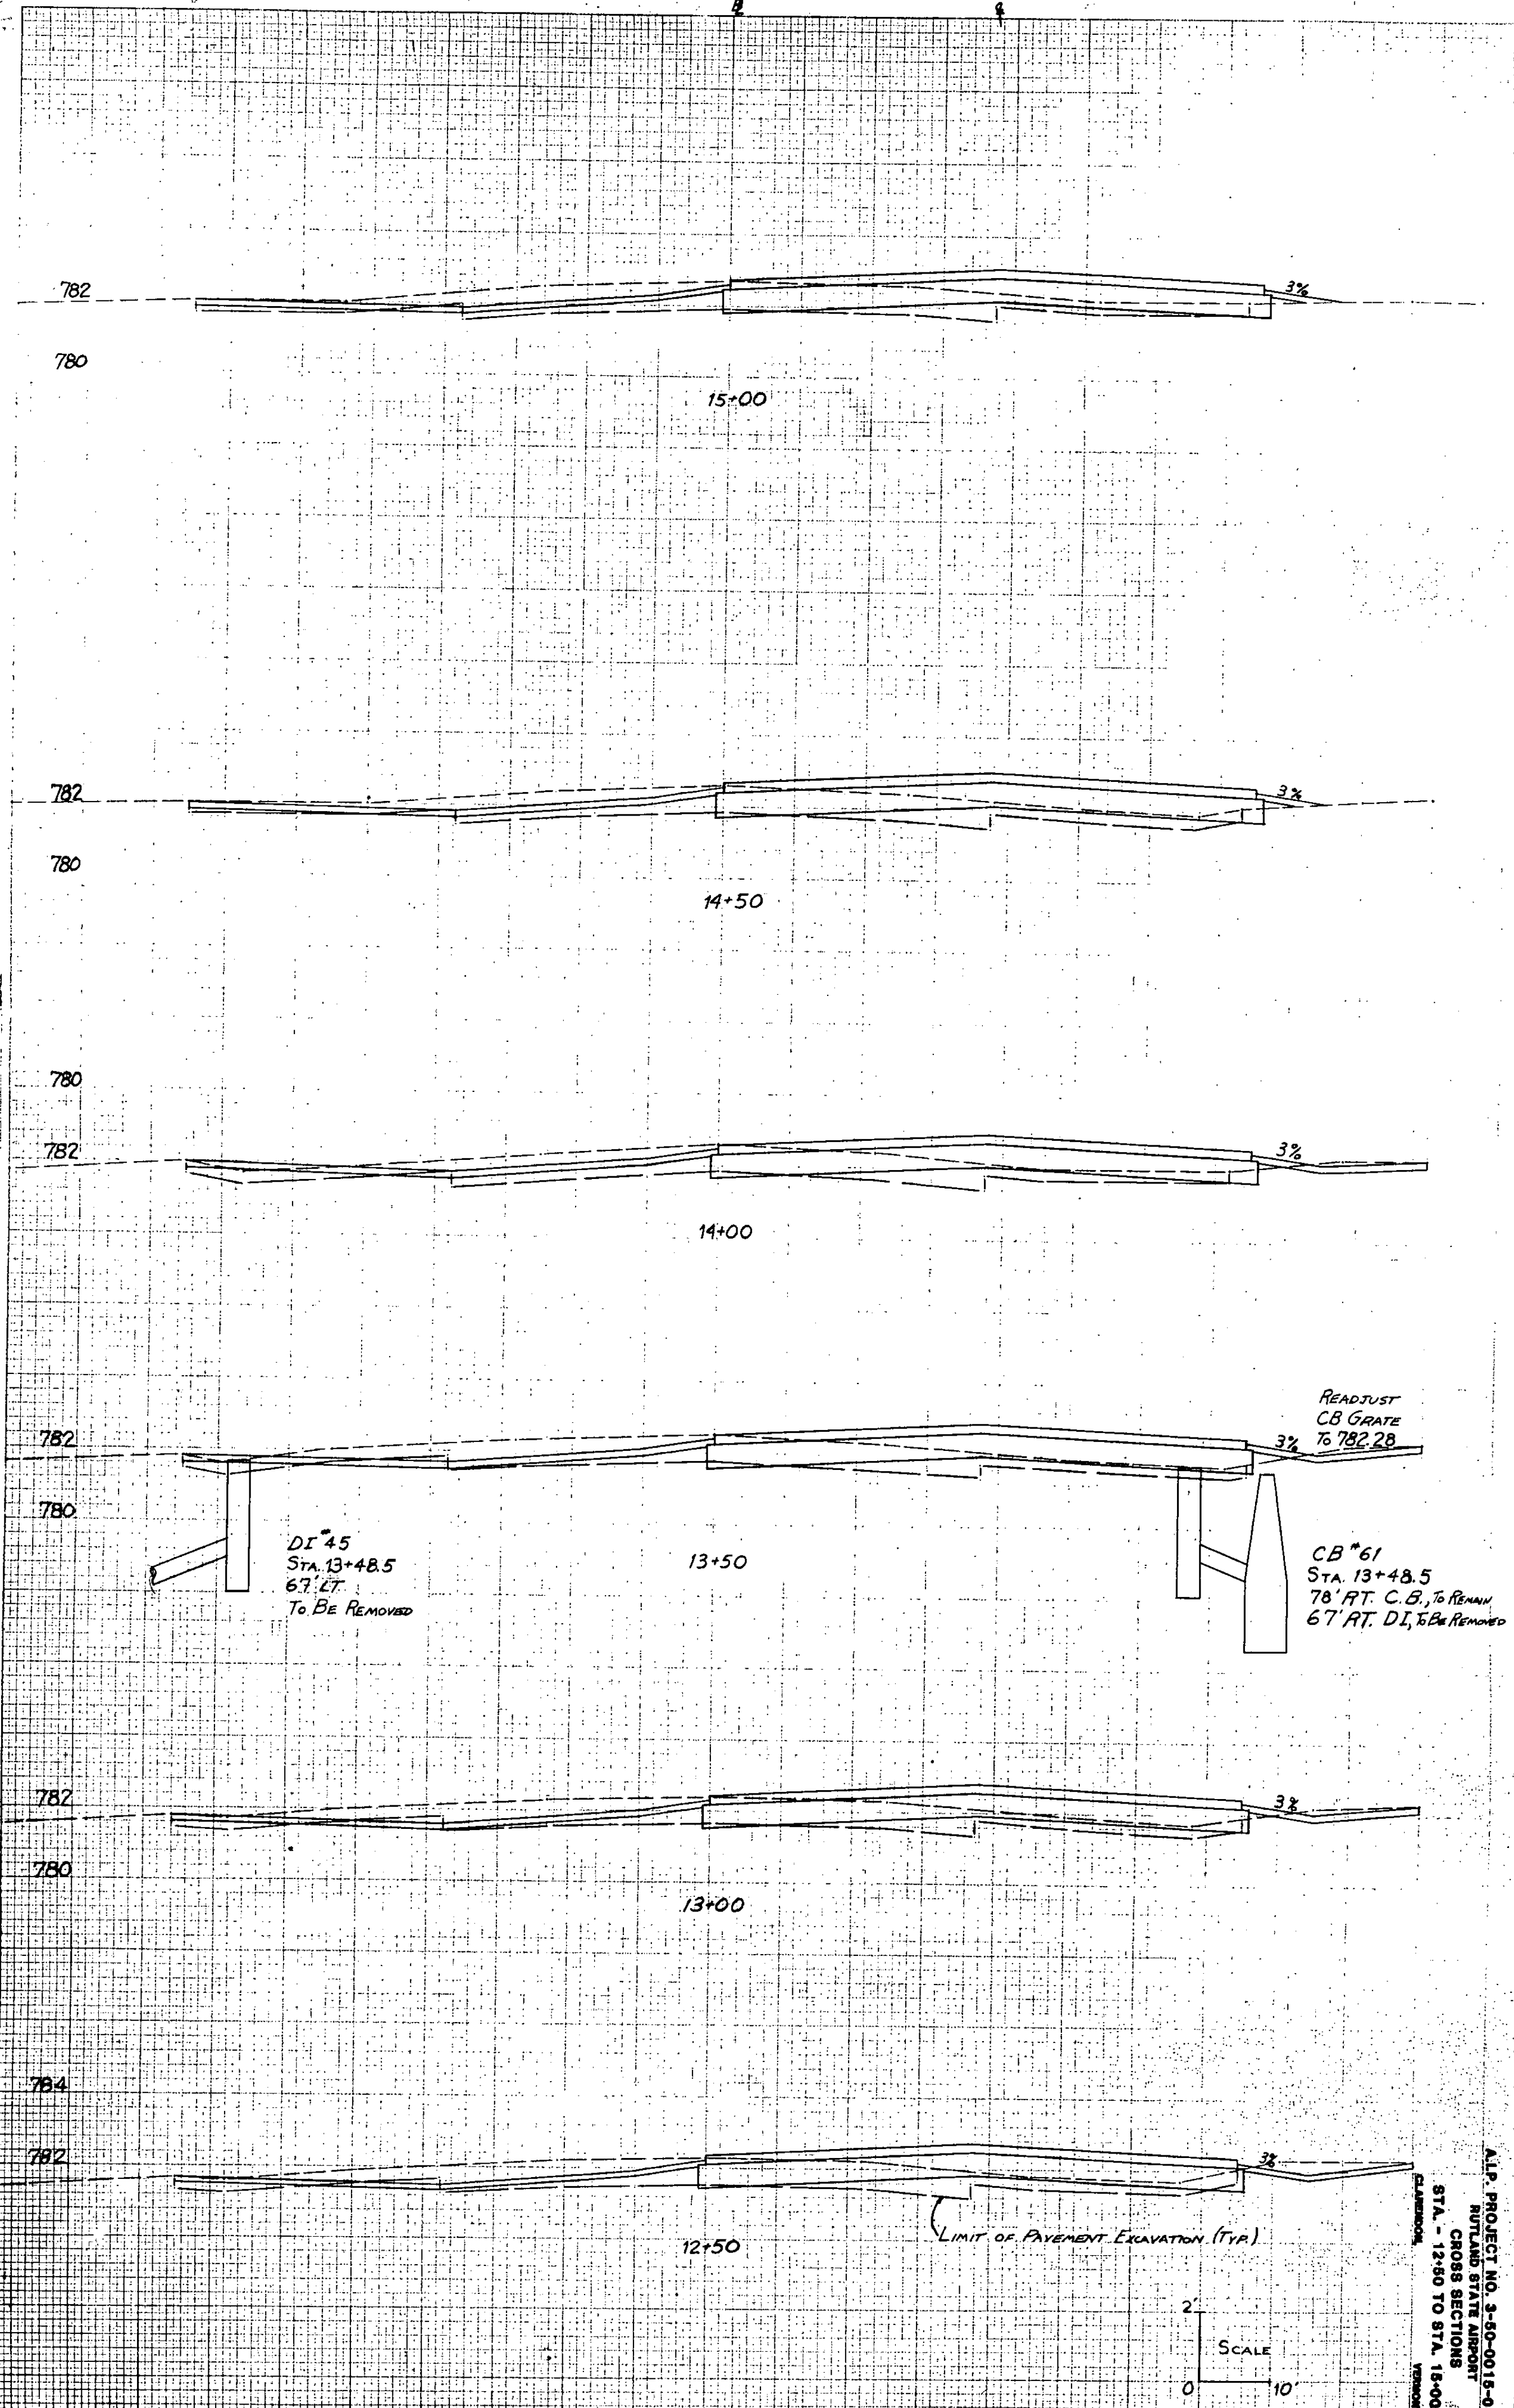


DI 45
STA. 13+48.5
67' RT.
TO BE REMOVED

CB #61
STA. 13+48.5
78' RT. C.B., TO REMAIN
67' RT. DI, TO BE REMOVED

READJUST
CB GRATE
TO 782.28

LIMIT OF PAYMENT EXCAVATION (TYR)

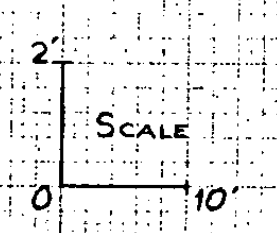

ALP PROJECT NO. 3-50-015-94
MONTANA STATE AIRPORT
CROSS SECTIONS
STA. 12+50 TO STA. 15+00

FIELD CHECKED BY: [Signature]