


NO.	DATE	BY	REVISION

NO.	DATE	BY	REVISION

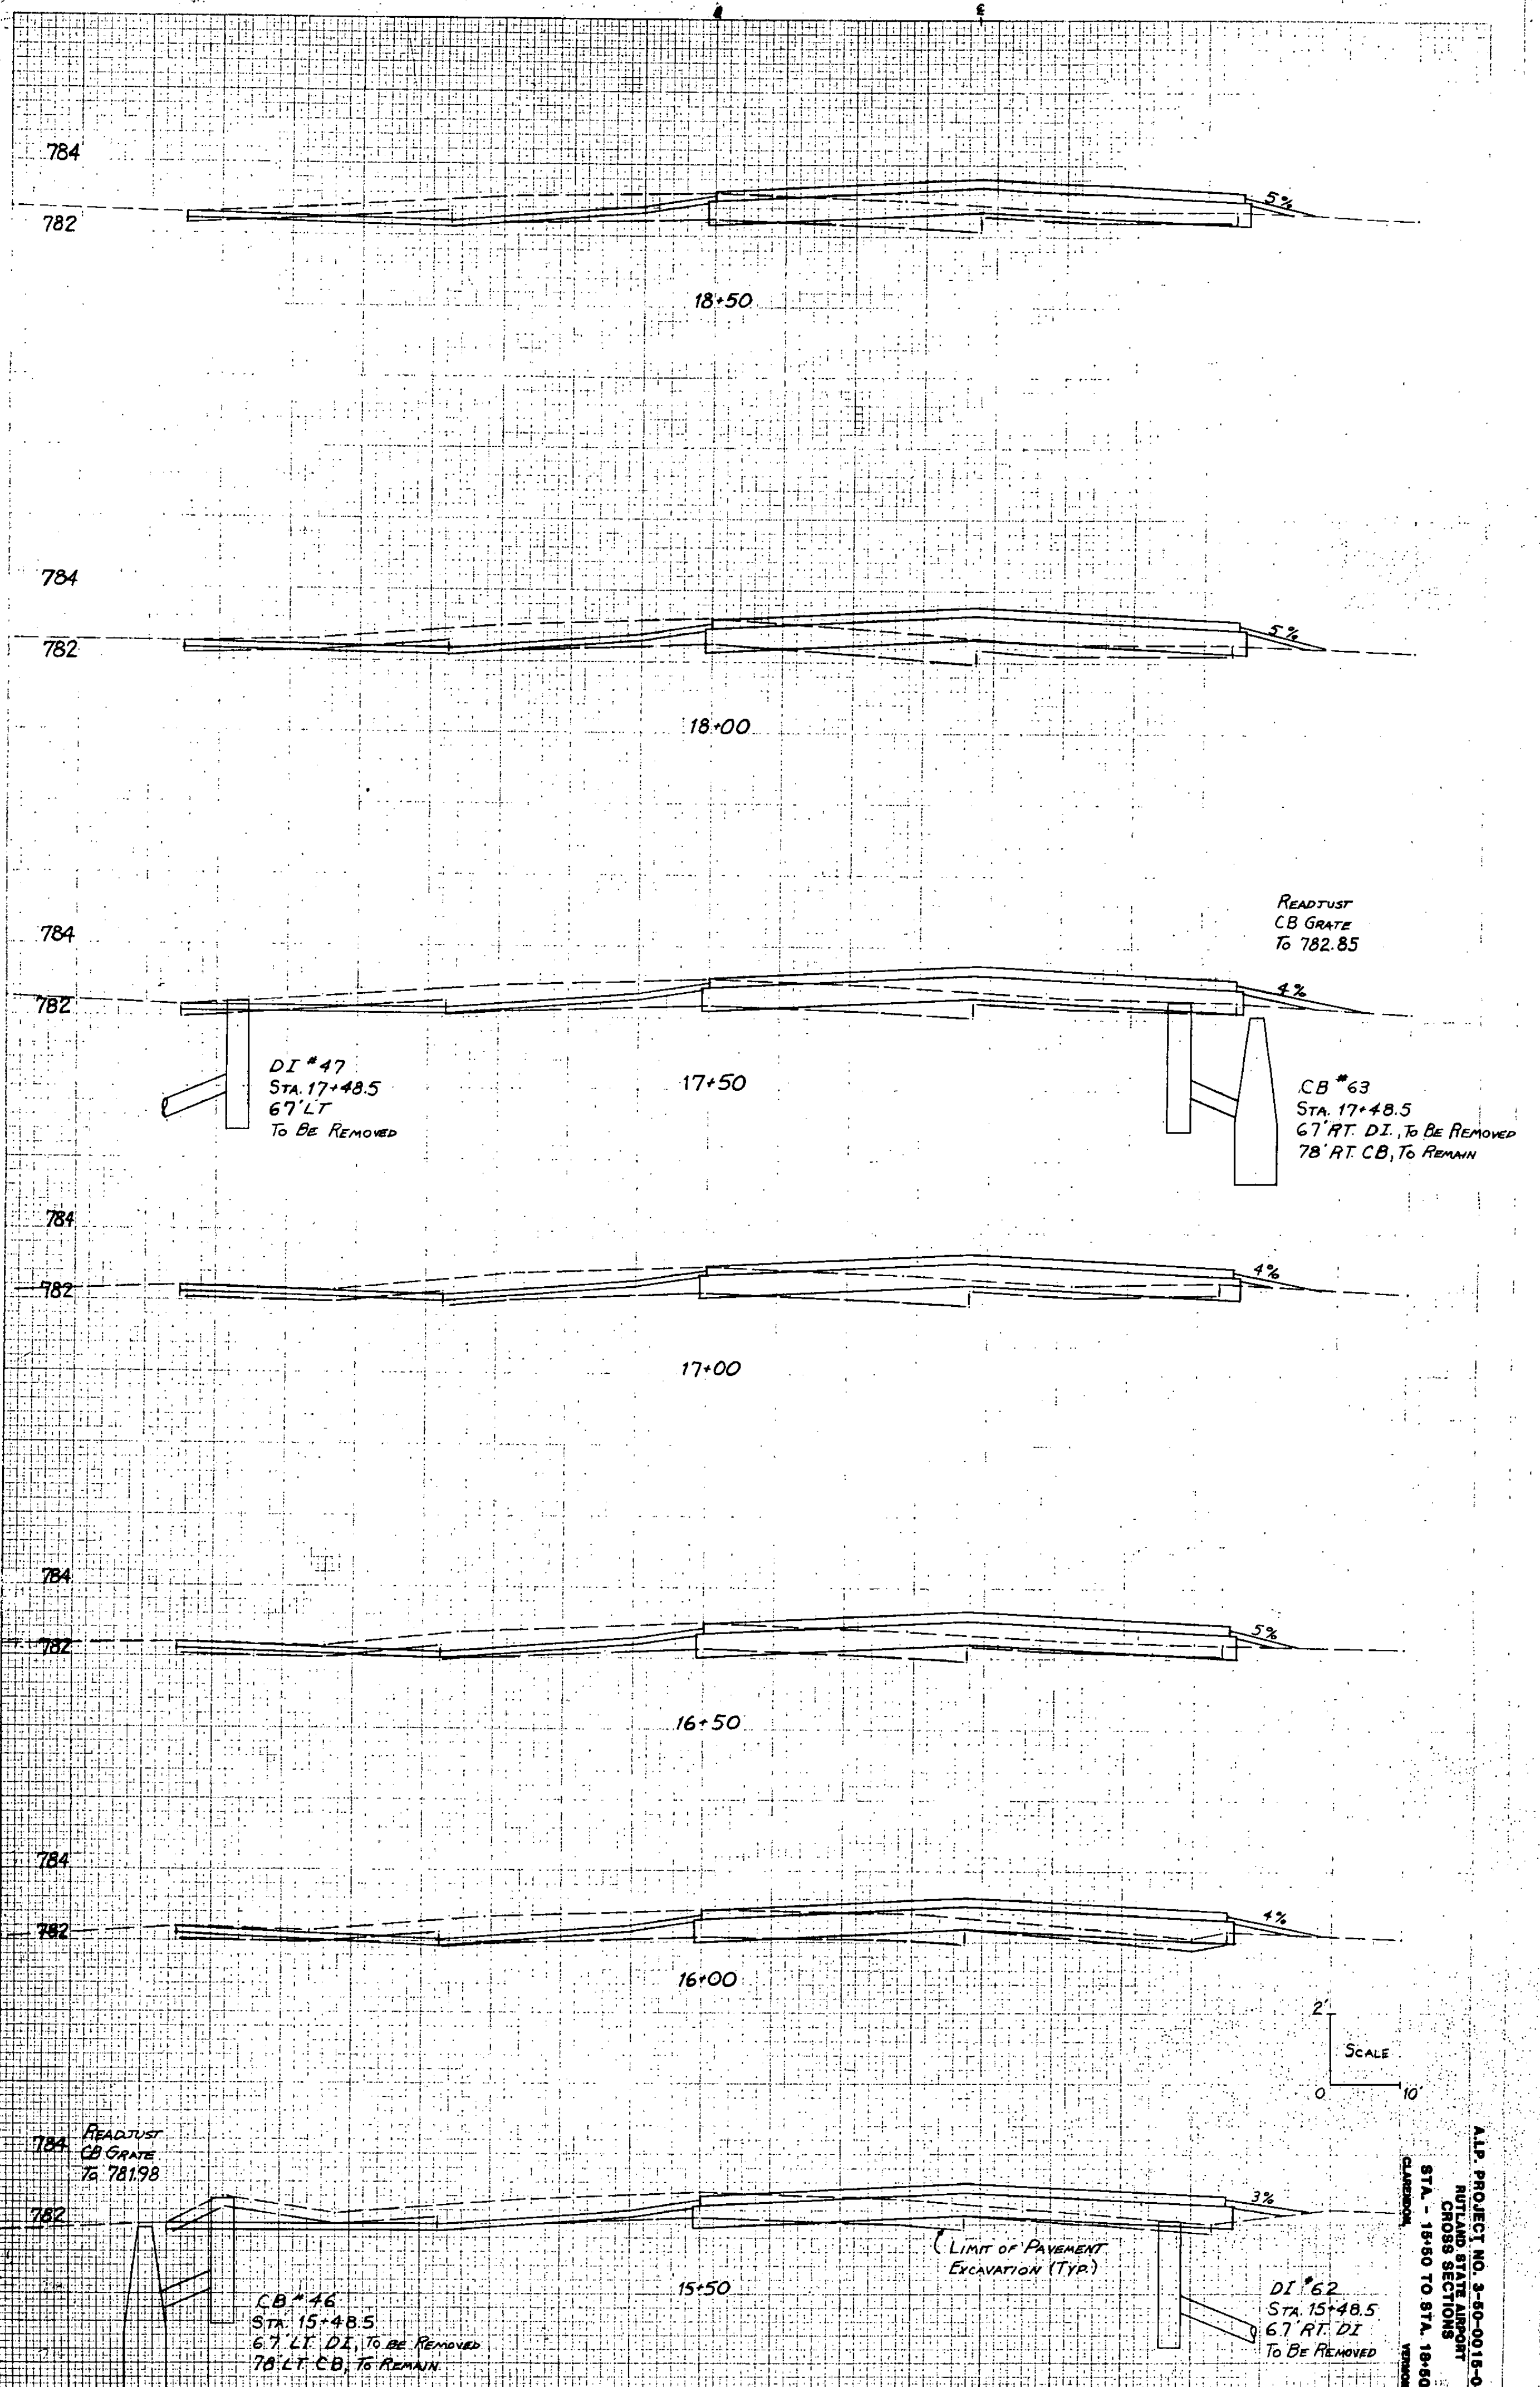

ALTA PROJECT NO. 3-56-0018-0
 RIGHT OF WAY
 STA. 1580 TO STA. 1680
 1968