
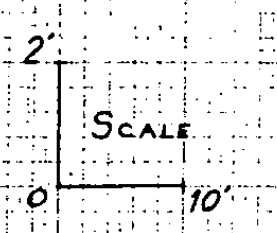


NO. BOOK	DATE

NO. BOOK	DATE

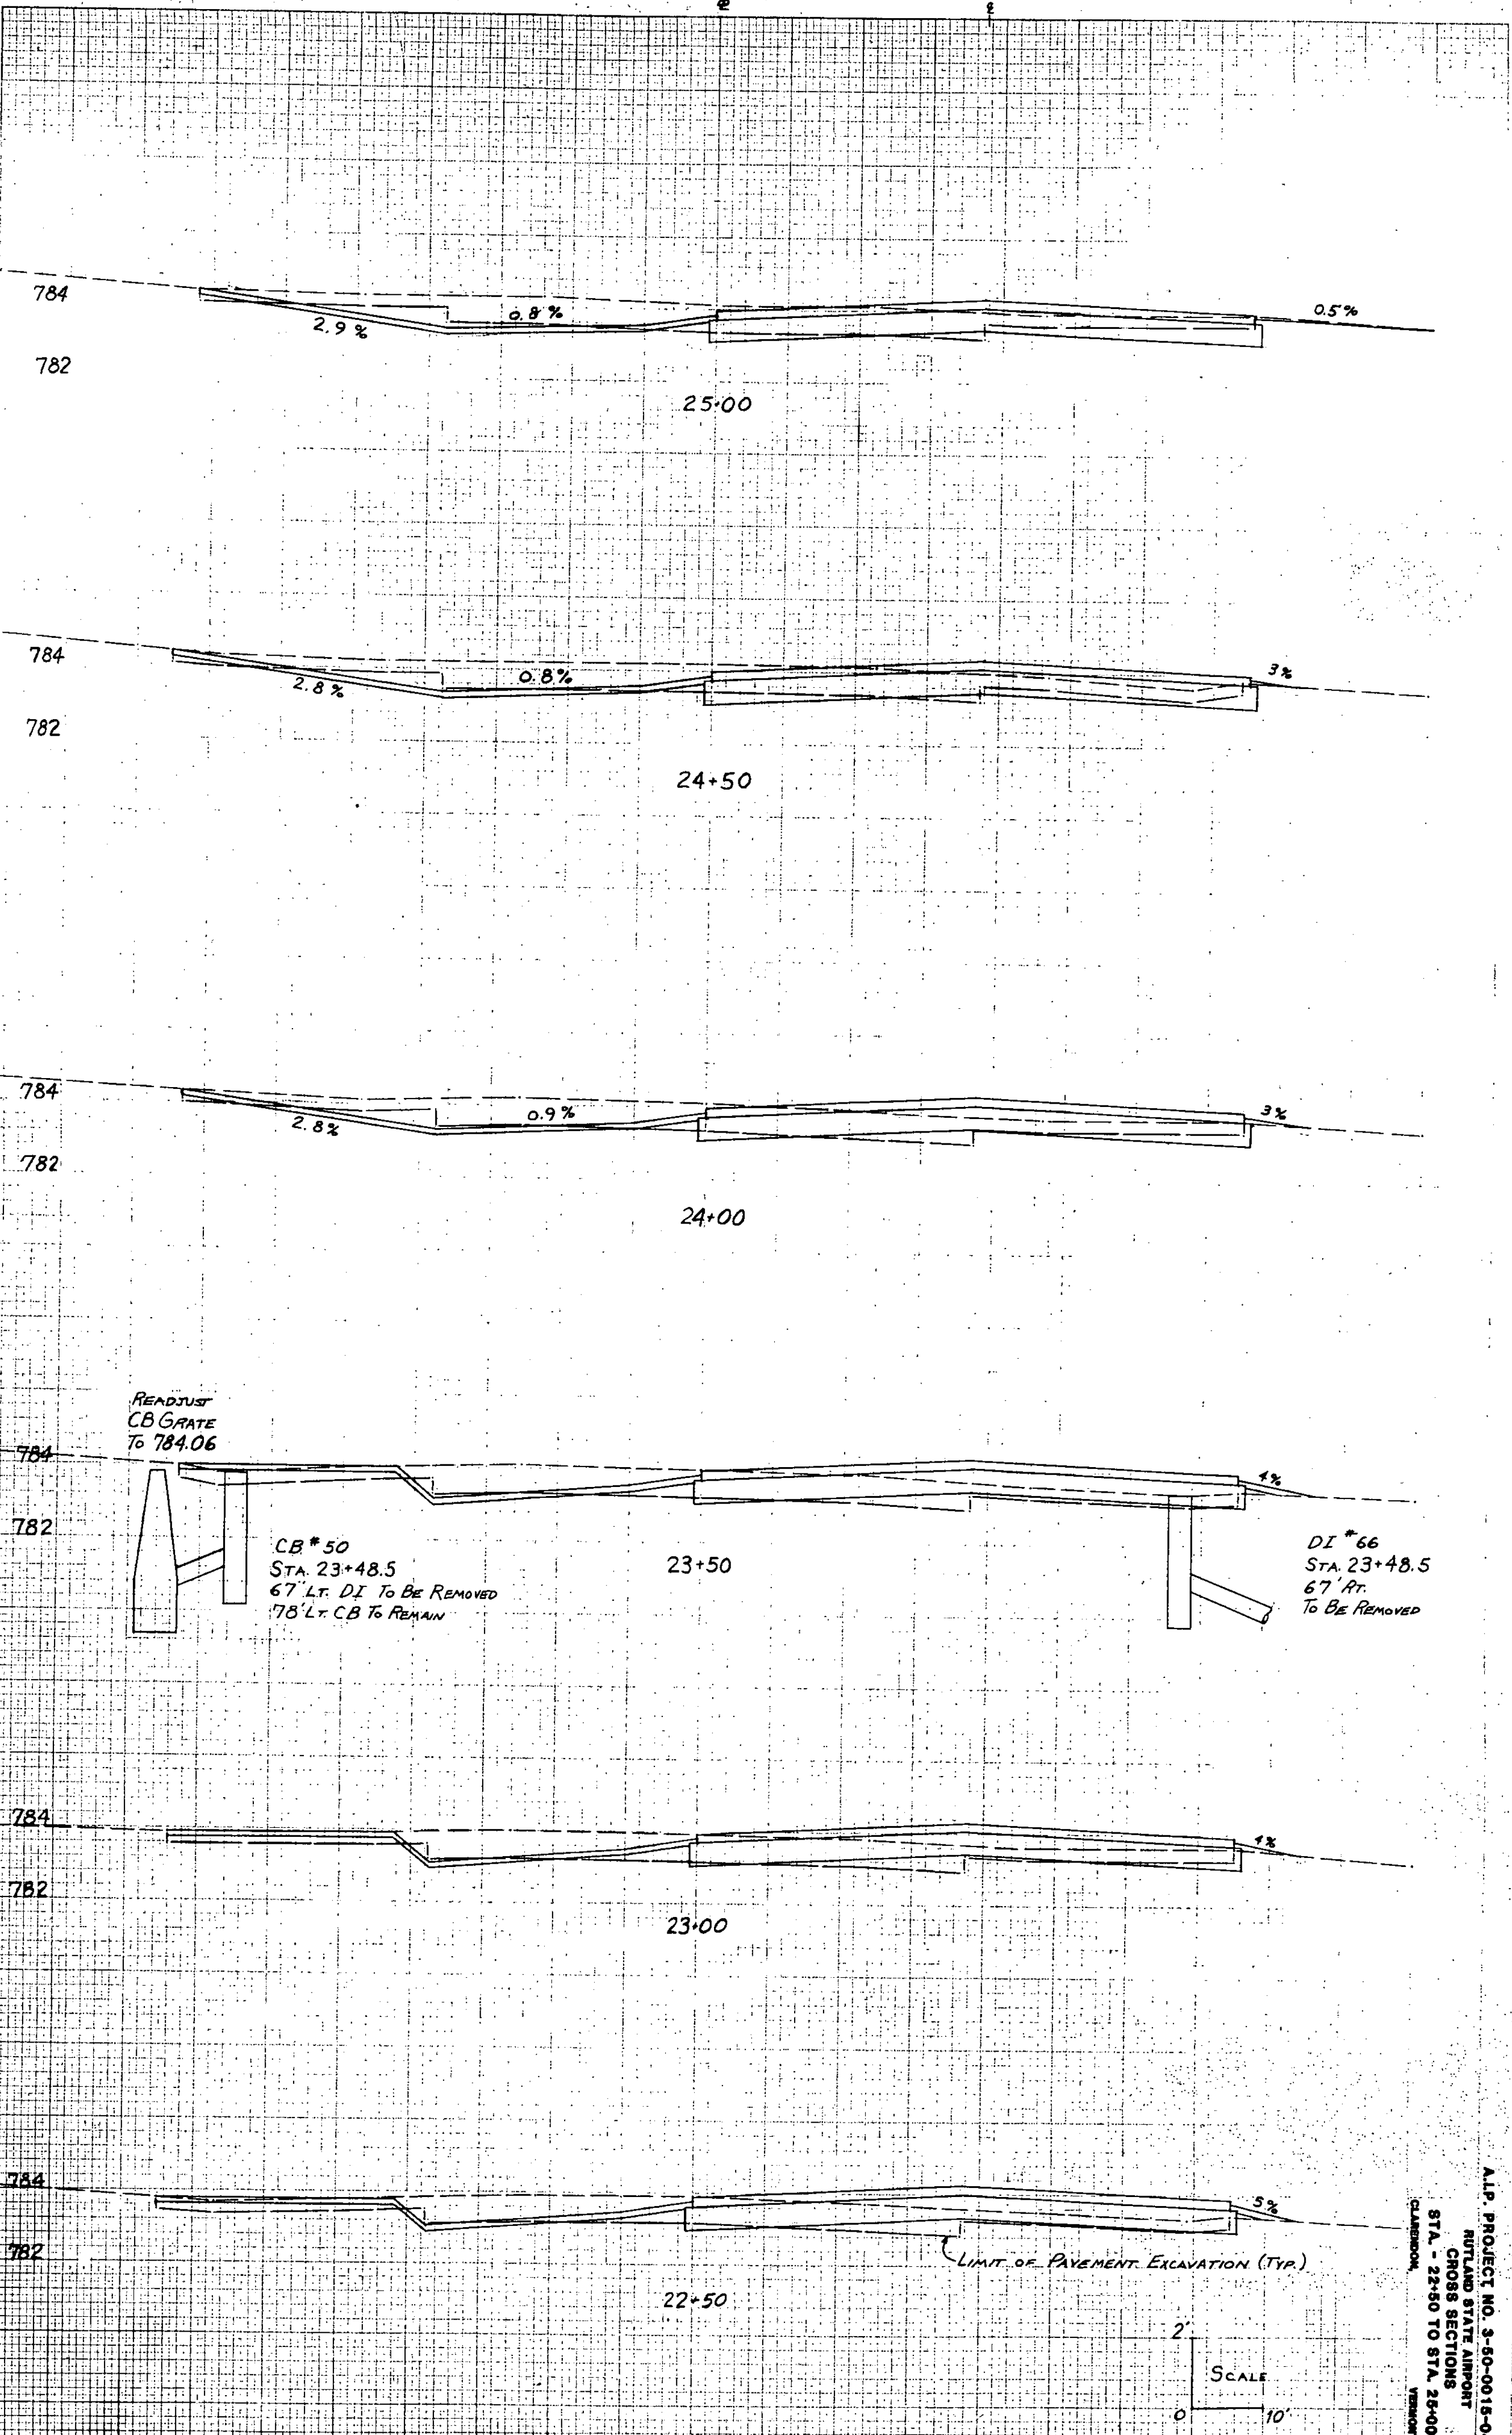

ALP PROJECT NO. 3-50-0018-04  
 RUTLAND STATE AIRPORT  
 CROSS SECTIONS  
 STA. 22+50 TO STA. 25+00