


DATE	NO. OF SHEETS
NO. OF BOARDS	PLANNED
AREA	TEMP.
AREA CHECKED	NO.

DATE	NO. OF SHEETS
NO. OF BOARDS	PLANNED
AREA	TEMP.
AREA CHECKED	NO.

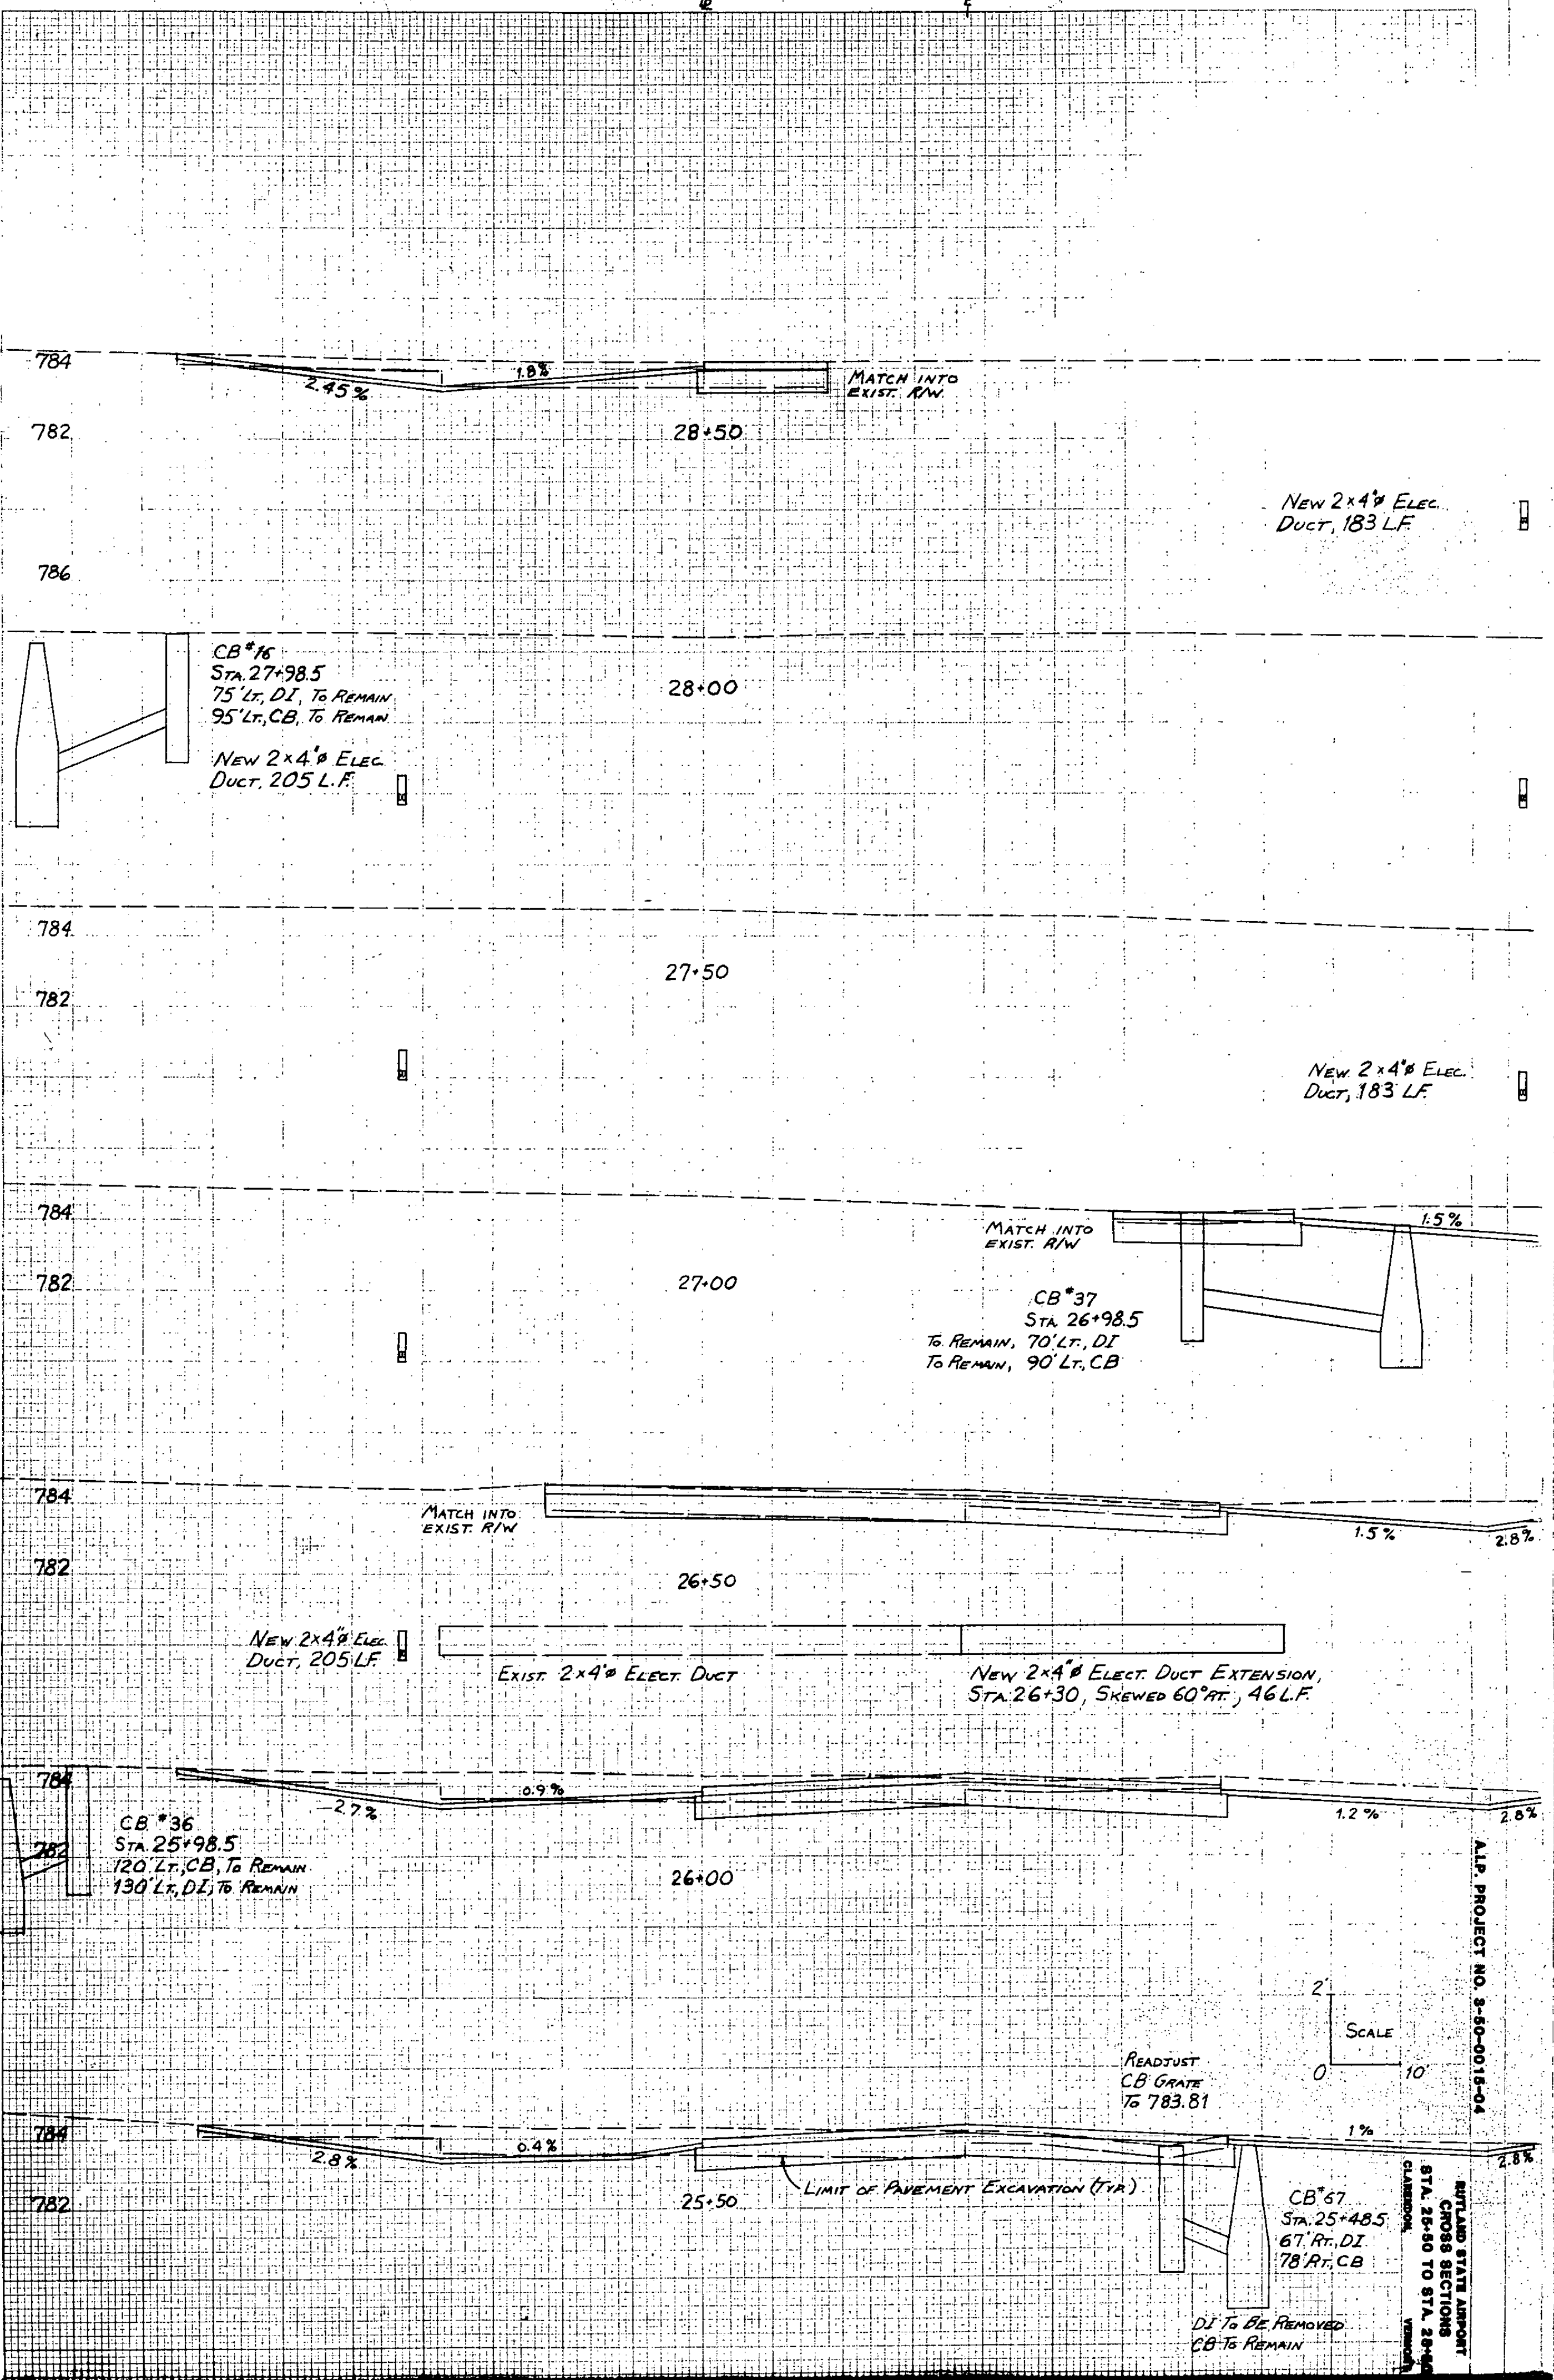

New 2x4" Elec. Duct, 183 LF

CB#16  
Sta. 27+98.5  
75' Lt. DI, To Remain  
95' Lt. CB, To Remain  
New 2x4" Elec. Duct, 205 L.F.

New 2x4" Elec. Duct, 183 LF

CB#37  
Sta. 26+98.5  
To Remain, 70' Lt. DI  
To Remain, 90' Lt. CB

New 2x4" Elec. Duct, 205 LF

EXIST. 2x4" ELECT. DUCT


New 2x4" ELECT. DUCT EXTENSION,  
Sta. 26+30, SKEWED 60° FT., 46 L.F.

CB#36  
Sta. 25+98.5  
120' Lt. CB, To Remain  
130' Lt. DI, To Remain

READJUST  
CB GRATE  
To 783.51

CB#57  
Sta. 25+48.5  
67' Ft. DI  
78' Ft. CB

DI TO BE REMOVED  
CB TO REMAIN

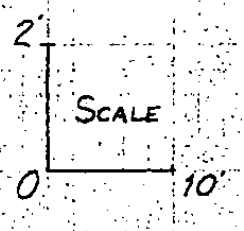

ALP PROJECT NO. 3-80-0018-04

RETURN STATE AMOUNT  
STA. 25+40 TO STA. 25+46  
CUMULATIVE