


DATE	BY	REVISION

DATE	BY	REVISION

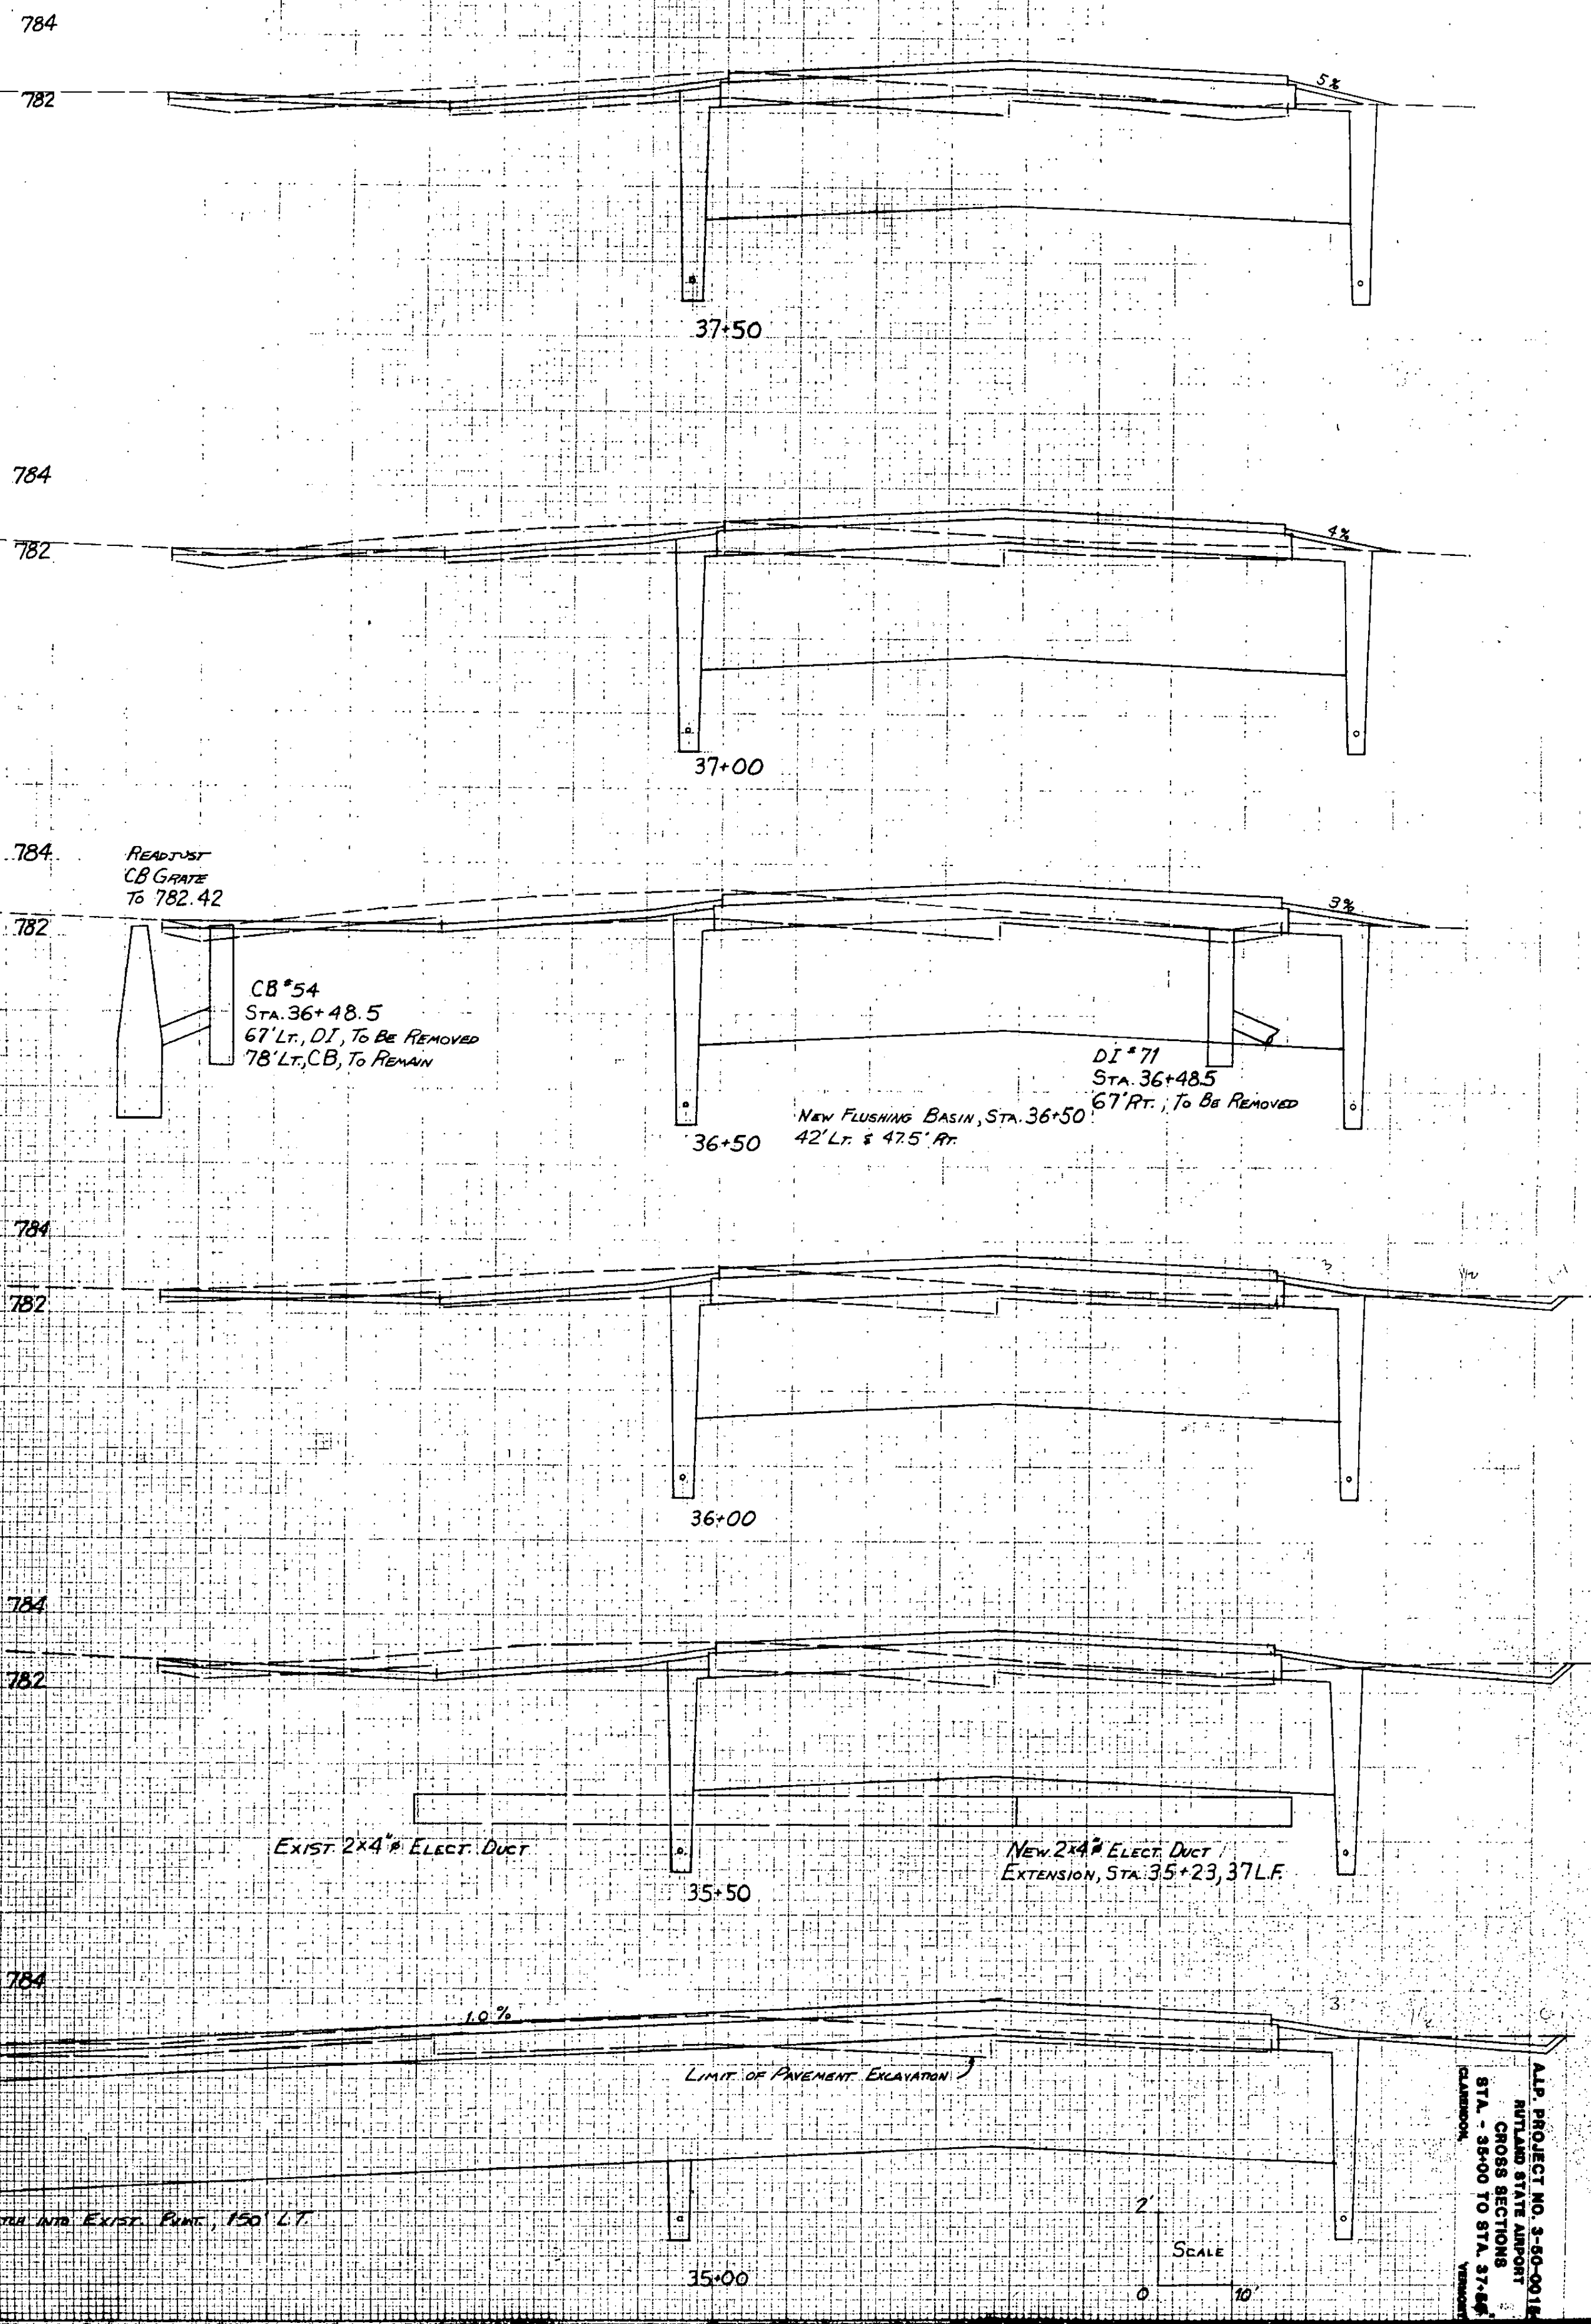

784
782

READY-SET
CB GRATE
TO 782.42

CB #54
STA. 36+48.5
67' LT., DI, TO BE REMOVED
78' LT., CB, TO REMAIN

DI #71
STA. 36+48.5
67' RT., TO BE REMOVED

NEW FLUSHING BASIN, STA. 36+50
42' LT. x 47.5' RT.

EXIST 2x4" ELECT. DUCT

NEW 2x4" ELECT. DUCT
EXTENSION, STA. 35+23, 37 LF.

APP. PROJECT NO. 3-50-0014
HUTLAND STATE AIRPORT
CROSS SECTIONS
STA. - 35+00 TO STA. 37+00
CLASSROOM

SCALE
0 10