


GRAPHIC SCALE

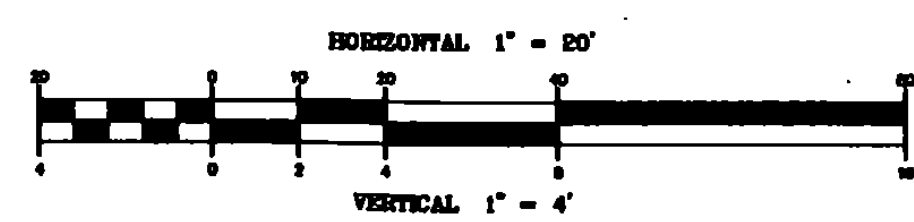

NO.	DATE	DESCRIPTION	BY	CHK'D
1	1/18/01	VAOT COMMENTS AND SURVEY ADJUSTMENTS	MDL	SJR
		REVISIONS		

**DuBois & King**  
 engineering planning management development

VERMONT AGENCY OF  
 TRANSPORTATION  
 COVENTRY, VERMONT  
 NEWPORT STATE AIRPORT  
 RUNWAY 18-36 RECONSTRUCTION  
 CROSS SECTIONS RW 18-36  
 STA. 17+00 TO 21+50

DRAWN BY JJP	DATE MAR. 2000
CHECKED BY	PROJ. NO. N15500
PROJ. ENG. JAA	DRAW. NO. 1
SHEET XS-2	