


I:\V\500F2\0\1\500F20010.dwg Fri, Feb 02 11:34:19 2001

GRAPHIC SCALE

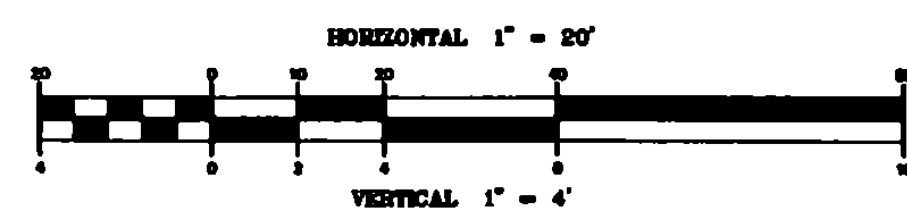

NO.	DATE	REVISIONS	BY	CHK'D
1	1/16/01	VADT COMMENTS AND SURVEY ADJUSTMENTS	MDL	SJR

DuBois & King
engineering planning management development

VERMONT AGENCY OF
TRANSPORTATION
COVENTRY, VERMONT
NEWPORT STATE AIRPORT
RUNWAY 18-36 RECONSTRUCTION
CROSS SECTIONS RW 18-36
STA. 22+00 TO 26+50

DRAWN BY JJP	DATE MAR. 2000
CHECKED BY	PROJ. NO. NT15500
PROJ. ENGR. JAA	DRAW. NO. 1
SHEET XS-3	