


I:\15500\F23\p1\15500F20011.dwg Fri Feb 02 11:34:39 2001

GRAPHIC SCALE

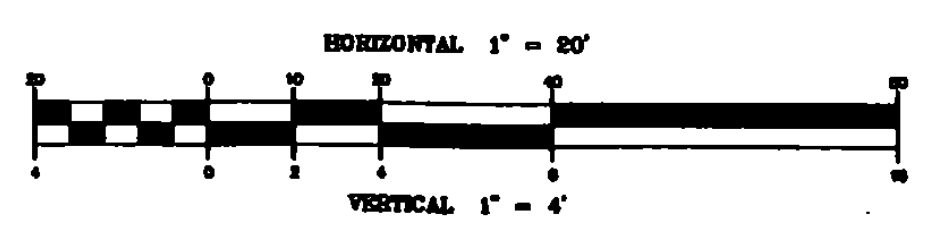

NO.	DATE	REVISIONS	BY	CHK'D
1	1/18/01	VAOT COMMENTS AND SURVEY ADJUSTMENTS	MDL	SJR

DuBois & King
 engineering planning management development

VERMONT AGENCY OF
 TRANSPORTATION
 COVENTRY, VERMONT
 NEWPORT STATE AIRPORT
 RUNWAY 18-36 RECONSTRUCTION
 CROSS SECTIONS RW 18-36
 STA. 27+00 TO 31+50

DRAWN BY JJP	DATE MAR, 2000
CHECKED BY	PROJ. NO. N15500
PROJ. ENG. JAA	DRAW. NO. 1
SHEET XS-4	