

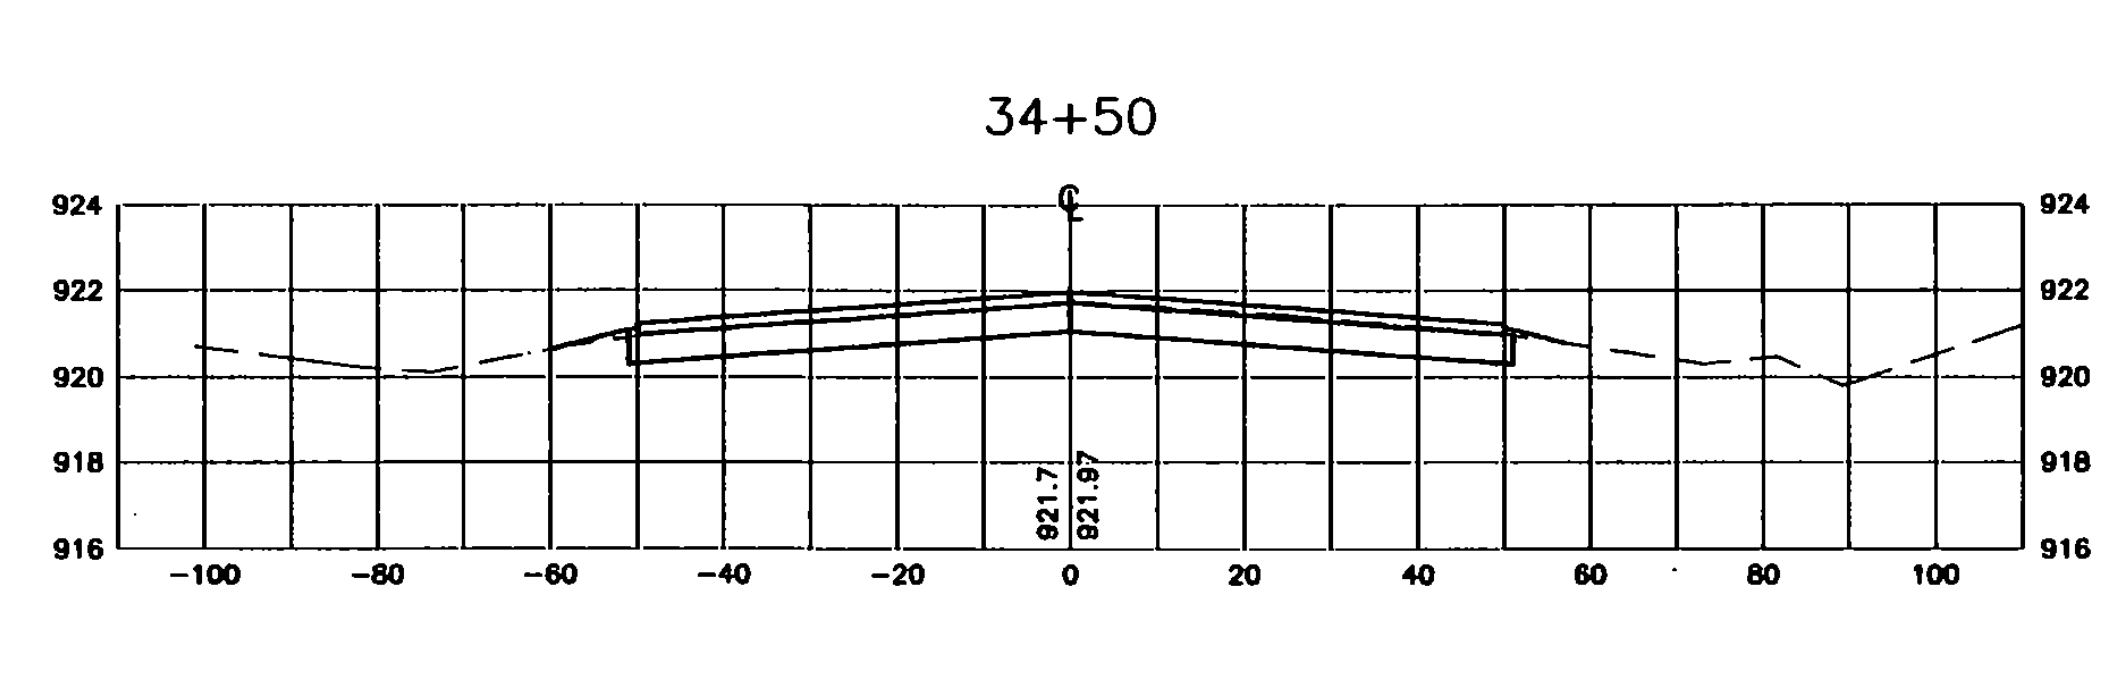
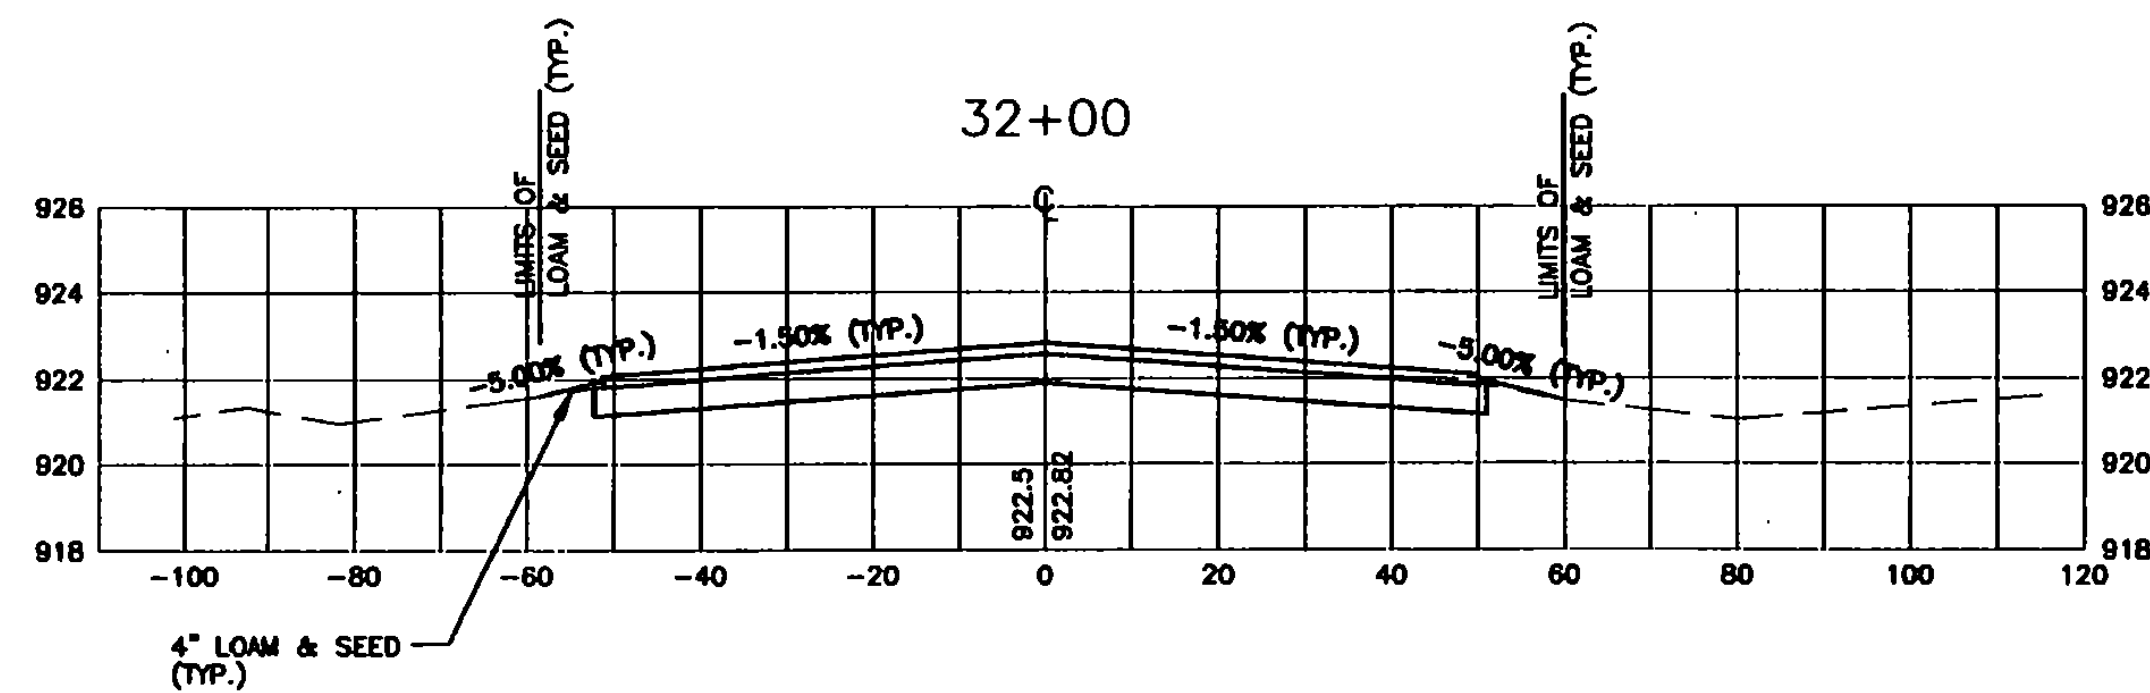
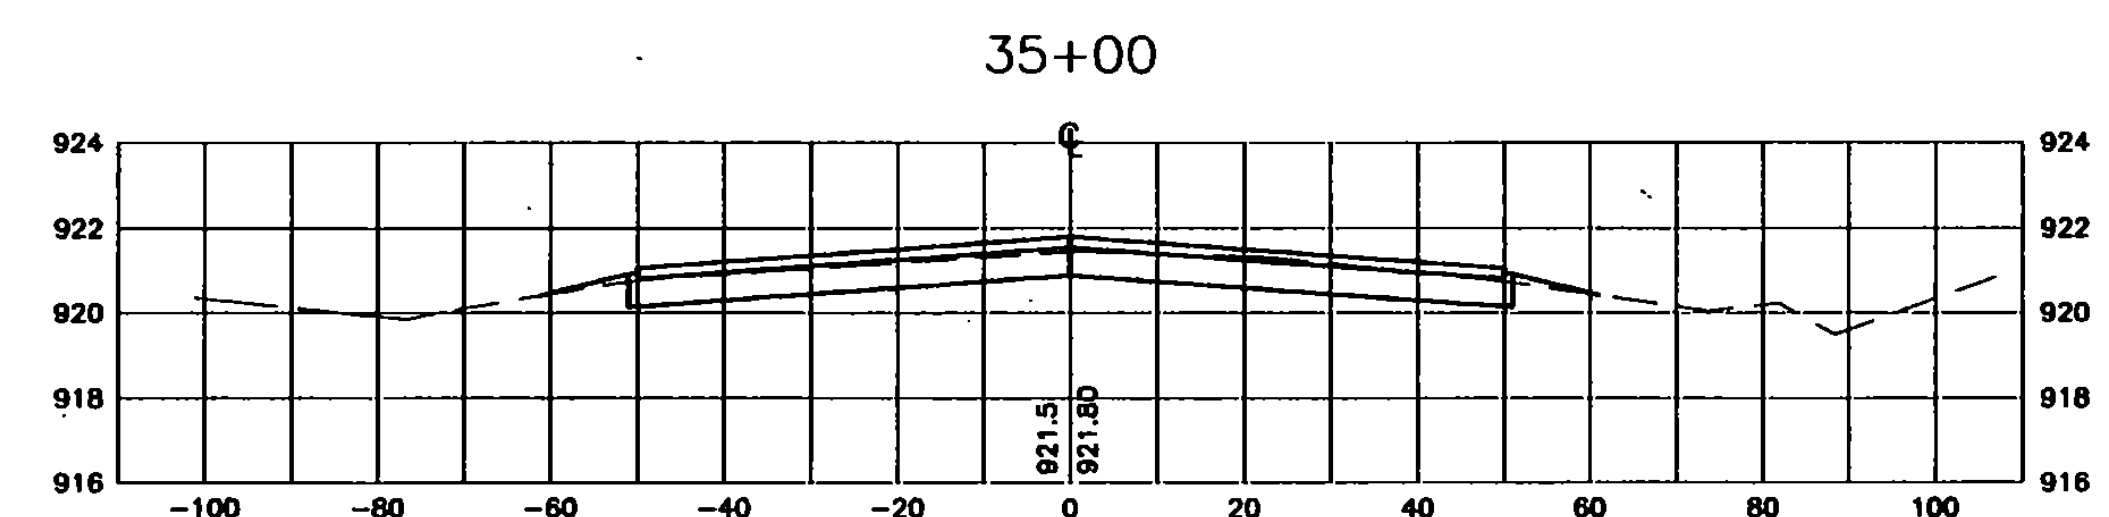
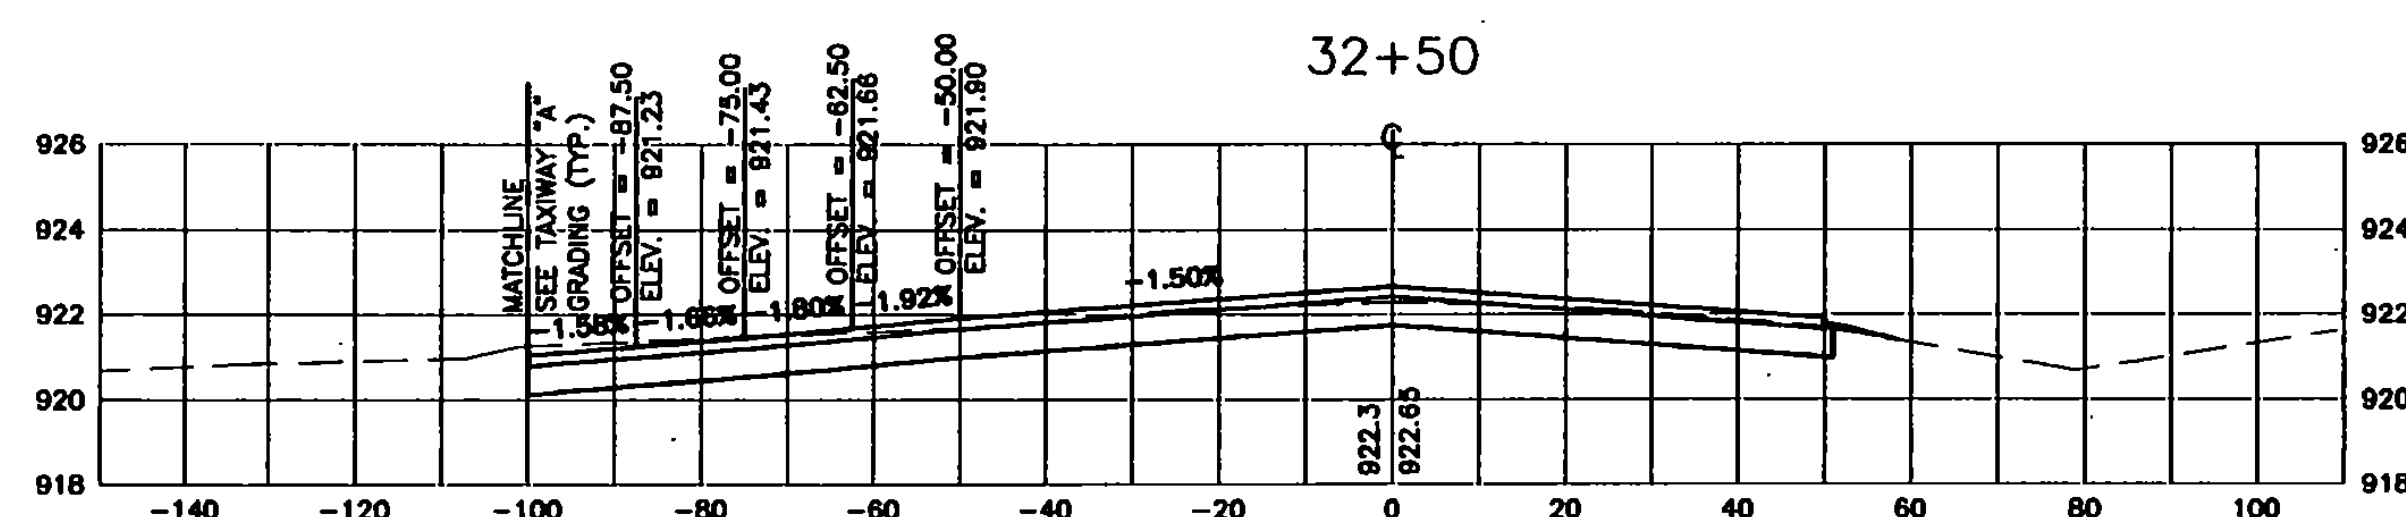
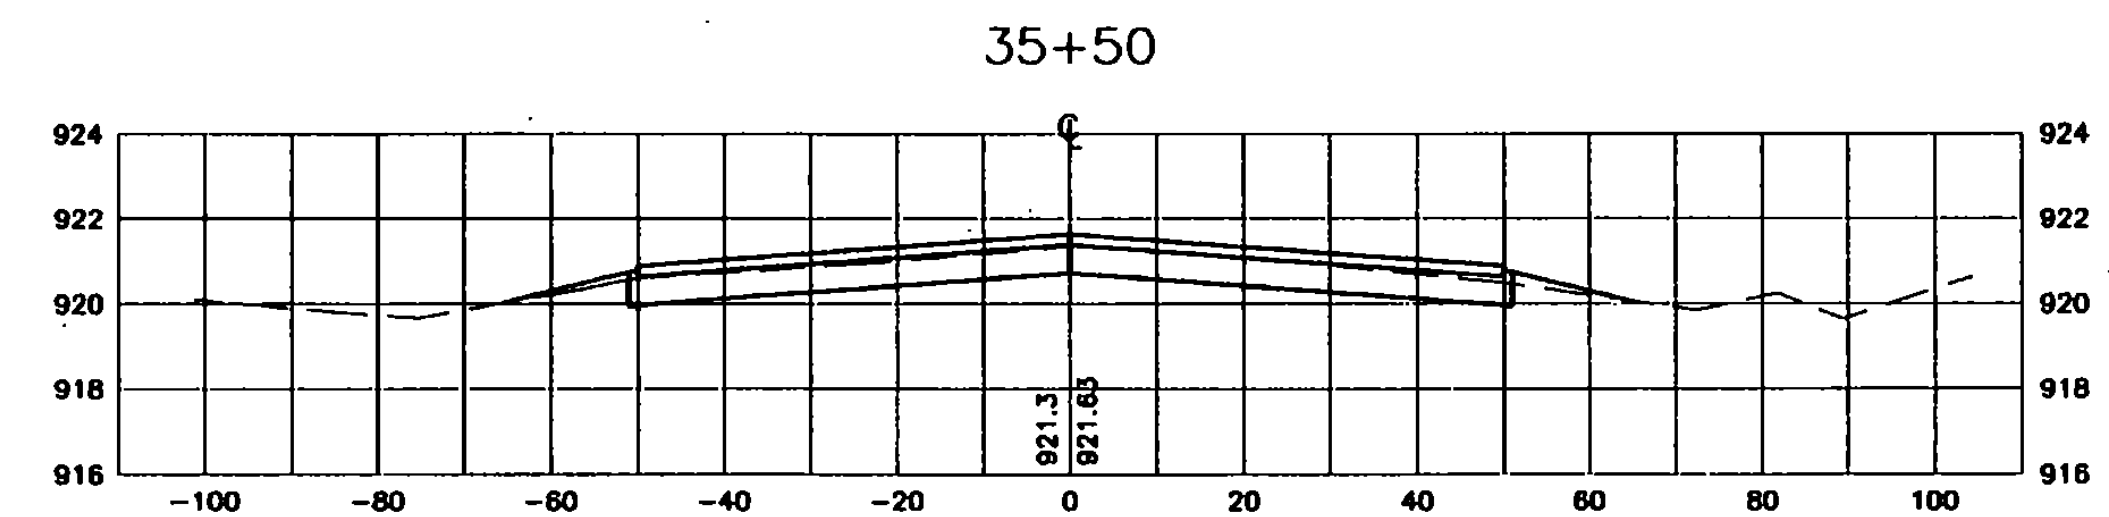
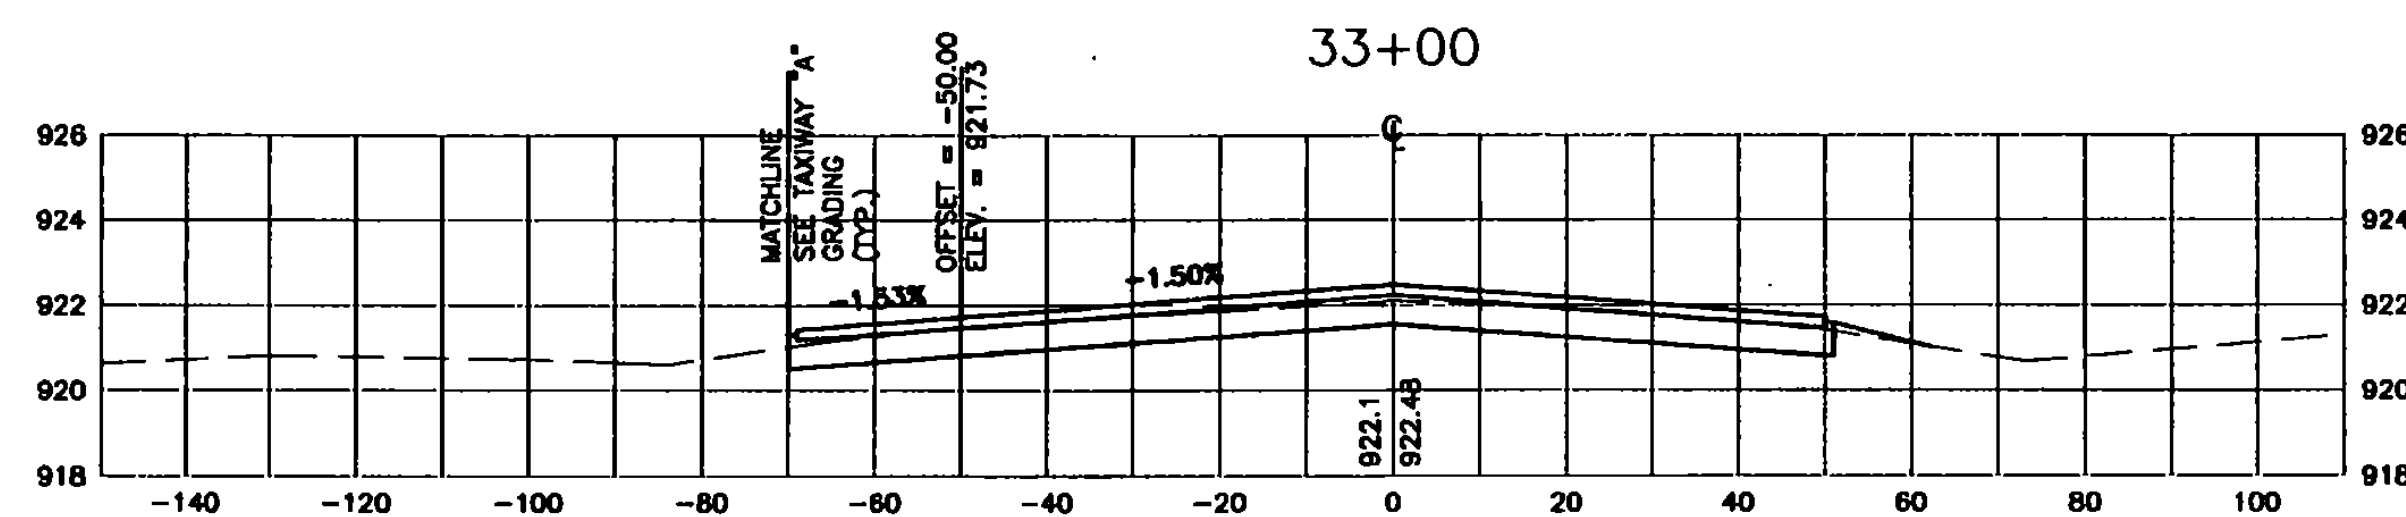
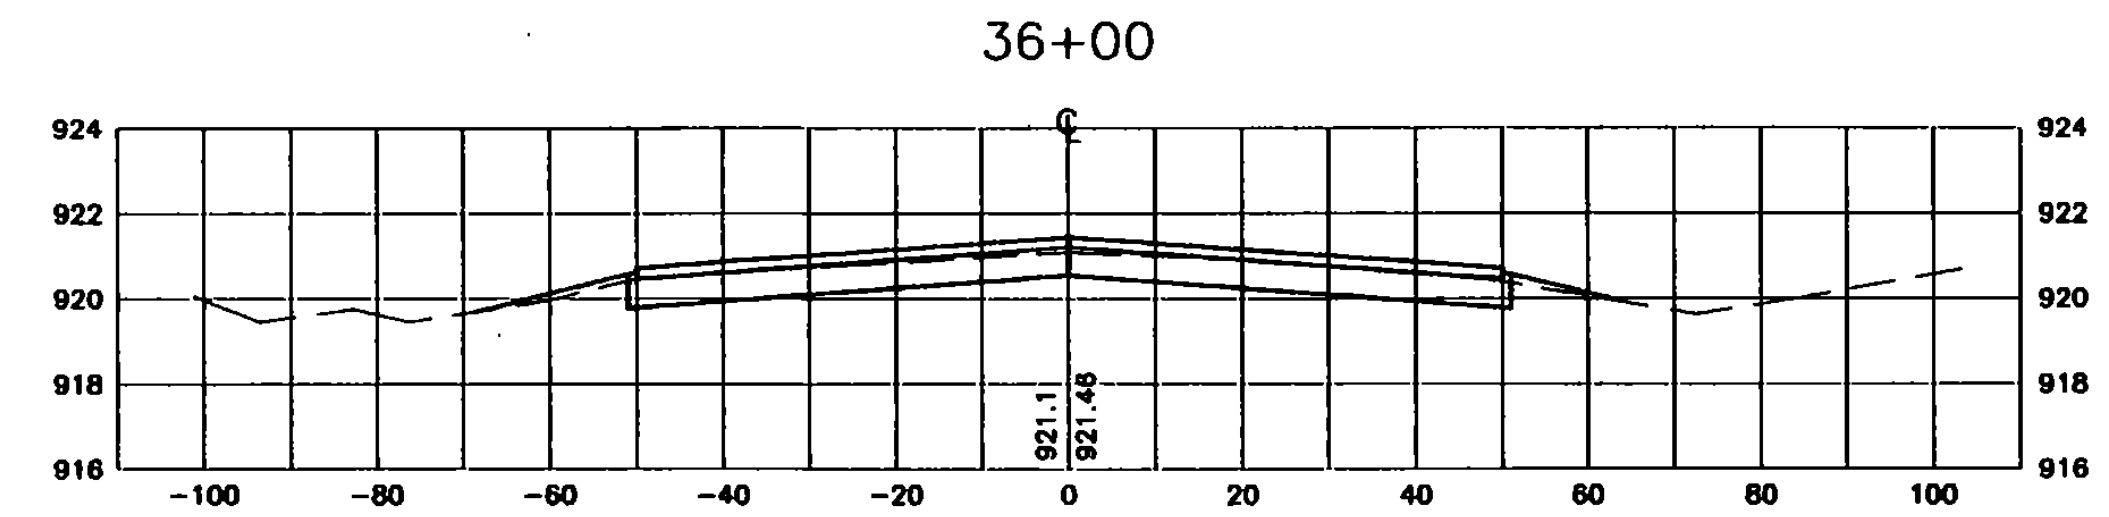
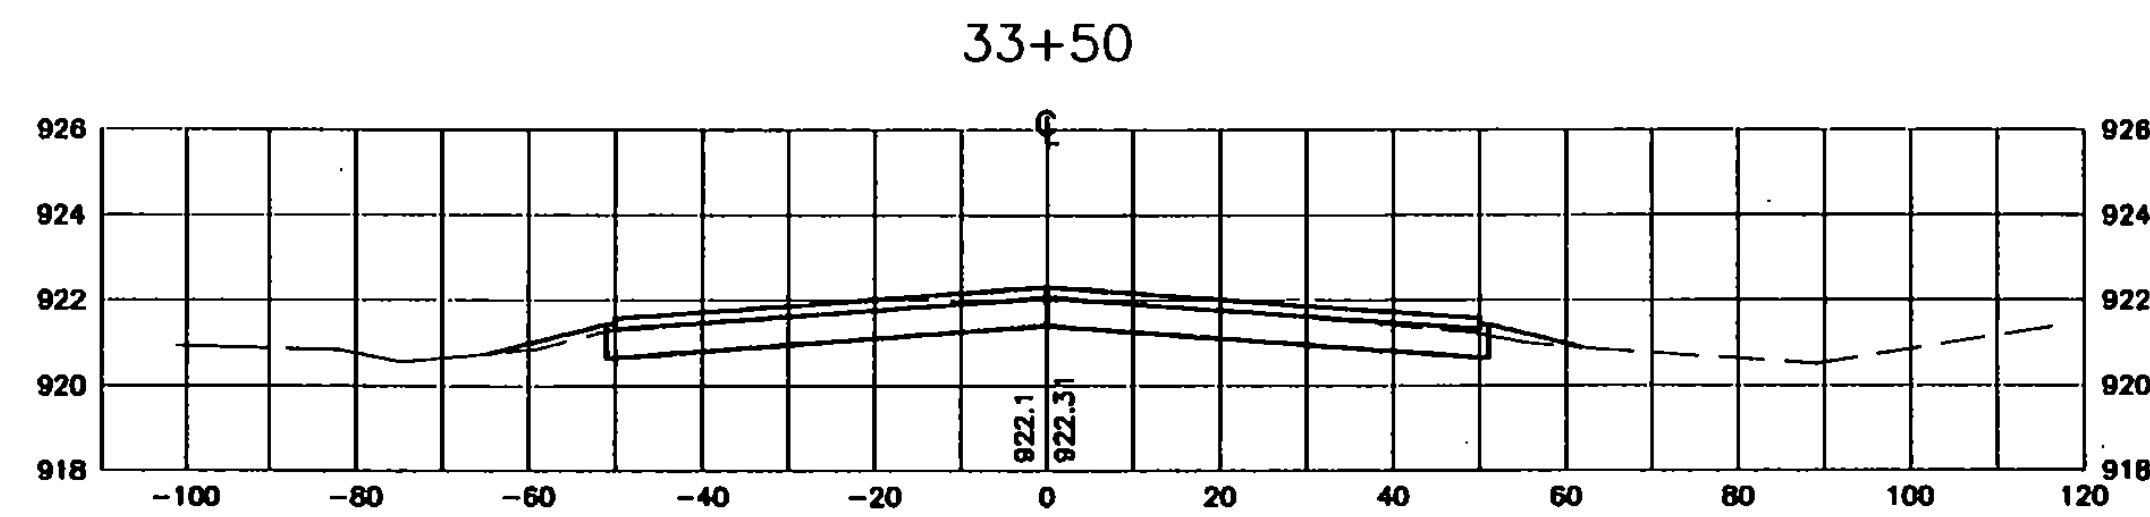
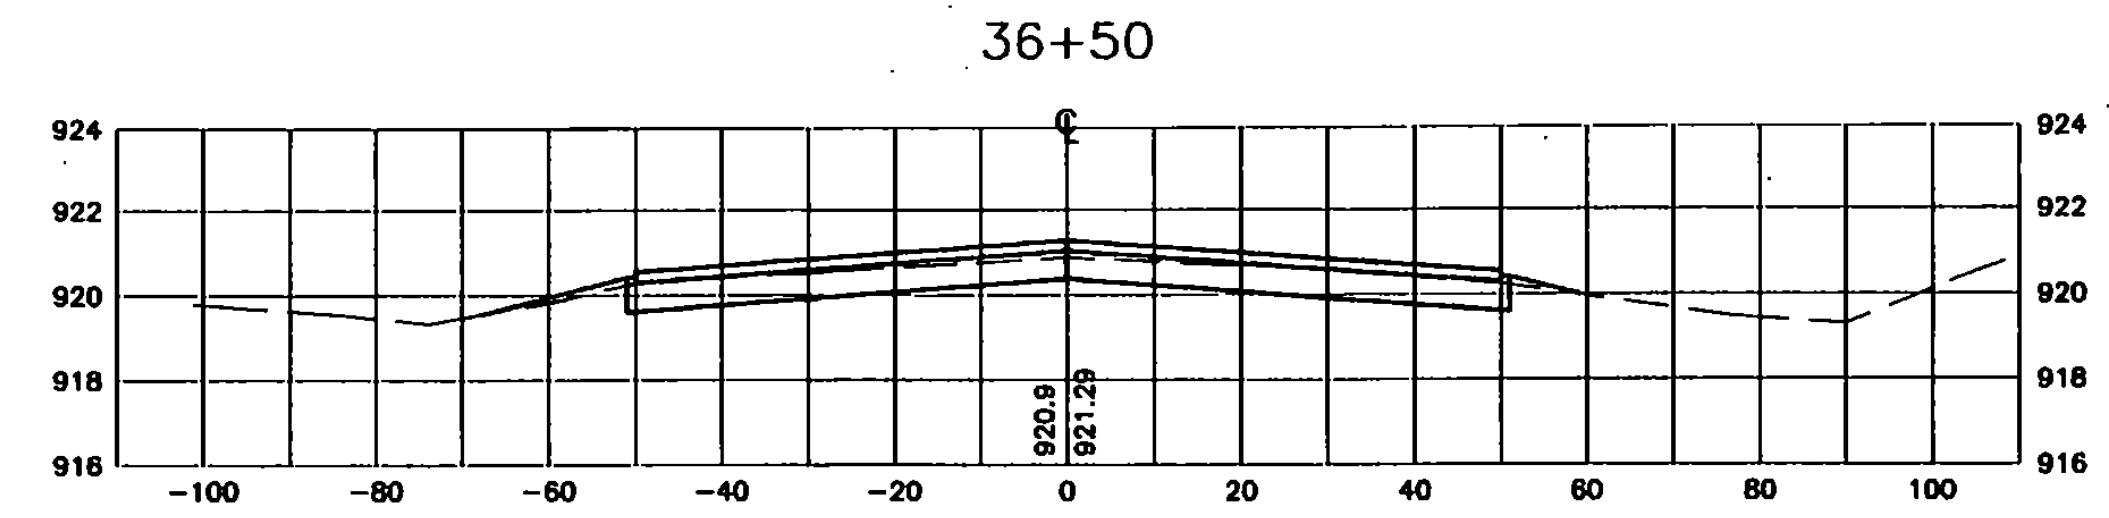


I:\15500P\01\15500P2012.dwg P1: Feb 02 11:35:01 2001

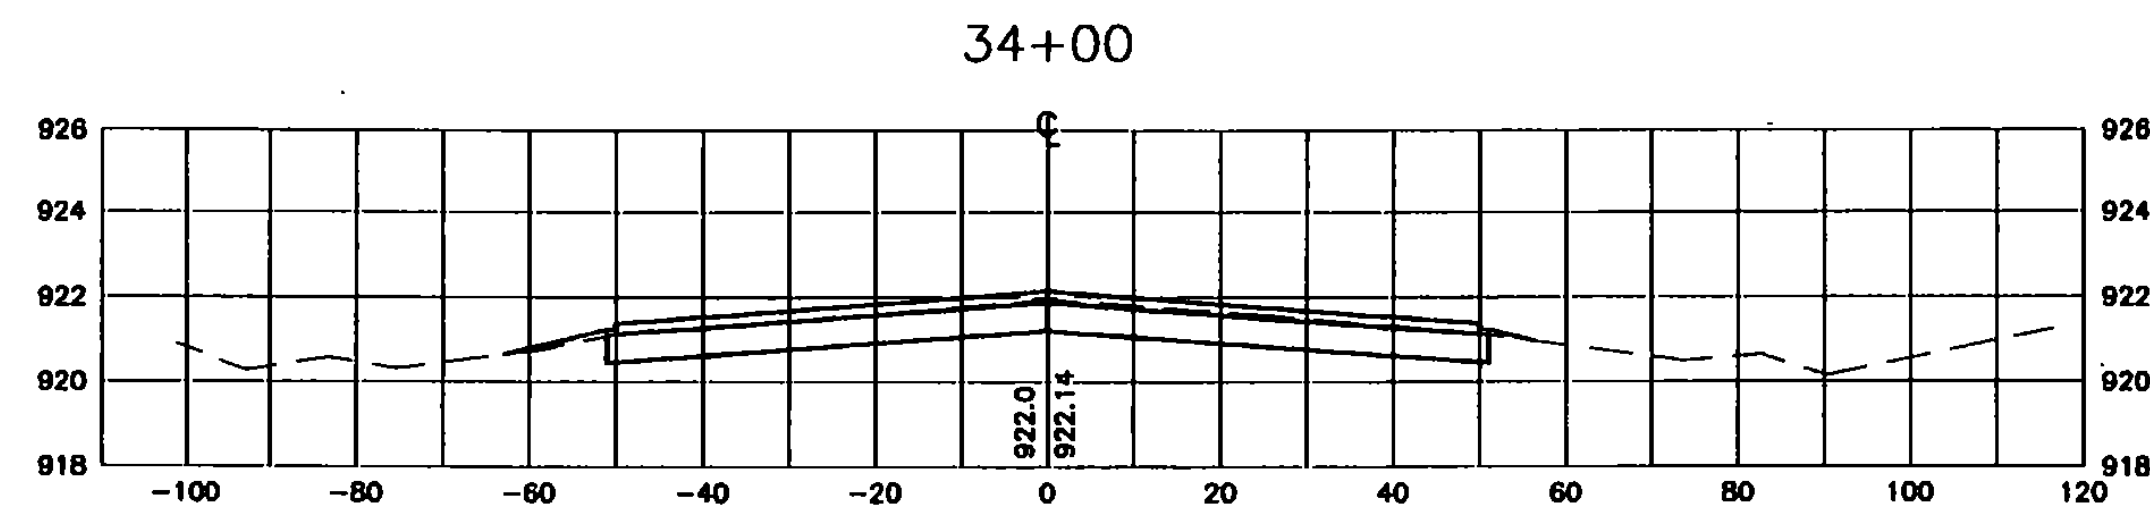

GRAPHIC SCALE

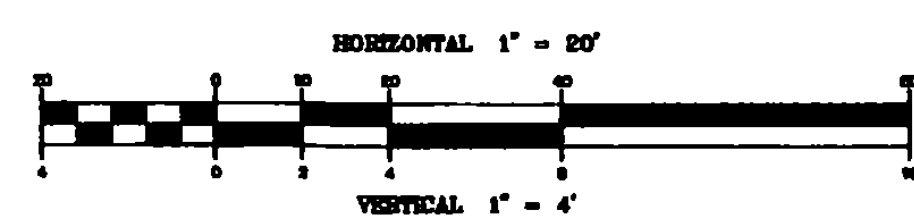

NO.	DATE	REVISIONS	BY	CHK'D
1	1/18/01	VAOT COMMENTS AND SURVEY ADJUSTMENTS	MDL	SJR

DuBois & King
 engineering planning management development

VERMONT AGENCY OF
 TRANSPORTATION
 COVENTRY, VERMONT
 NEWPORT STATE AIRPORT
 RUNWAY 18-36 RECONSTRUCTION
 CROSS SECTIONS RW 18-36
 STA. 32+00 TO 36+50

DRAWN BY JJP	DATE MAR. 2000
CHECKED BY	PROJ. NO. N15500
PROJ. ENG. JAA	DRAW. NO. 1
SHEET XS-5	