

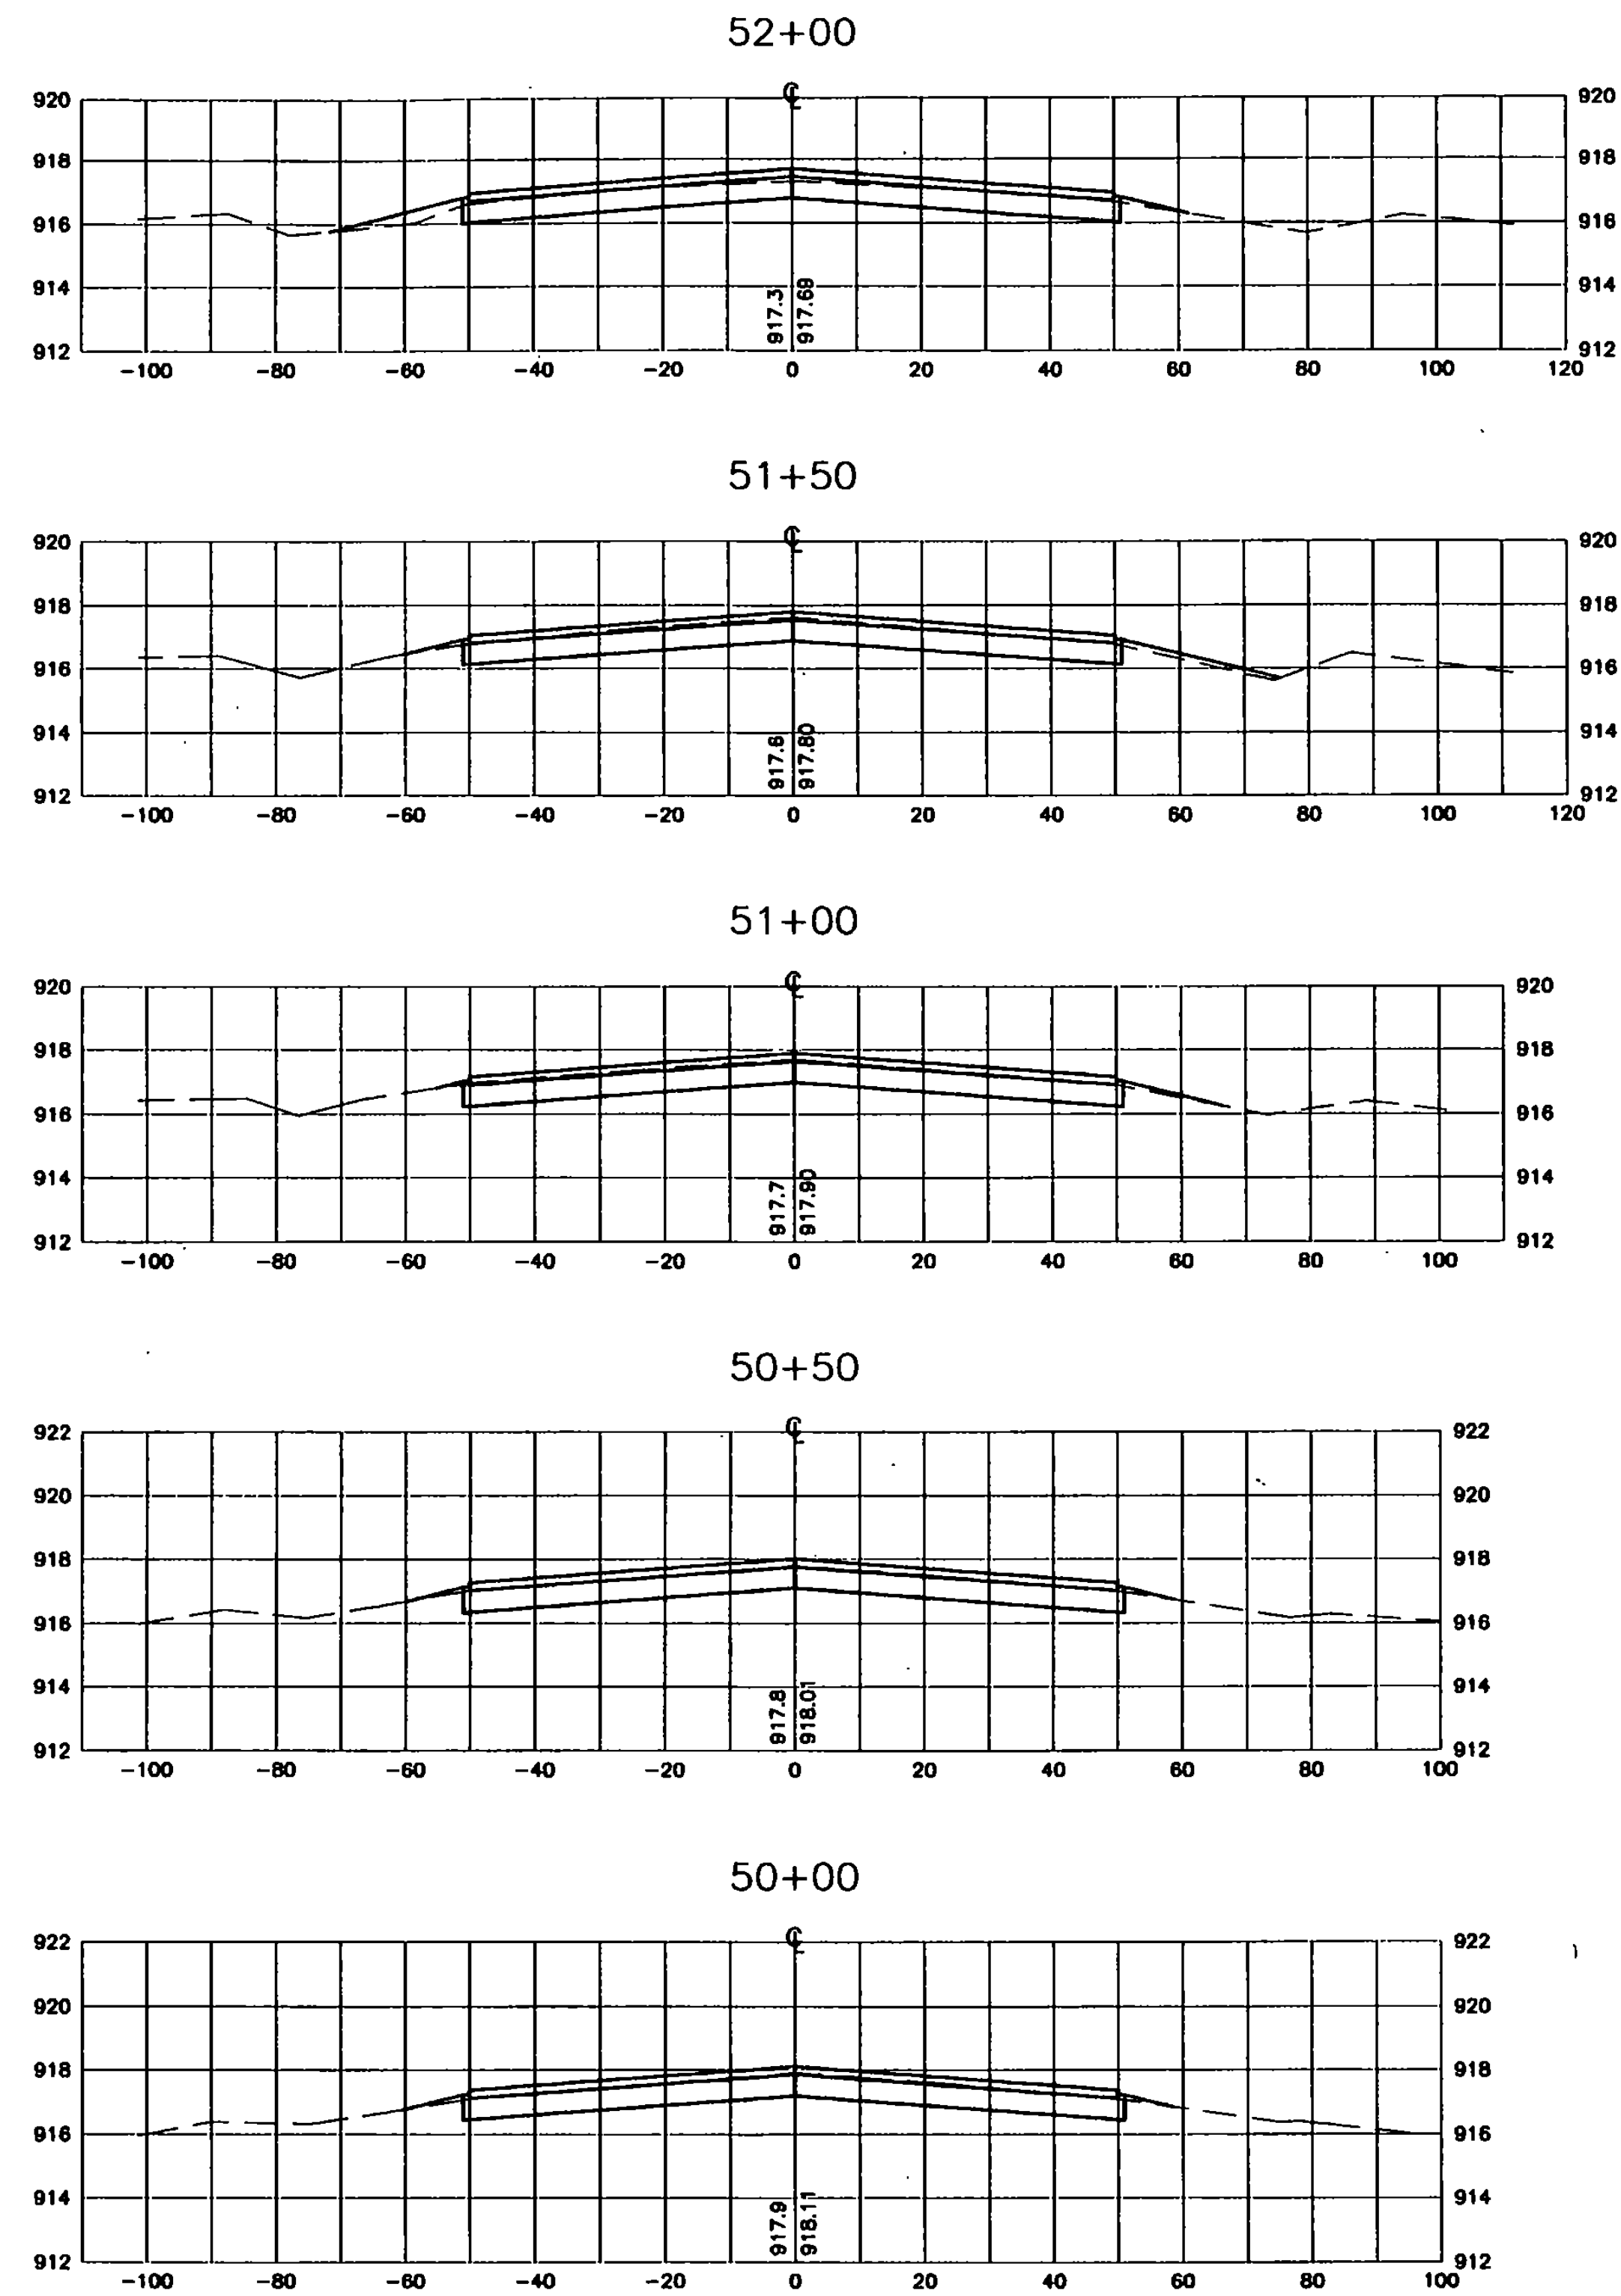


I:\115500\F2\dwg\115500\F2015.dwg Fri Feb 02 11:35:06 2001

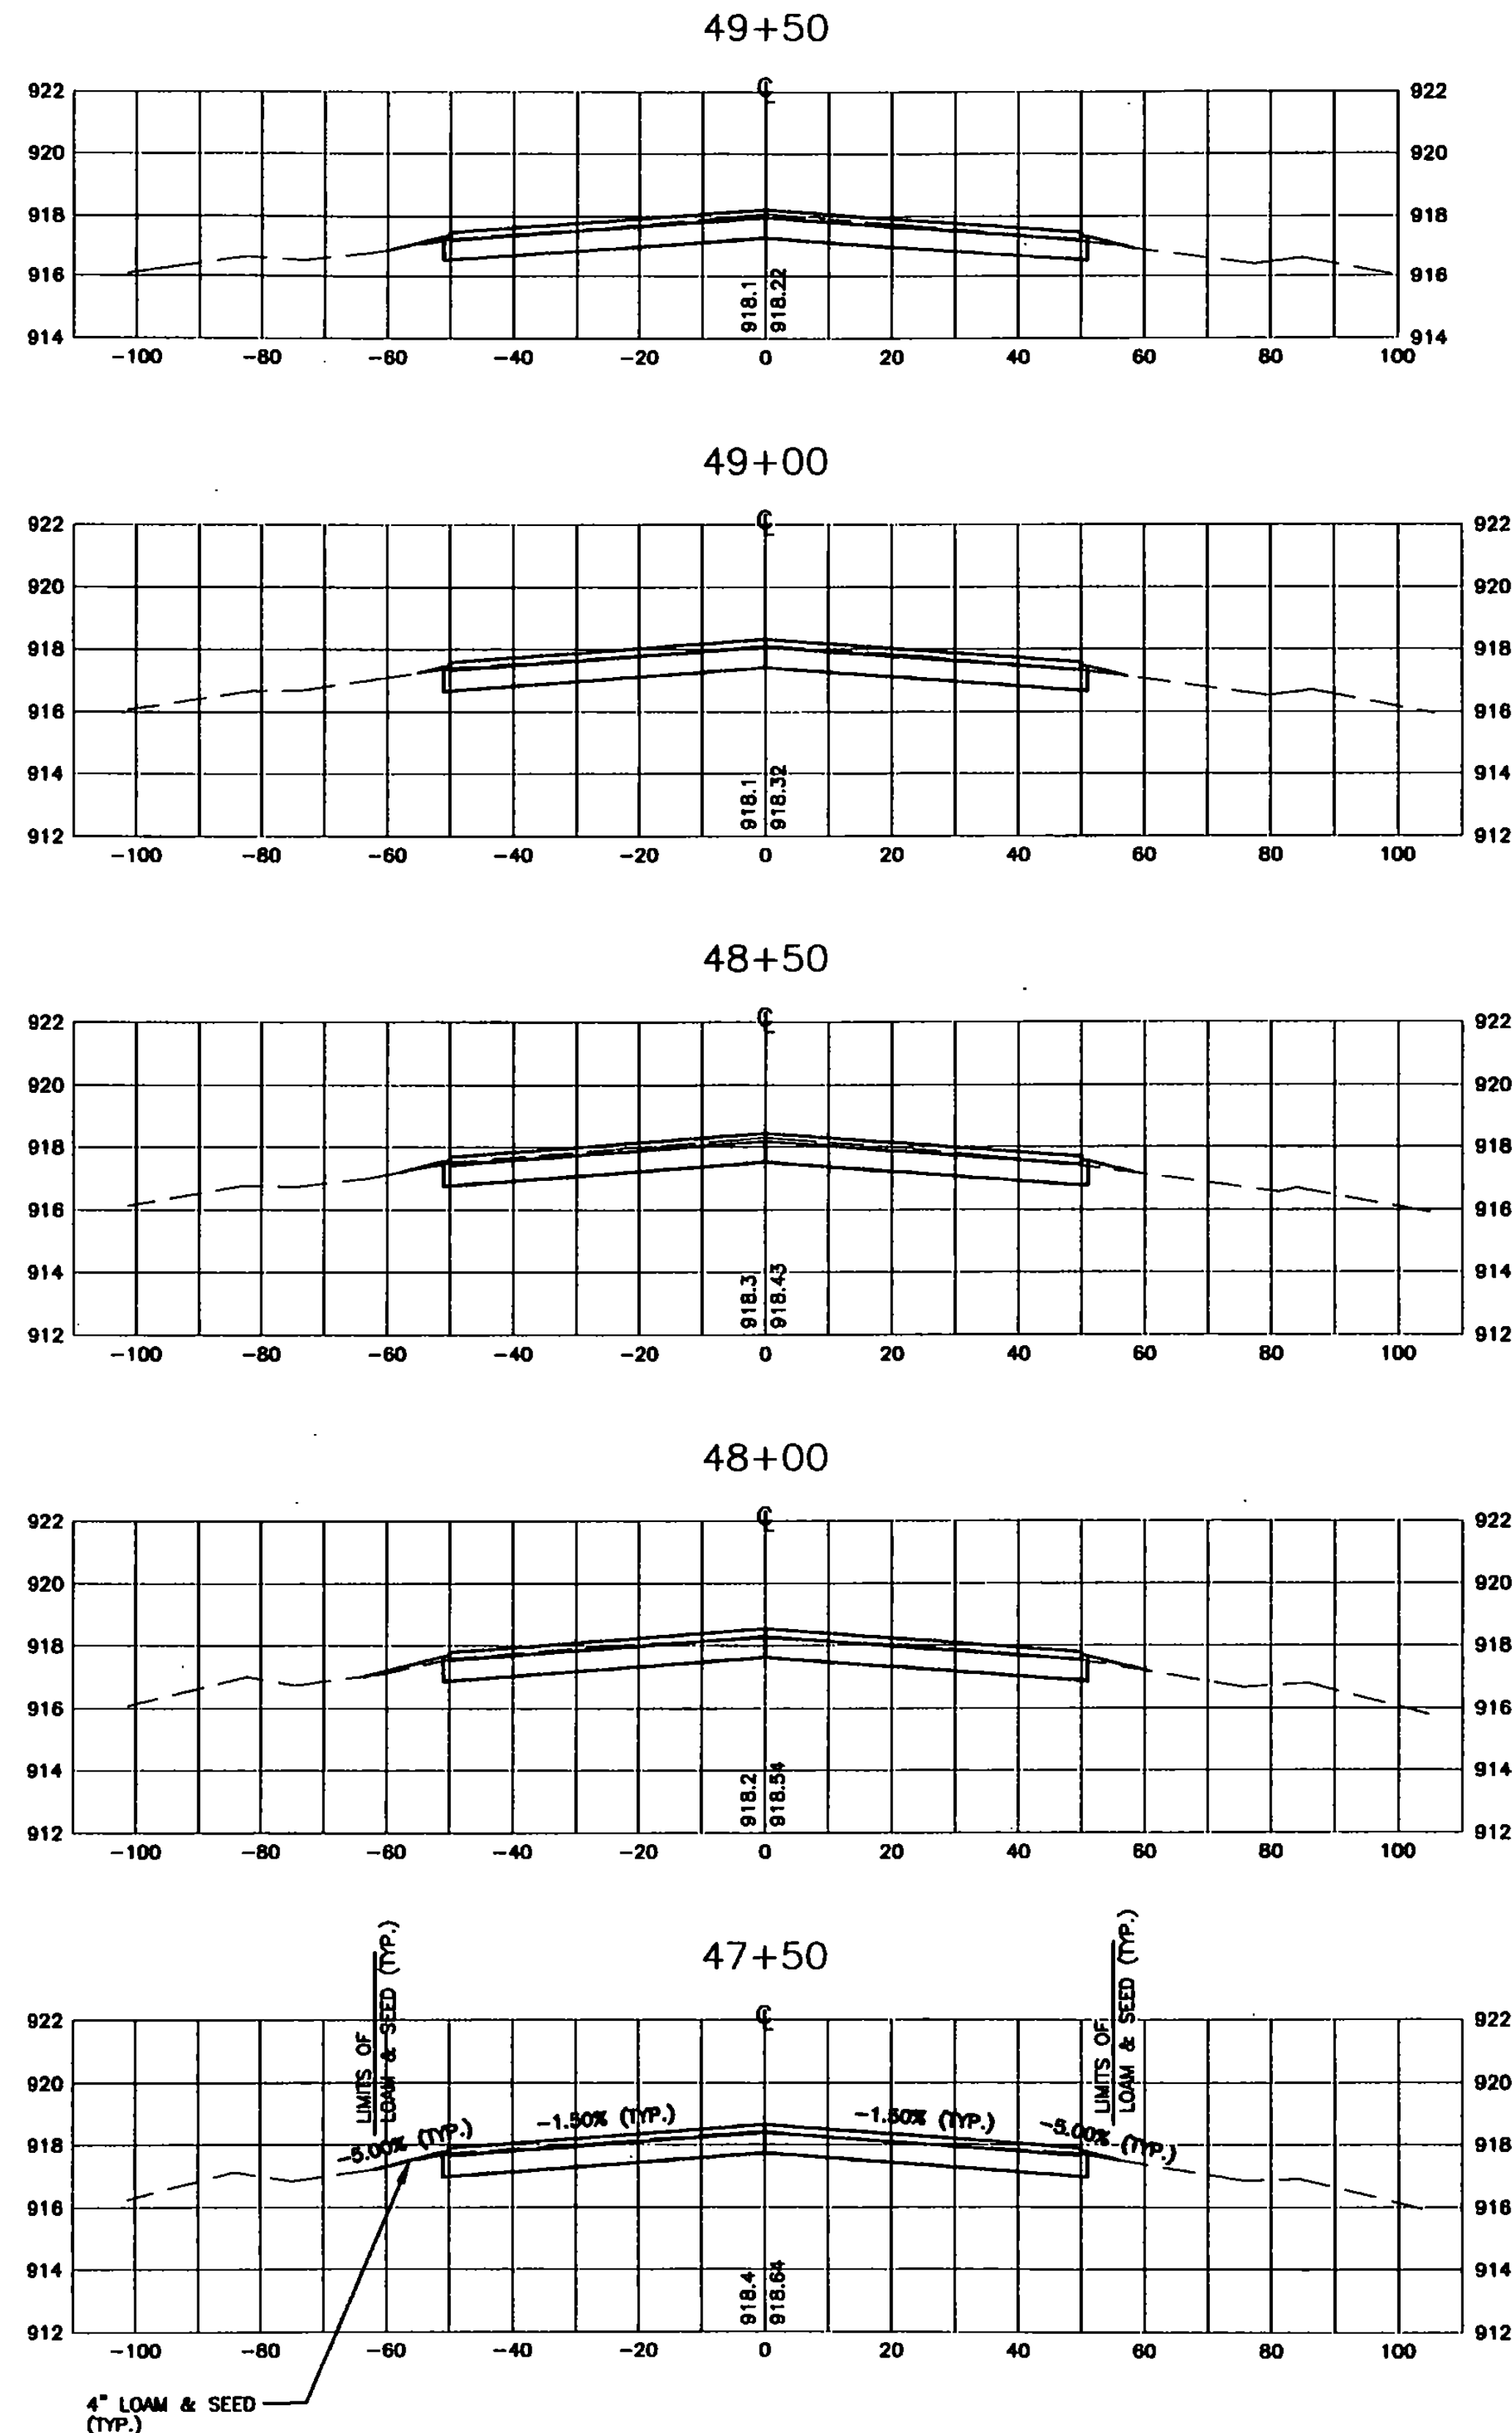

GRAPHIC SCALE

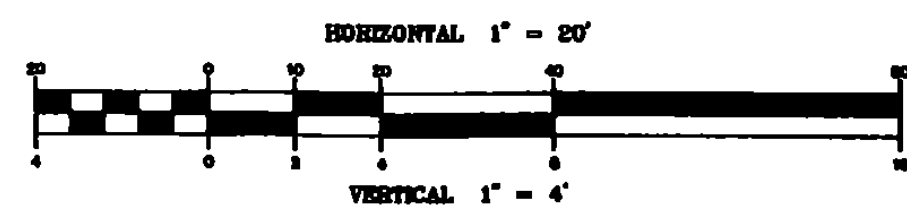

NO.	DATE	REVISIONS	BY	CHK'D
1	1/18/01	VADT COMMENTS AND SURVEY ADJUSTMENTS	MDL	SJR

DuBois & King
 engineers planning management development

VERMONT AGENCY OF
 TRANSPORTATION
 COVENTRY, VERMONT
 NEWPORT STATE AIRPORT
 RUNWAY 18-36 RECONSTRUCTION
 CROSS SECTIONS RW 18-36
 STA. 47+50 TO 52+00

DRAWN BY JJP	DATE MAR. 2000
CHECKED BY	PROJ. NO. N15500
PROJ. ENG. JAA	DRAW. NO. 1
SHEET XS-8	