

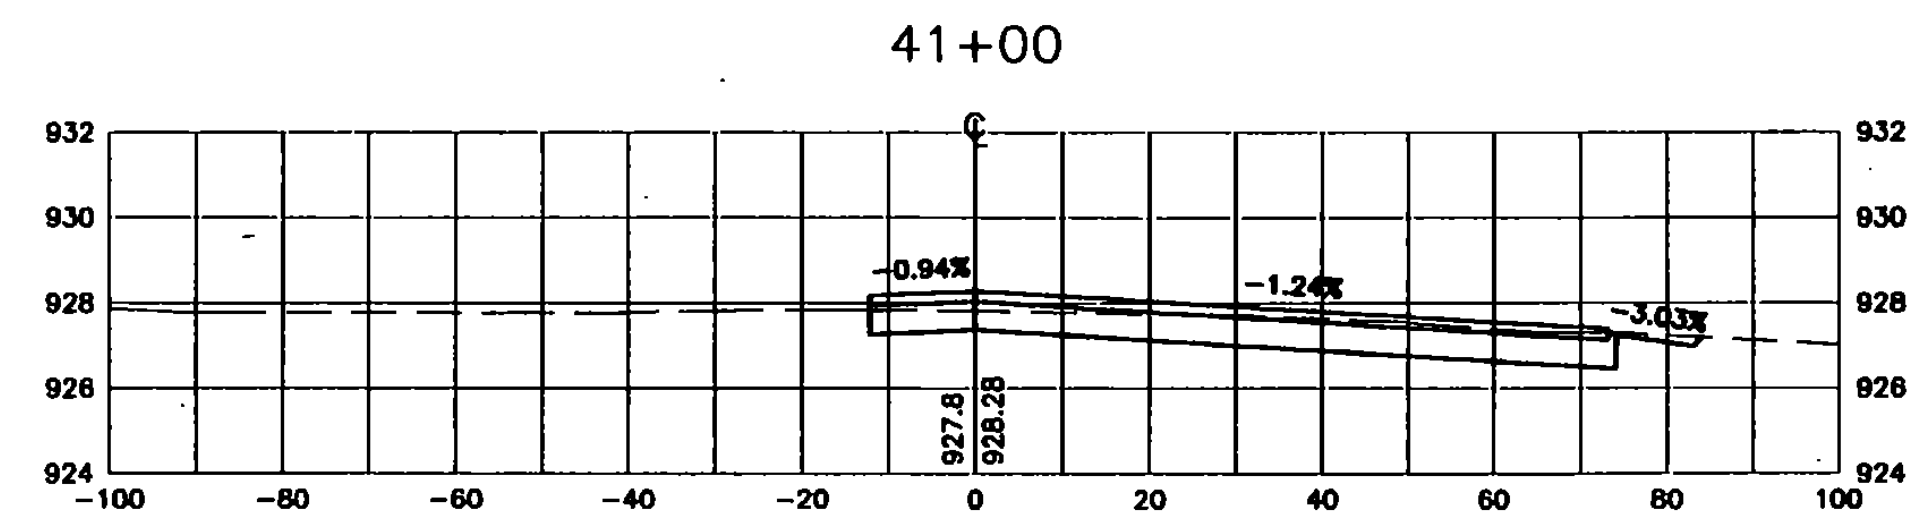
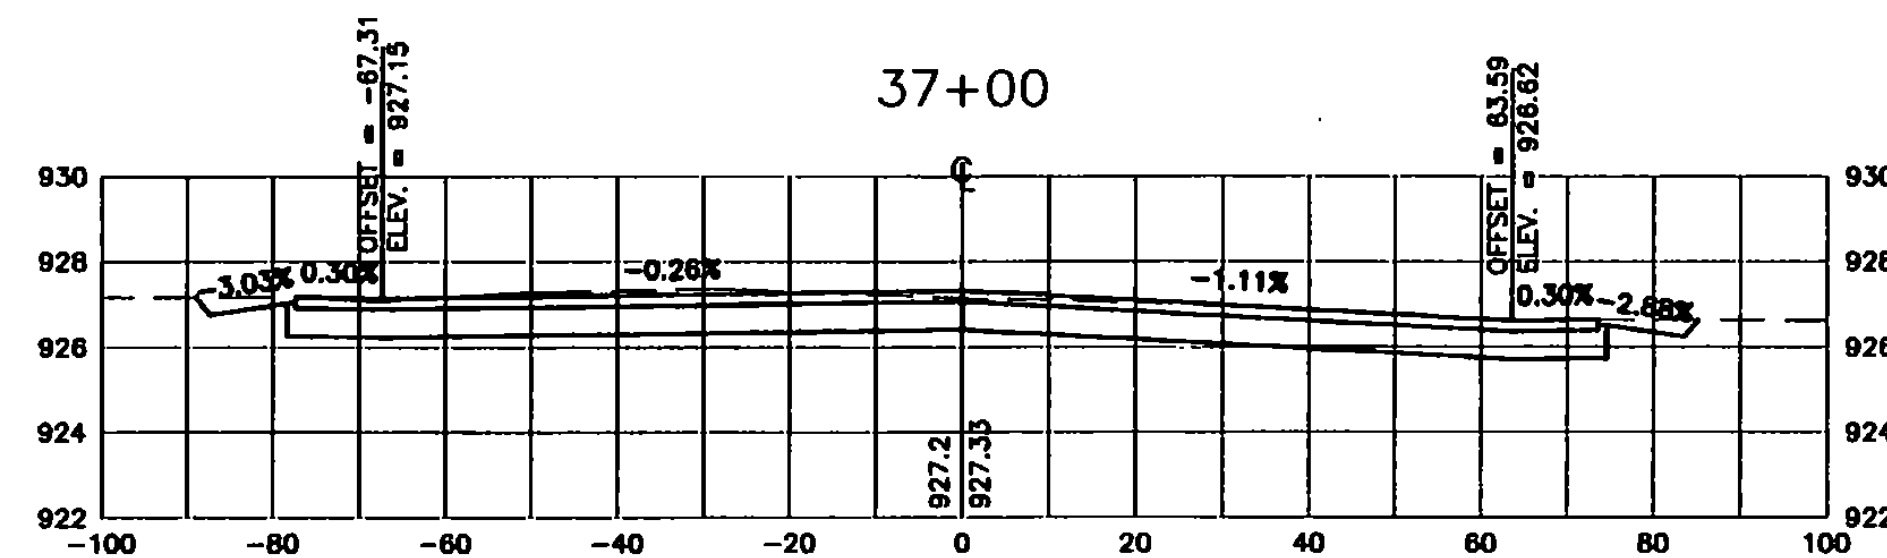
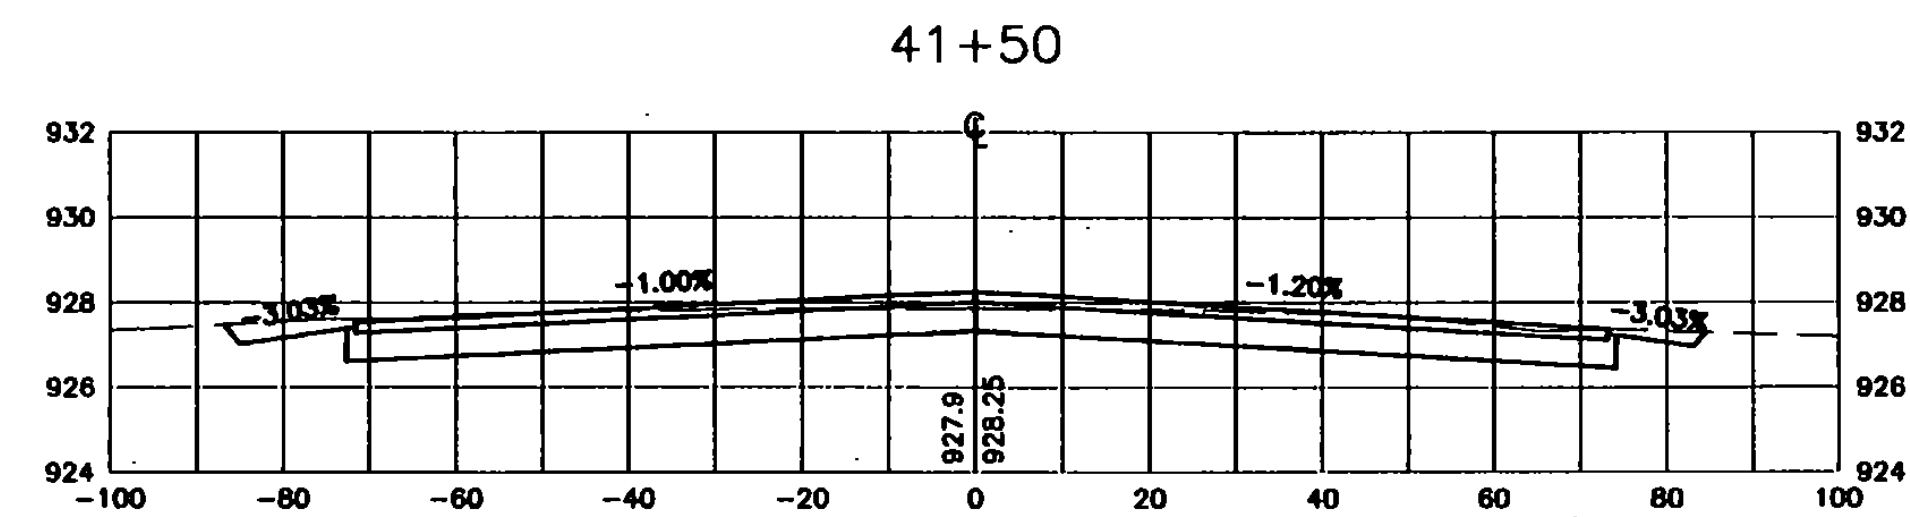
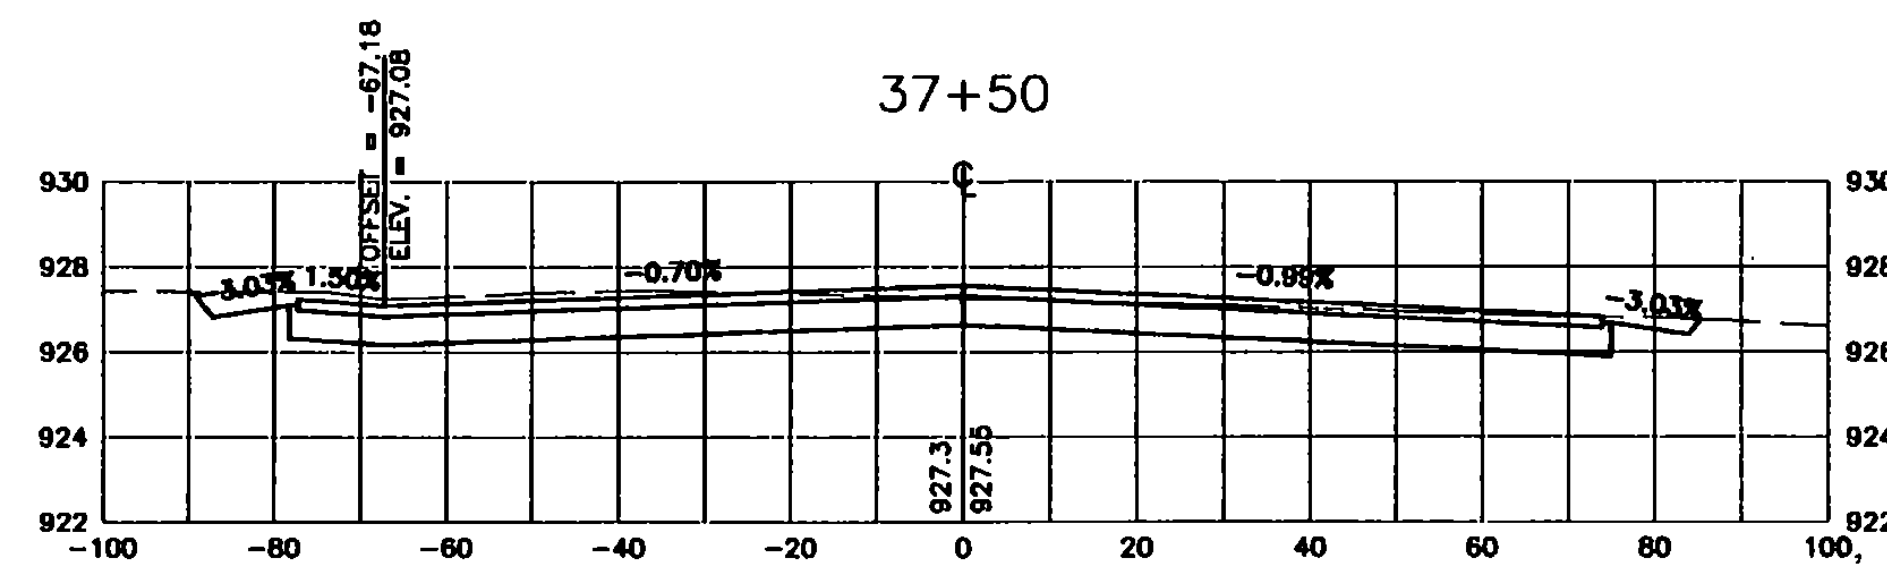
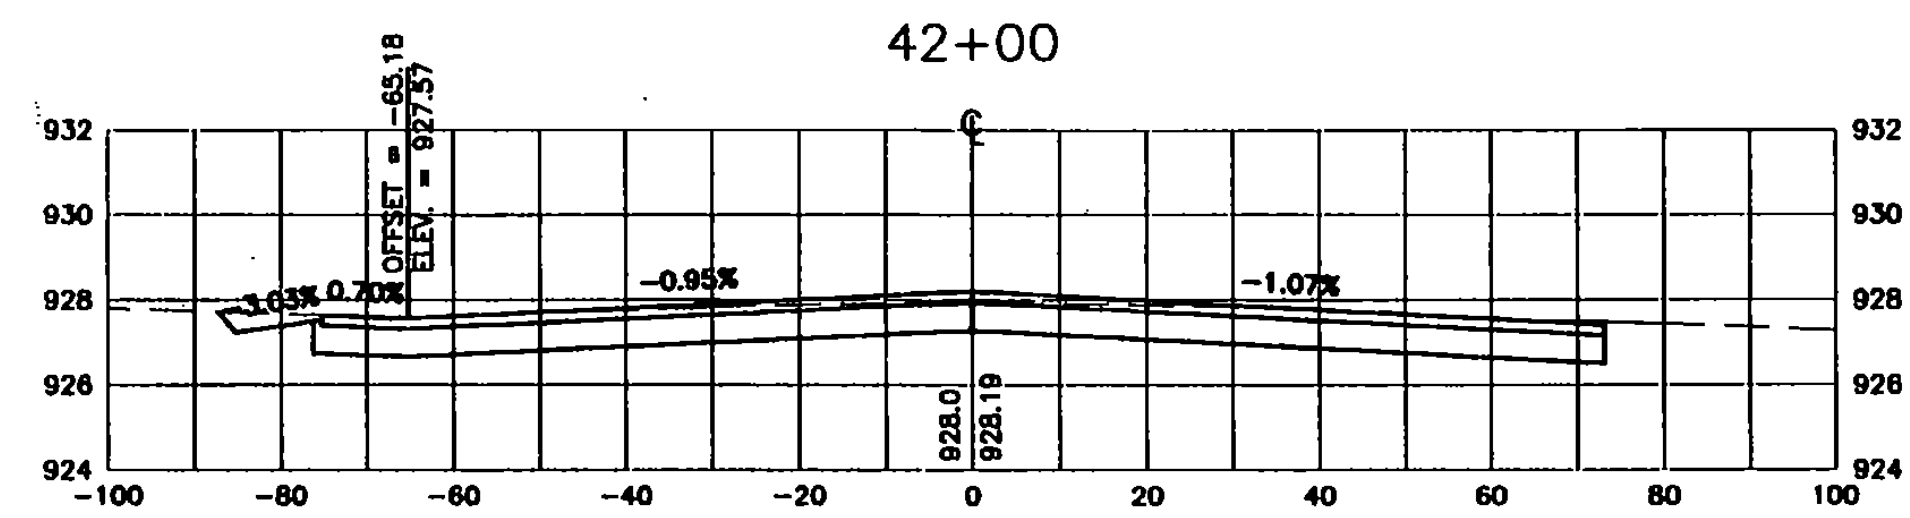
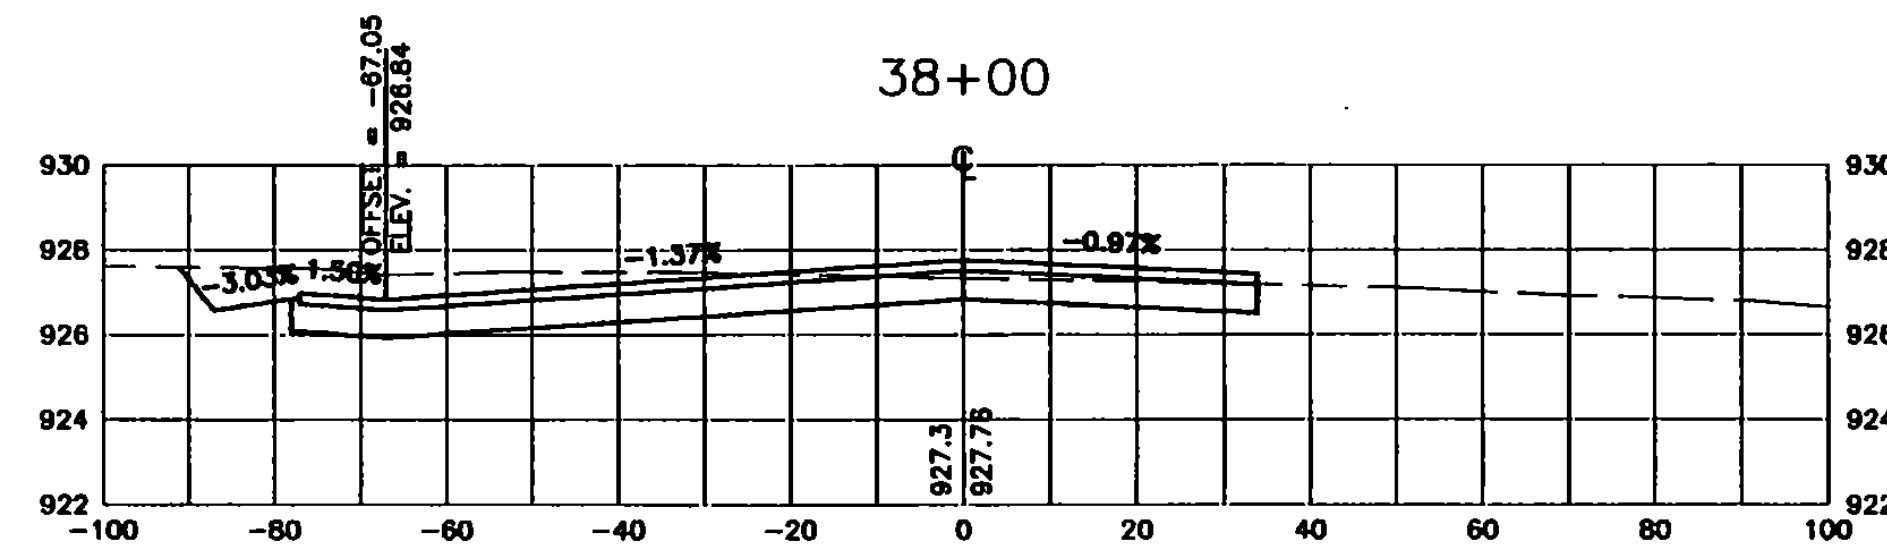
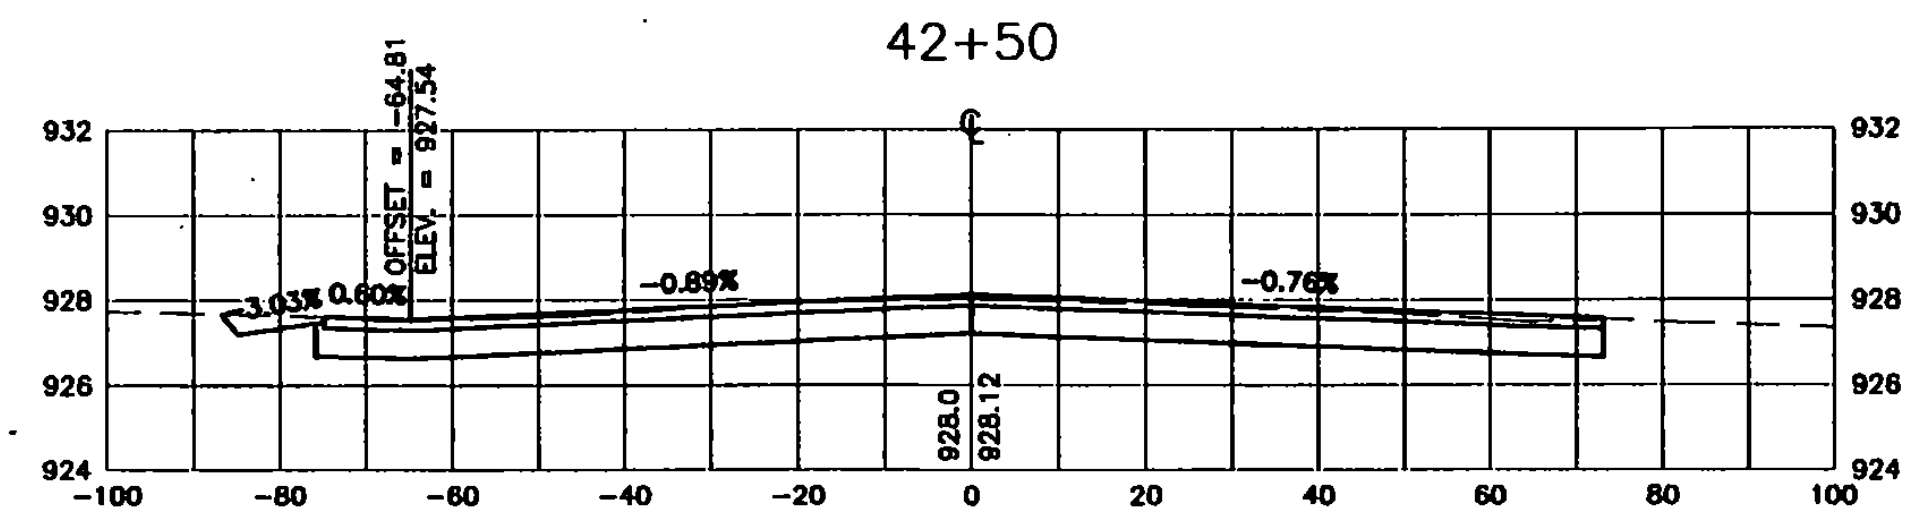


I:\N15500\F01\15500\F01.dwg P1 Feb 02 11:36:22 2001

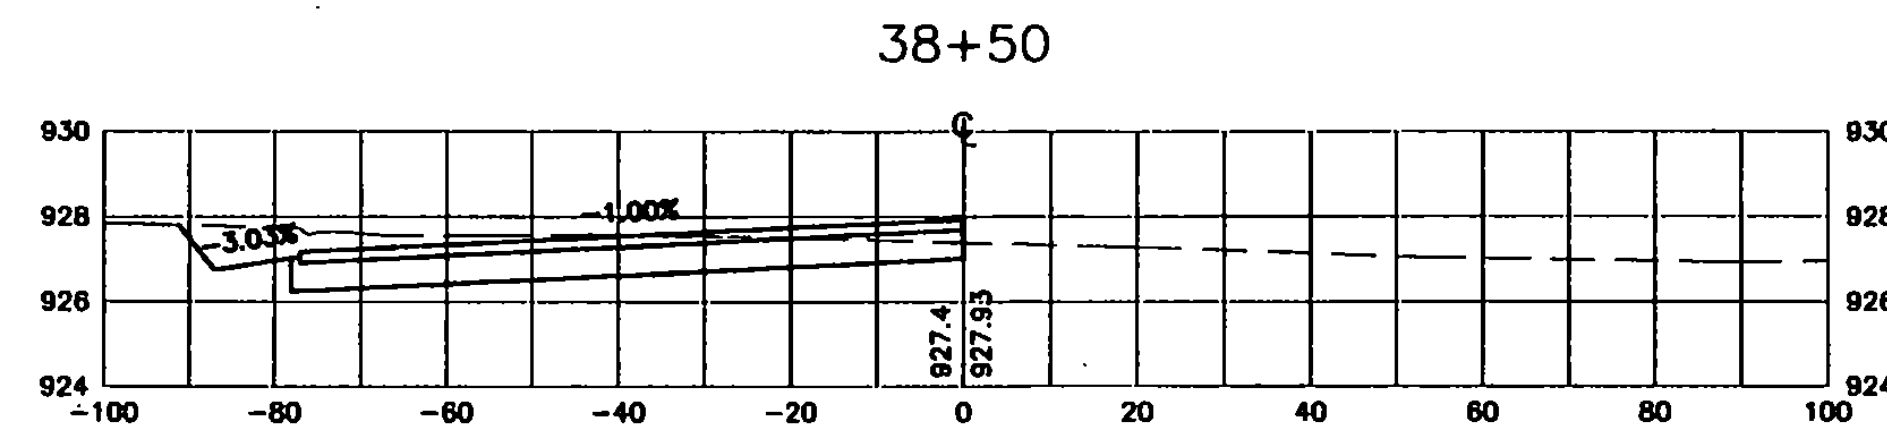

GRAPHIC SCALE

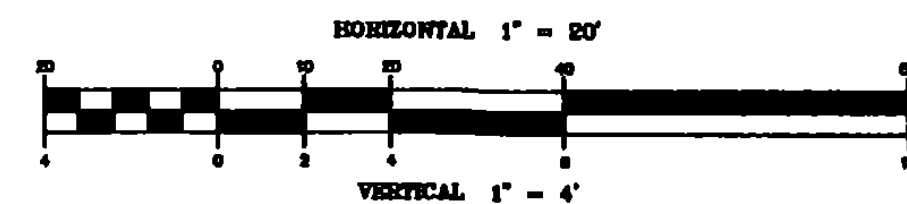

NO.	DATE	REVISIONS	BY	CHK'D
1	1/18/01	VAOT COMMENTS AND SURVEY ADJUSTMENTS	MDL	SJR

**DuBois & King**  
 engineering    planning    management    development

VERMONT AGENCY OF  
 TRANSPORTATION  
 COVENTRY, VERMONT  
 NEWPORT STATE AIRPORT  
 RUNWAY 18-36 RECONSTRUCTION  
 CROSS SECTIONS RW 5-23  
 STA. 37+00 TO 38+50 & 41+00 TO 42+50

DRAWN BY JJP	DATE MAR. 2000
CHECKED BY	PROJ. NO. N15500
PROJ. ENGR. JAA	DRAW. NO. 1
SHEET XS-9	