

STATE OF VERMONT

DEPARTMENT OF TRANSPORTATION

3-50-0012-03

AIR 03-2027

★ 1984

Construction
has been



Accepted for construction

By *Donald W. Hill* Resident Engineer

Date 1-7-87


PROPOSED IMPROVEMENT

TOWN OF: MORRISTOWN

COUNTY OF: LAMOILLE

ROUTE NO: MORRISVILLE - STOWE STATE AIRPORT

ROUTE CLASS: N/A

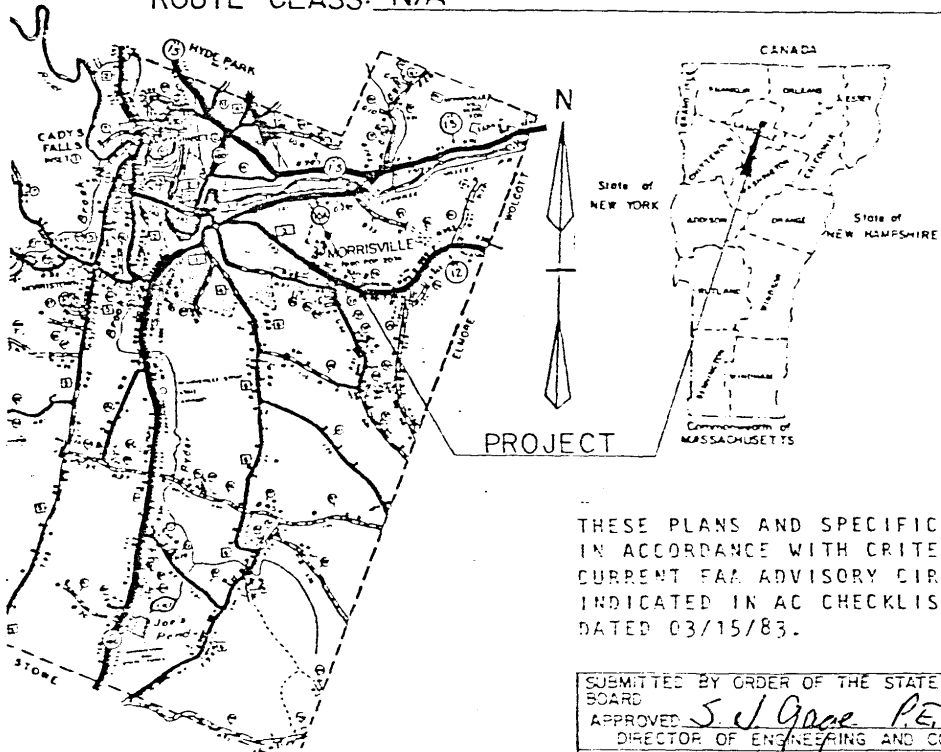

THESE PLANS AND SPECIFICATIONS ARE IN ACCORDANCE WITH CRITERIA IN CURRENT FAA ADVISORY CIRCULARS AS INDICATED IN AC CHECKLIST AC 00-2WV DATED 03/15/83.

SUBMITTED BY ORDER OF THE STATE TRANSPORTATION BOARD

APPROVED *S. J. Gagne PE* DATE *8-13-84*
DIRECTOR OF ENGINEERING AND CONSTRUCTION

DEPARTMENT OF TRANSPORTATION
FEDERAL HIGHWAY ADMINISTRATION

APPROVED _____ DATE _____

DIVISION ADMINISTRATOR

PROJECT NO. AIR 03-2027

INDEX OF SHEETS

- 1. TITLE SHEET
- 2. PROJECT DESCRIPTION AND LOCATION
- 3. PLAN SHEET

STATE OF VERMONT
 Department of Administration
 PURCHASING DIVISION
 MONTPELIER

REPORT OF VENDOR PERFORMANCE

CONTRACT NUMBER	DATE	DEPARTMENT	COMMODITY OR TYPE OF WORK	CONTRACTOR
14775C	10/19/88	Transportation	Aviation Fueling System	The DeCo Corp.

This section to be used for contracts involving labor and material.

DESCRIPTION OF PROJECT: Design and install an aviation fueling system at Franklin County Stat Airport.

- 1) Completion Date..... January 6, 1989.....
 - 2) Was Workmanship and Progress Satisfactory? Yes.....
 - 3) Should This Contractor Be Invited To Quote On Future Projects? Yes.....
- Final Approval and Inspection Made By Marvin Pfenning, Roy Nicholson,
John D. Clifford, and Robert McMullin
- Date January 17, 1989


This section to be used for purchase orders or contracts involving commodities.

- 1) Date of Contract Release Order or Purchase Order
 - 2) Date Delivery was Promised (If Promise Was Made By Contractor)
 - 3) Date Shipment Was Received
- Inspection Made By
- Date.....

REMARKS:

Please Return This Completed Form To:
 Purchasing Director, Montpelier, Vermont

PROJECT DESCRIPTION AND LOCATION

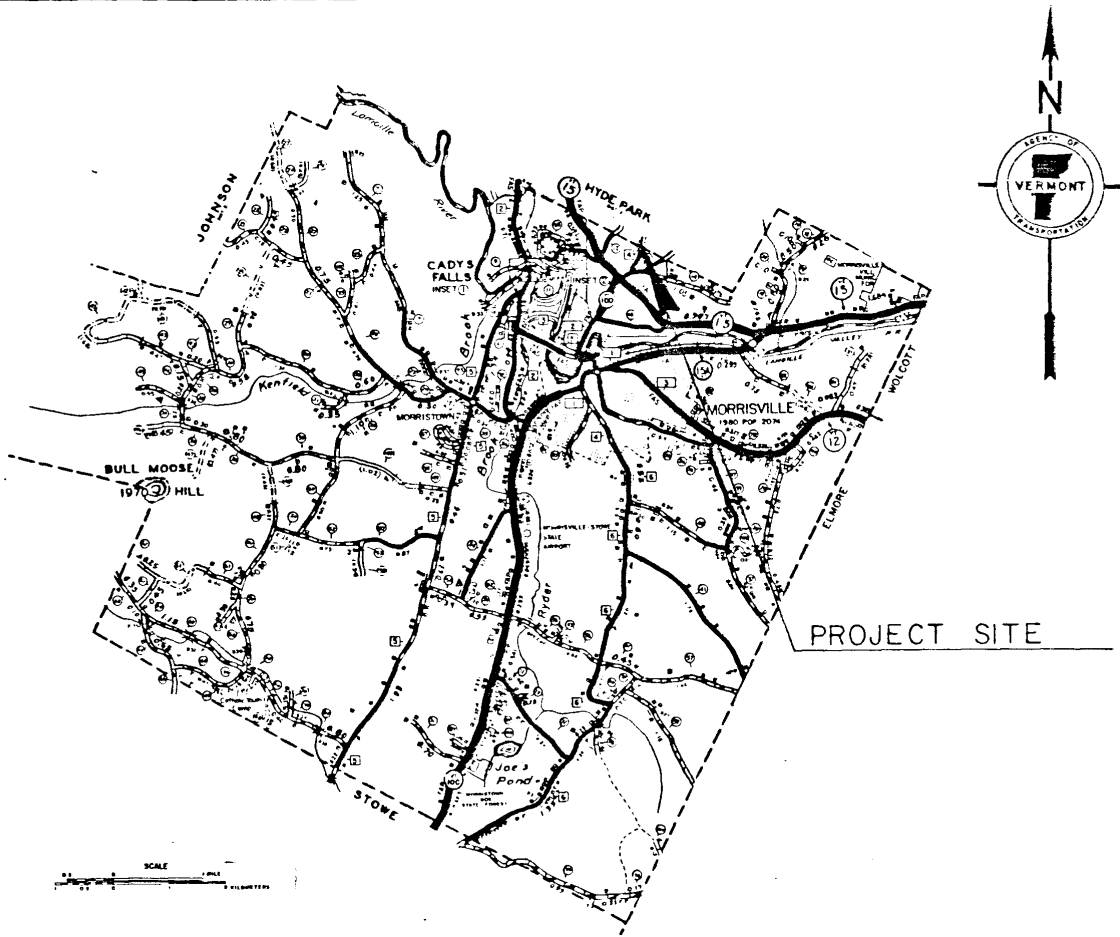

PROJECT SITE

PROJECT DESCRIPTION: REPLACEMENT OF EXISTING, NON-DIRECTIONAL BEACON AND BUILDING, INCLUDING ANTENNA AND UNDERGROUND COUNTERPOISE.

AS BUILT PLANS

I hereby certify that the construction required by the plans herein has been accomplished as indicated herein.

By *Daniel W. Hill*, Resident Engineer

Date 1-2-87

PROJECT MORRISVILLE-STOWE STATE AIRPORT

NO. AIR 03-2027

SHEET 2 OF 3 SHEETS

STATE OF VERMONT

AGENCY OF TRANSPORTATION AS BUILT PLANS

I hereby certify that the construction requirements and drawings has been accomplished in accordance with the specifications.

By *Donald W. Hill* Resident Engineer

Date *1-7-87*





PROPOSED IMPROVEMENT

TOWN OF: MORRISTOWN

COUNTY OF: LAMOILLE

ROUTE NO: MORRISVILLE - STOWE STATE AIRPORT

ROUTE CLASS: N/A

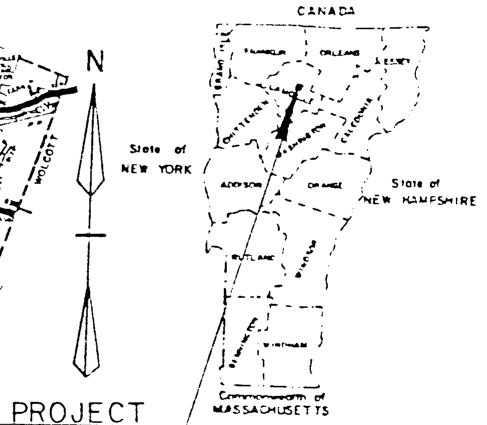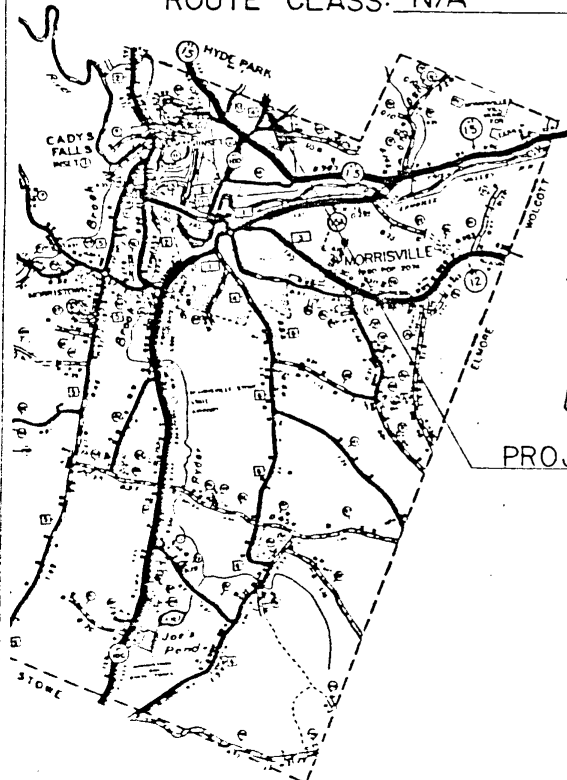

THESE PLANS AND SPECIFICATIONS ARE IN ACCORDANCE WITH CRITERIA IN CURRENT FAA ADVISORY CIRCULARS AS INDICATED IN AC CHECKLIST AC 00-2WW DATED 03/15/83.


SUBMITTED BY ORDER OF THE STATE TRANSPORTATION BOARD
APPROVED *S. J. Gage P.E.* DATE *8-13-84*
DIRECTOR OF ENGINEERING AND CONSTRUCTION
DEPARTMENT OF TRANSPORTATION
FEDERAL HIGHWAY ADMINISTRATION
APPROVED _____ DATE _____
DIVISION ADMINISTRATOR

INDEX OF SHEETS

- 1. TITLE SHEET
- 2. PROJECT DESCRIPTION AND LOCATION
- 3. PLAN SHEET

PROJECT NO. AIR 03-2027

PROJECT DESCRIPTION AND LOCATION

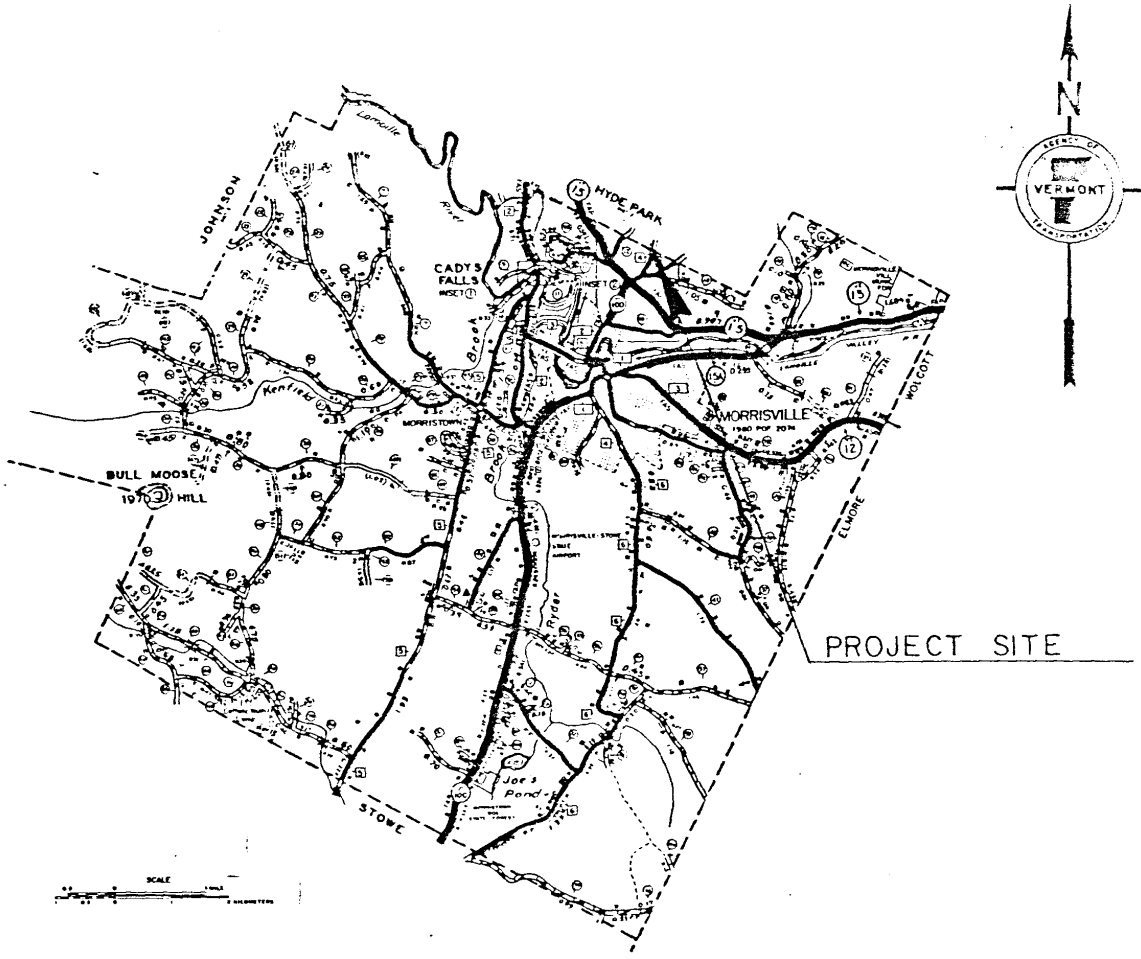

PROJECT DESCRIPTION: REPLACEMENT OF EXISTING, NON-DIRECTIONAL BEACON AND BUILDING, INCLUDING ANTENNA AND UNDERGROUND COUNTERPOISE.

AS BUILT PLANS

I hereby certify that the construction required by the drawings has been accomplished as indicated herein.

By *Daniel W. Kelly*, Resident Engineer


Date 1-7-87

STATE OF VERMONT
 AGENCY OF TRANSPORTATION



PROPOSED IMPROVEMENT
 NON-DIRECTIONAL BEACON REPLACEMENT

TOWN OF DERBY
 COUNTY OF ORLEANS
 NEWPORT STATE AIRPORT

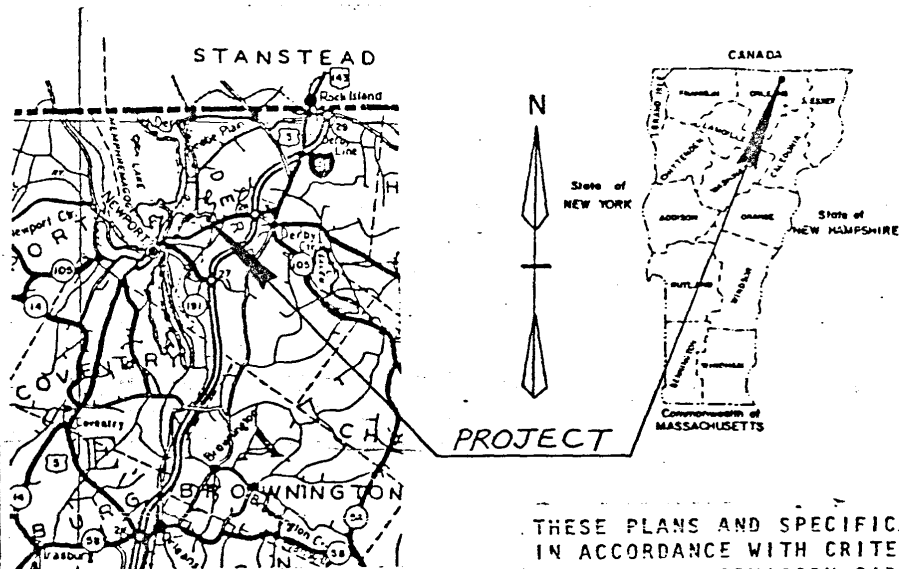

THESE PLANS AND SPECIFICATIONS ARE
 IN ACCORDANCE WITH CRITERIA IN
 CURRENT FAA ADVISORY CIRCULARS AS
 INDICATED IN AC CHECKLIST AC 00-2WW
 DATED 03/15/83.

INDEX OF SHEETS

AS BUILT PLANS

Where applicable, all the construction
 required by the set of drawings has been
 accomplished as indicated herein.

By Leon E. Mason Resident Engineer

Date 1/20/87

SUBMITTED BY ORDER OF THE STATE TRANSPORTATION BOARD


APPROVED _____ DATE _____
 DIRECTOR OF ENGINEERING AND CONSTRUCTION

DEPARTMENT OF TRANSPORTATION
 FEDERAL AVIATION ADMINISTRATION

APPROVED _____ DATE _____
 DIVISION ADMINISTRATOR

PROJECT NO. AIR 03-2028

SHEET 1 OF SHEETS

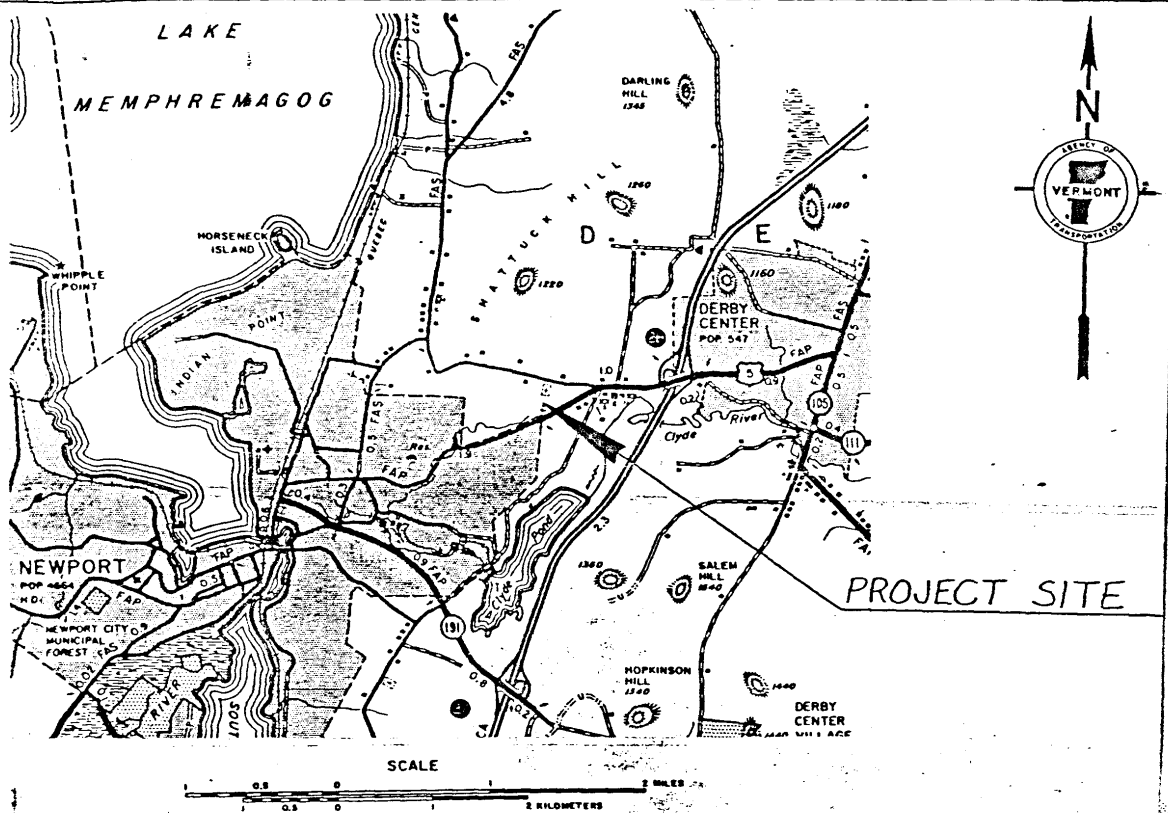

PROJECT DESCRIPTION: Replacement of existing non-directional beacon and building, including antenna and underground counterpoise.

AS BUILT PLANS

I hereby certify that all the construction required by the plans shown has been accomplished in detail.

By Lon E. Mason Resident Engineer
 Date 1/20/87




AS BUILT PLANS

The work shown on all the construction required by this set of drawings has been accomplished as indicated herein.

By Leon E. Mason Resident Engineer

Date 1/20/87

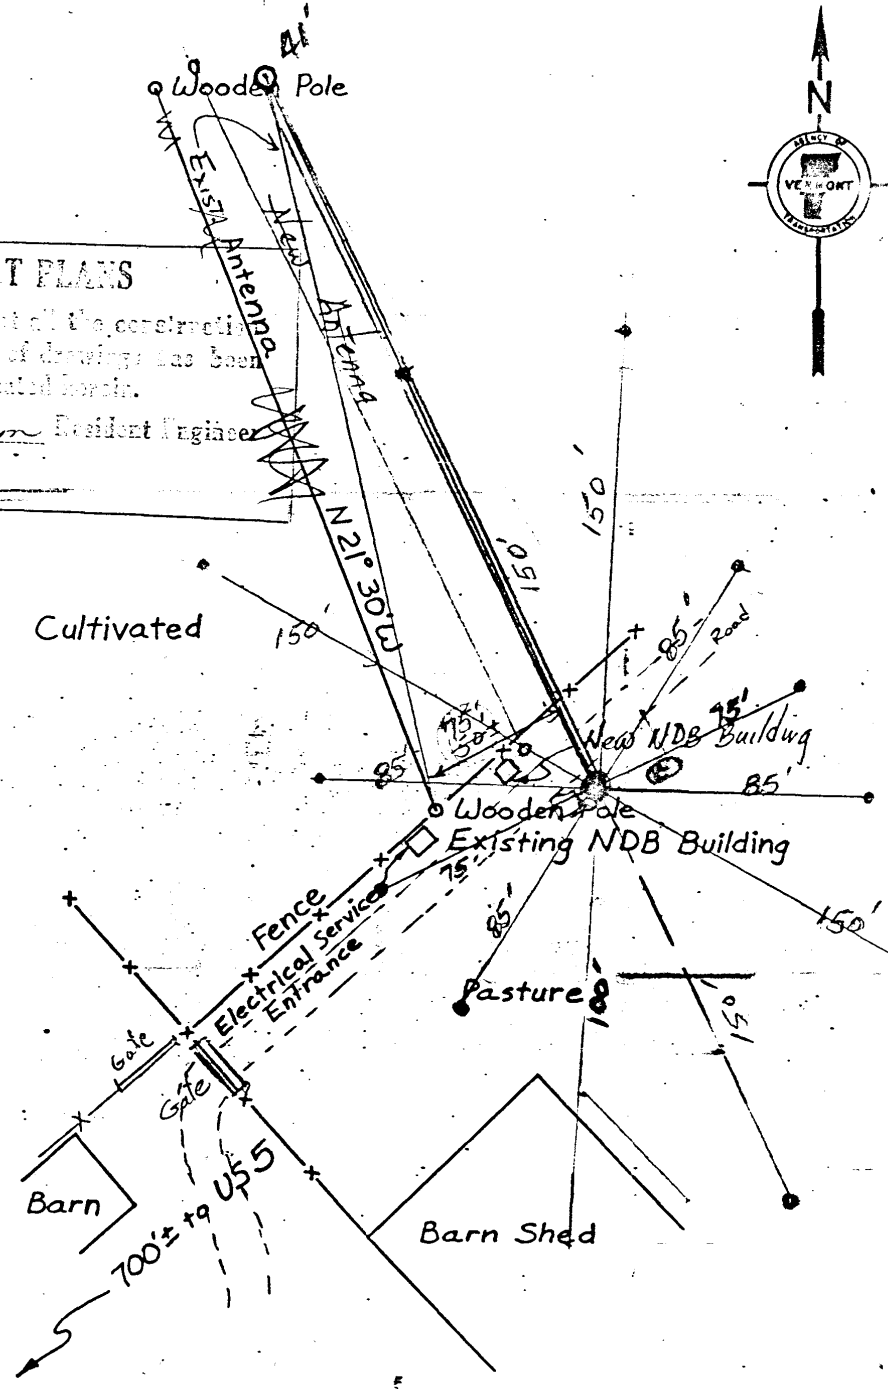

Palin Farm

AS BUILT PLANS

I hereby certify that all the construction required for this set of drawings has been accomplished as indicated on the plans.

By John E. Mason Resident Engineer


Date 1/20/87

16' x 16' embosd area

NEWPORT
STATE AIRPORT

NON-DIRECTIONAL
BEACON

12/84 EHI 1"=4'-0"

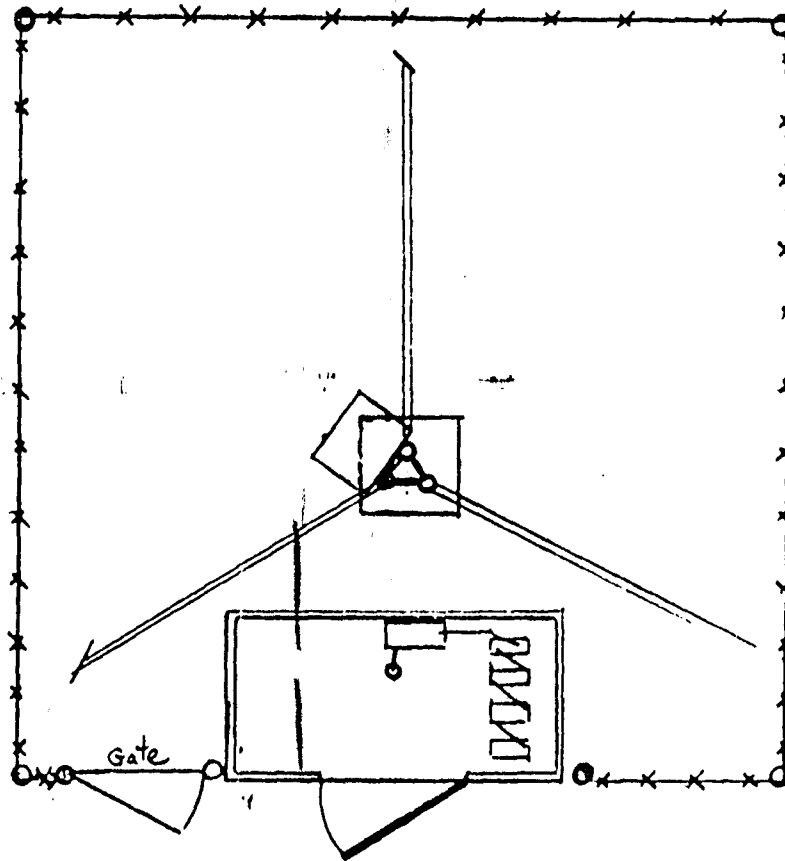

note: fence should be grounded on 3 sides. Antenna mast needs warning sign for electric charge.

"No Trespassing" signs on fence and building. Gate may be moved to Rt side of building

Cuy Anchor
40' from
Antenna


Alum. Building 7' x 3 1/2' x 7' high
concrete foundation

SOUTHERN AVIONICS COMPANY

MANUFACTURERS OF LOW FREQUENCY RADIOBEACONS AND ASSOCIATED PRODUCTS



INVERTED "L" ANTENNA


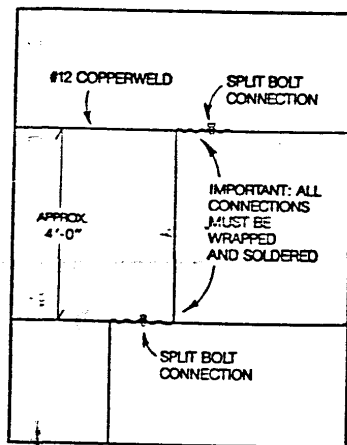



AS BUILT FLANS

I hereby certify that all the construction required by this certificate has been accomplished as indicated.

By *Don E. Mason* Resident Engineer

1/20/87

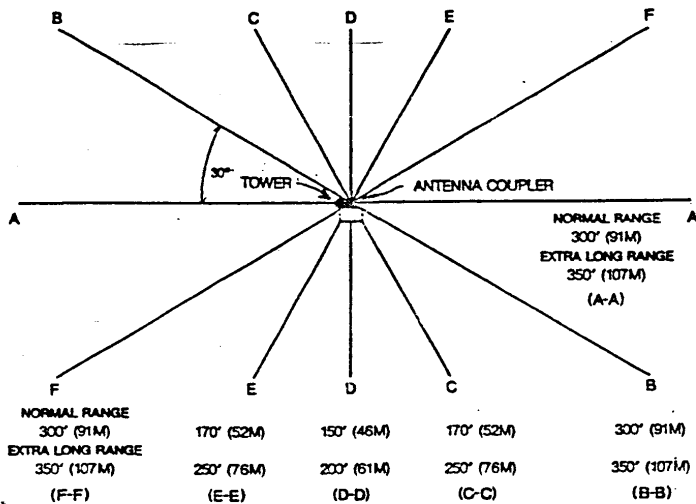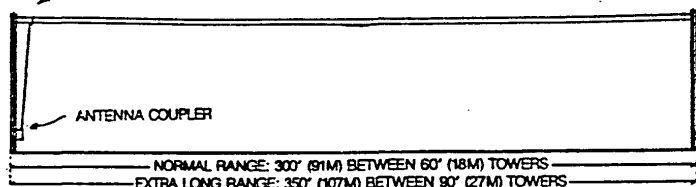

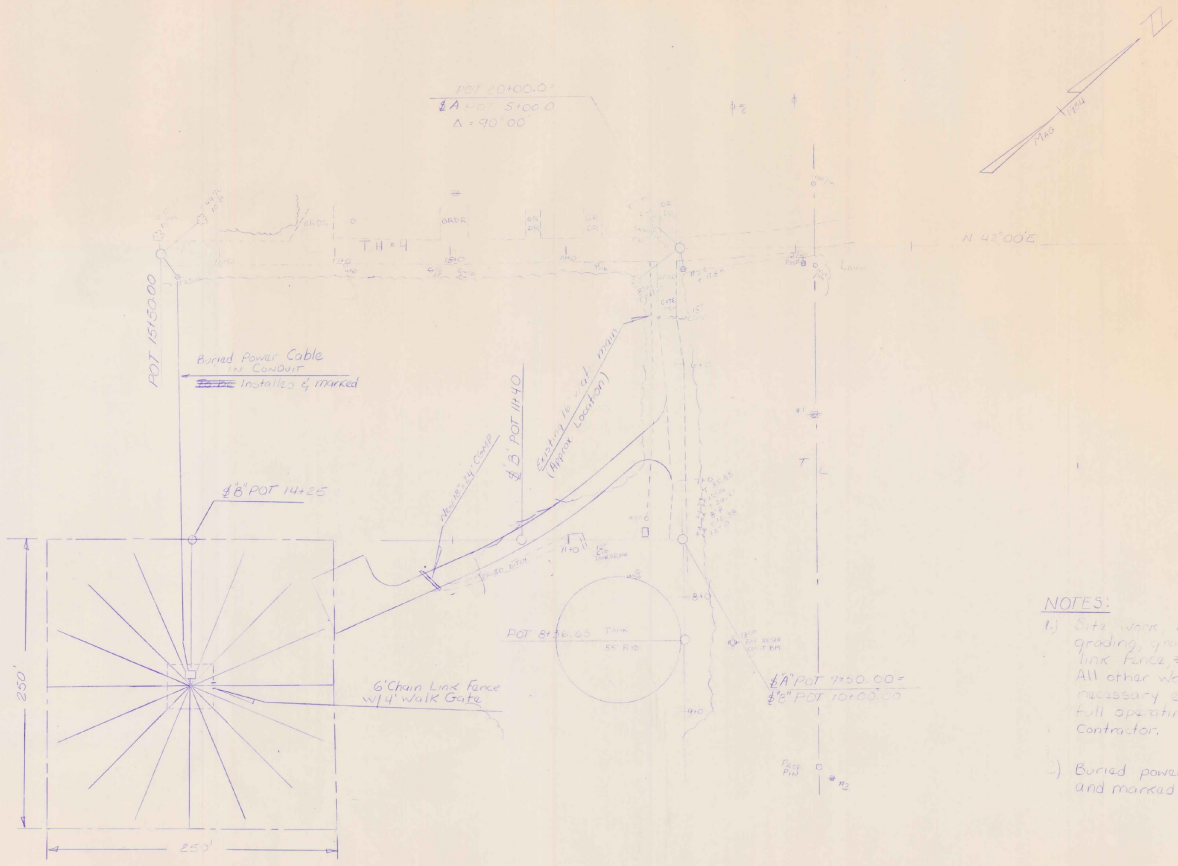

NOTES:

- 1) Site work, including clearing of trees and rough grading, ~~will be~~ ~~done~~ ~~by~~ ~~the~~ ~~contractor~~ ~~and~~ ~~is~~ ~~to~~ ~~be~~ ~~accomplished~~ ~~by~~ ~~the~~ ~~contractor~~. All other work of furnishing and installing all necessary equipment, complete and in place, in full operating condition ~~will be~~ ~~done~~ ~~by~~ ~~the~~ ~~contractor~~.
- 2) Buried power cable ~~will be~~ ~~run~~ ~~in~~ ~~conduit~~ and marked with appropriate safety warnings.



REVISIONS	

DATUM	_____
VERTICAL	_____
HORIZONTAL	_____

W. W. WALKER ENGINEERING
 1111 N. W. 11th St.
 Ft. Lauderdale, Florida 33304
 Installation of New Air Traffic Control System

SURVEYED BY	Carters	DATE	1/14
DRAWN BY	Atkins	DATE	1/14
TRACED BY	J. Atkins	DATE	1/14
PROJ. AER	NO. 03-2027		
SHEET	3	OF	3

50' x 50'
CONCRETE PAD

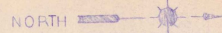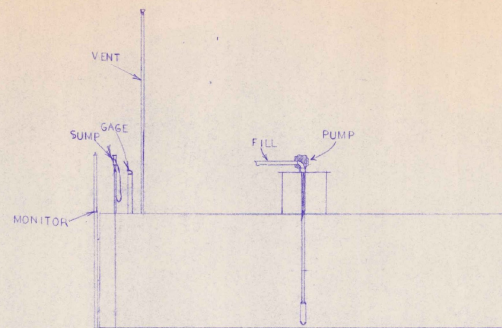

10000 GAL. TANK

PAVMENT

GRASS




UNDERGROUND ELECTRICAL CONDUIT

FENCE


PATIO AREA

OFFICE

STONE

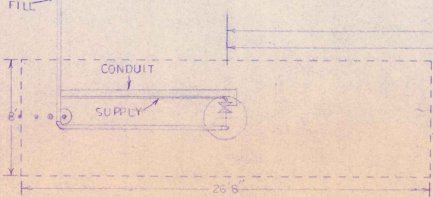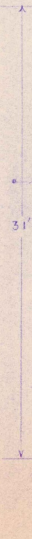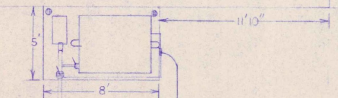

FOR FRANKLIN COUNTY AIRPORT		
SCALE: 1/4" = 1'	APPROVED BY:	DRAWN BY: M.R.H.
DATE: 1/5/89	REVISIONS:	
DECO CORP		
AS BUILT	DRAWING NUMBER	

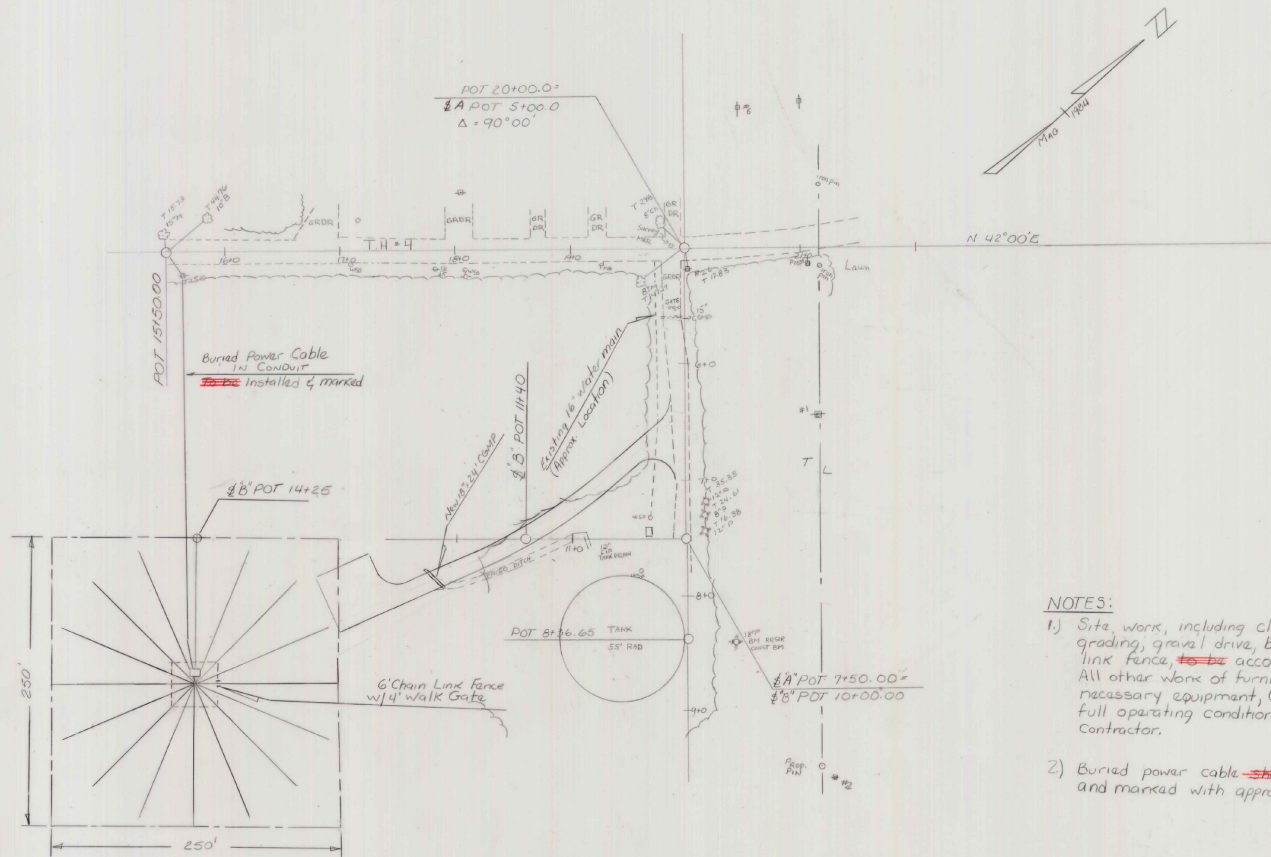


NOTES:

- 1) Site work, including clearing of trees and rough grading, gravel drive, buried power cable & chain link fence, ~~to be~~ accomplished by State Forces. All other work of furnishing and installing all necessary equipment, complete and in place, in full operating condition ~~shall be~~ done by the contractor.
- 2) Buried power cable ~~shall be~~ run in conduit and marked with appropriate safety warnings.

AS BUILT PLANS

I hereby certify that all the construction required by this set of drawings has been accomplished as indicated herein.
 By *Donald W. Jolly* Resident Engineer
 - 10 1-7-57

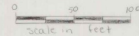

MORRISVILLE STATE AIRPORT
 Fed No. 3-50-0012-03
 Installation of New Non-Directional Beacon
 S.E. Moffat Nov. 1958

DATUM
 VERTICAL _____
 HORIZONTAL _____

SURVEYED BY *FANTONI* DATE *7/54*
 DRAWN BY *J. A. TRIMBLE* DATE *7/54*
 TRACED BY *J. A. TRIMBLE* DATE *7/54*

PROJ. AIR NO. 03-2027
 SHEET 3 OF 3

MORRISVILLE

VERMONT AGENCY OF
PLANNING DIVISION

Vermont Agency of
Transportation
Phase III - Interstate
#090303-01

INITIALS

Hanger 5019

RTATION