


2" BIT. CONC. PAV'T. TYPE III
(50 BLOW MARSHALL DESIGN)
12" SUBBASE

THICKNESS TOLERANCES
PAVEMENT 1/4" total depth
SUBBASE 1" total depth


GENERAL NOTES

- 1.) ALL DESIGN SHALL BE IN ACCORDANCE WITH THE VAOT "GUIDE FOR DEVELOPMENT OF BICYCLE FACILITIES", SEPT. 1994, OR LATEST REVISION.
- 2.) GEOTEXTILE FABRIC MAY BE USED BELOW THE SUBBASE MATERIAL WHEN CONDITIONS WARRANT.
- 3.) ALL SHARED USE PATHS SHALL MEET THE REQUIREMENTS OF THE AMERICANS WITH DISABILITIES ACT (ADA). REFER TO THE AMERICANS WITH DISABILITIES ACT ACCESSIBILITY GUIDELINES (ADAAG) FOR SPECIFIC DETAILS.
- 4.) ANY TREE ROOTS ENCOUNTERED WITHIN THE EXCAVATION LIMITS SHALL BE SAWCUT AND REMOVED. NO DIGGING UP OF STUMPS OR ROOTS SHALL BE ALLOWED. PAYMENT WILL BE SUBSIDIARY TO COMMON EXCAVATION.
- 5.) THE GRADED AREA SHALL BE EITHER OF THE TWO FOLLOWING CONDITIONS:
 - a. WHEN THERE IS A FENCE ADJACENT TO THE PATH, THE SHOULDER AREA SHALL BE PAVED TO THE SAME DEPTH AS THE PATH.
 - b. IN ALL OTHER AREAS, THE SHOULDER SHALL BE 2" FINE GRADED AGGREGATE SURFACE WITH A MAXIMUM STONE GRADATION OF 3/8".

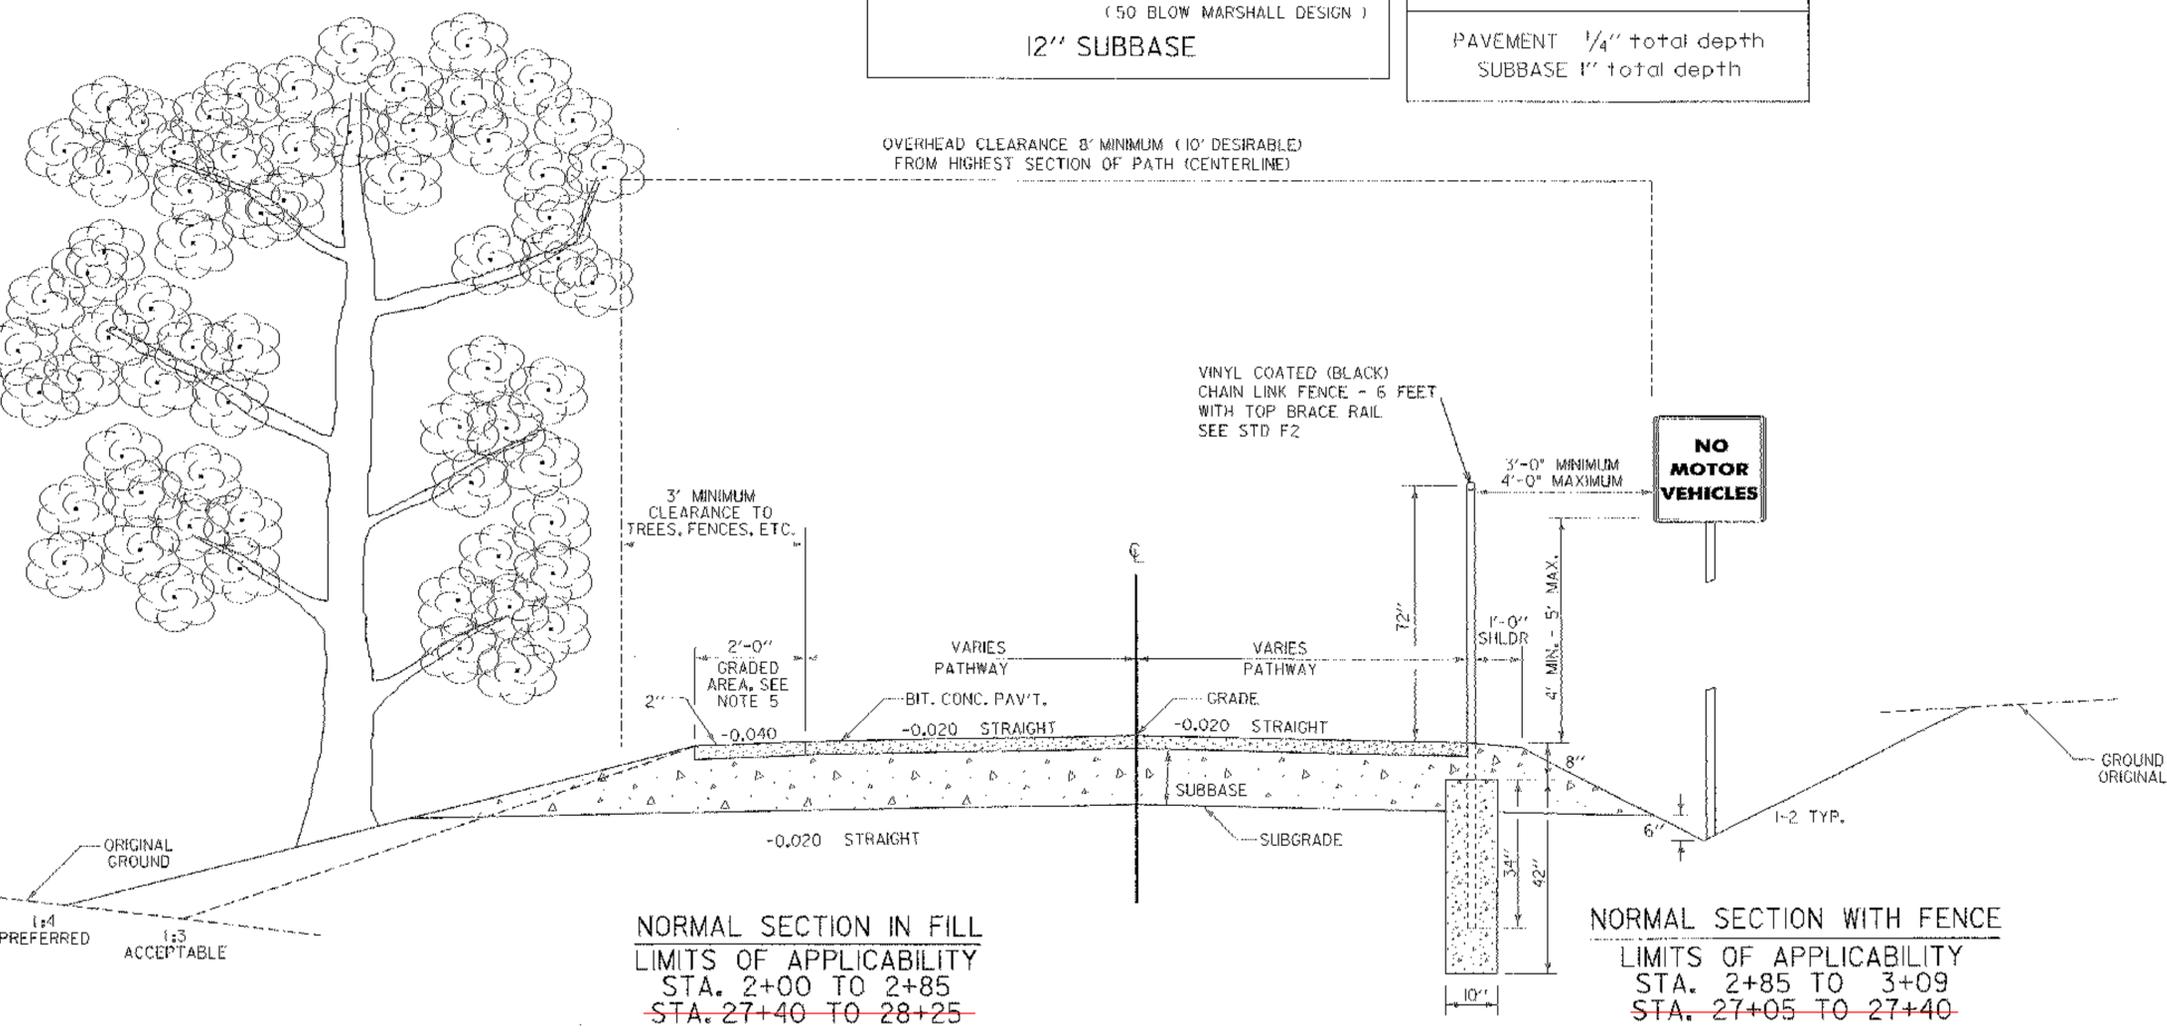

NORMAL SECTION IN FILL
LIMITS OF APPLICABILITY
STA. 2+00 TO 2+85
~~STA. 27+40 TO 28+25~~

NORMAL SECTION WITH FENCE
LIMITS OF APPLICABILITY
STA. 2+85 TO 3+09
~~STA. 27+05 TO 27+40~~

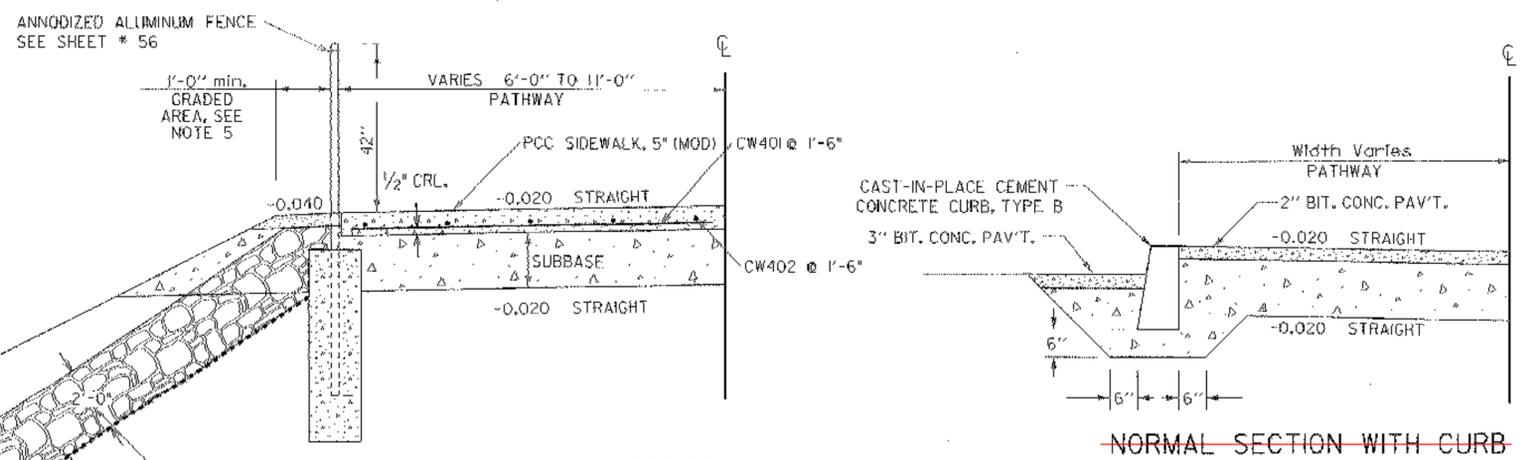

~~CAST IN PLACE CONCRETE SECTION W/ STEEP SIDESLOPES~~
LIMITS OF APPLICABILITY
STA. 8+75 TO 12+04.23

~~NORMAL SECTION WITH CURB~~
LIMITS OF APPLICABILITY
STA. 28+25 TO 28+62

SHARED USE PATH TYPICAL

PROJECT NAME:	BURLINGTON - COLCHESTER
PROJECT NUMBER:	STP Bike(45)
FILE NAME:	/str5/01f132/sf132typ.dgn
PROJECT LEADER:	C. Keller
DESIGNED BY:	G. Shongraw
PLOT DATE:	15-NOV-2002
DRAWN BY:	G. Shongraw
CHECKED BY:	M.E.M.
SHEET	3 OF 87

2'-0" DEEP 4'-0" WIDE STONE KEY SEE SECTIONS TYP.
GEOTEXTILE FABRIC
STONE FILL TYPE II