
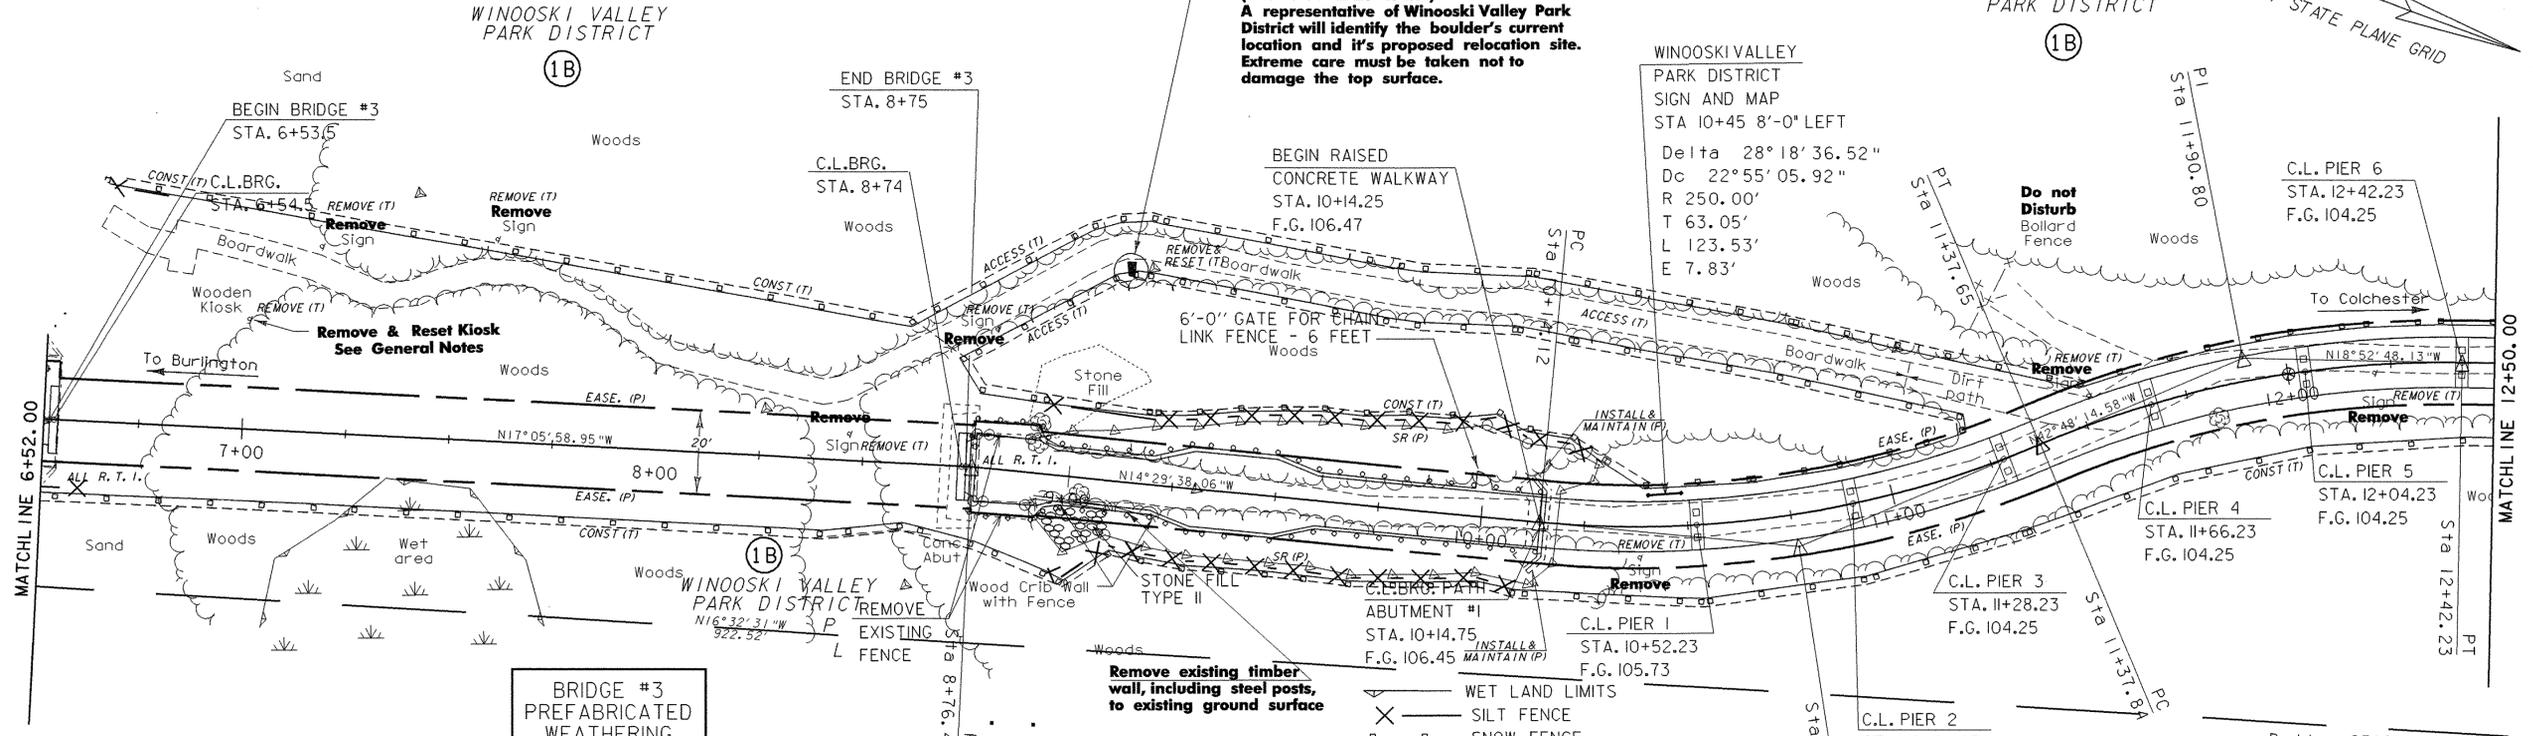


Prior to construction, the Winooski Valley Park District and Local Motion will coordinate to remove all the boardwalk sections, rubber mat, and the Colchester (northern) dock, out of the construction areas.

Remove & Relocate "Fossil Rock" (size is 53" x 26" x 12")
A representative of Winooski Valley Park District will identify the boulder's current location and it's proposed relocation site. Extreme care must be taken not to damage the top surface.


WINOOSKI VALLEY PARK DISTRICT

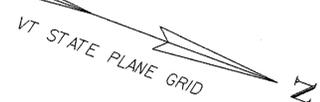

BRIDGE #3
PREFABRICATED
WEATHERING
STEEL TRUSS


Remove existing timber wall, including steel posts, to existing ground surface

WET LAND LIMITS
X SILT FENCE
□ SNOW FENCE
NO CONSTRUCTION PERSONNEL OR EQUIPMENT ALLOWED OUTSIDE THESE LIMITS WITHOUT WRITTEN PERMISSION FROM THE PARK DISTRICT.

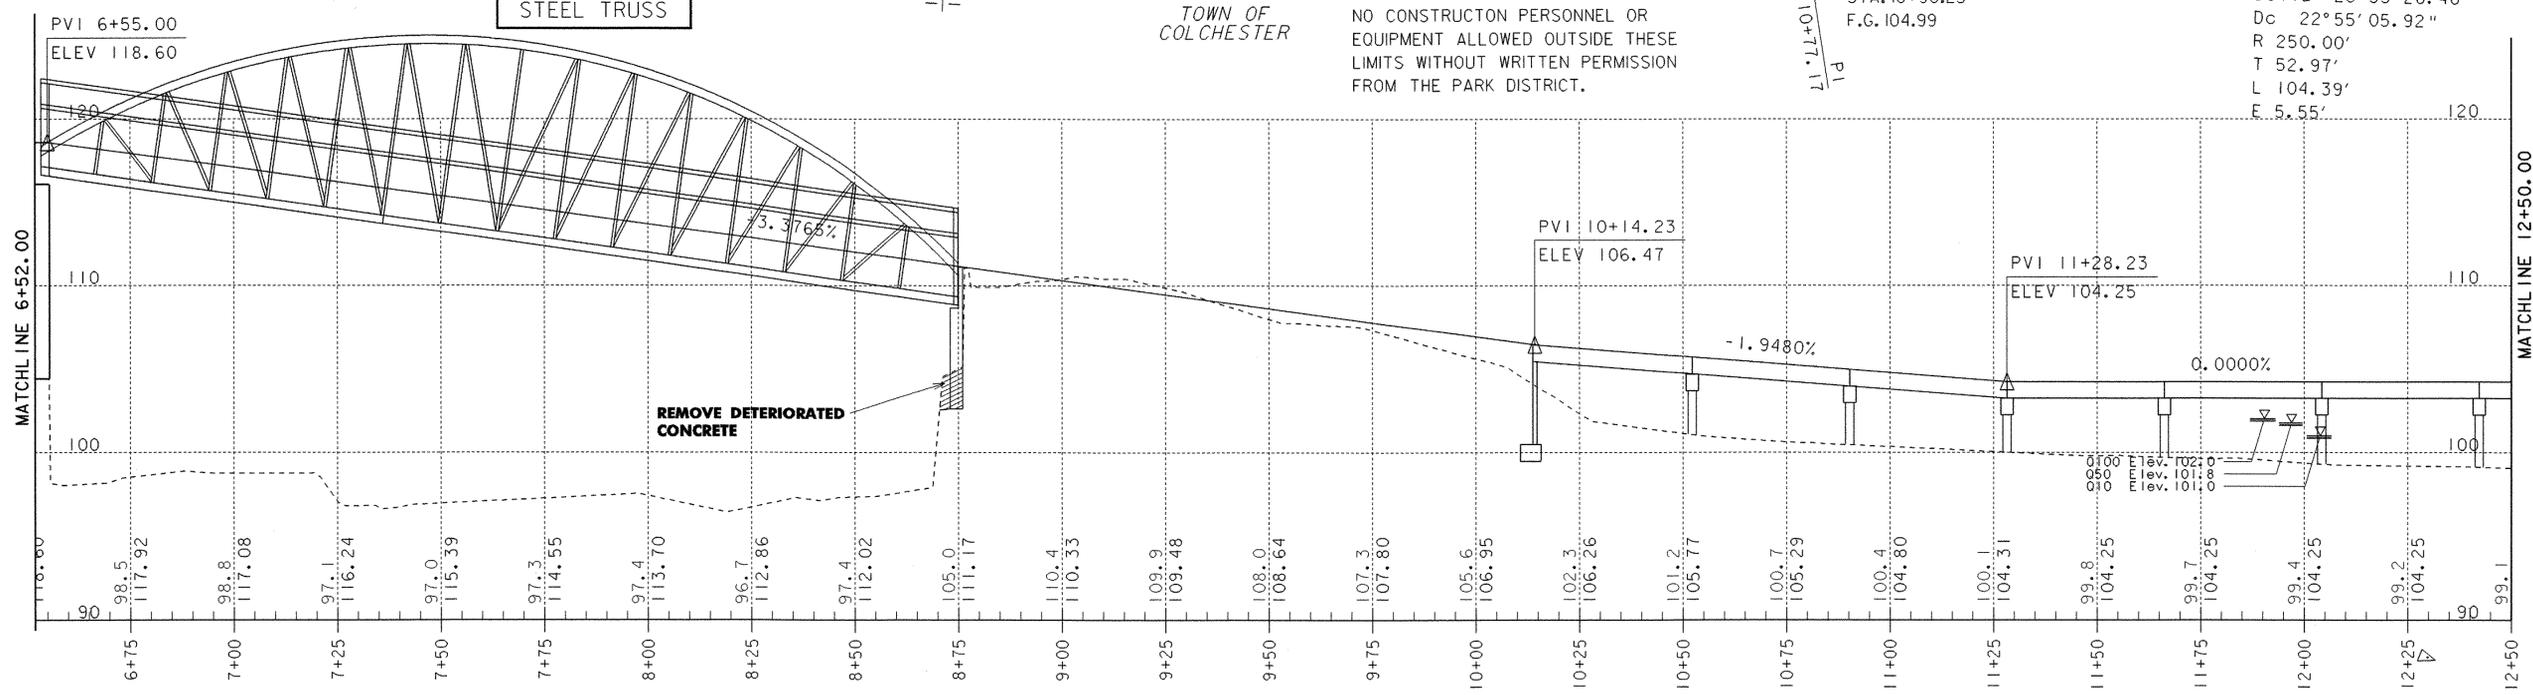

LINES SHOWN ON THIS PLAN AS EXISTING PROPERTY LINES P/L ARE BELIEVED TO BE ACCURATE BUT SHOULD NOT BE RELIED UPON FOR PURPOSES UNRELATED TO THE CITY OF BURLINGTON AND TOWN OF COLCHESTER'S ACQUISITION OF LAND AND RIGHTS FOR THIS PROJECT.

**FOR R.O.W.
USE ONLY**

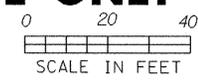

PROJECT NAME:	Burlington - Colchester
PROJECT NUMBER:	STP Bike(45)
FILE NAME:	str5\01f132\sf132bdr.dgn
PROJECT LEADER:	C. Keller
DESIGNED BY:	M. Evans-Mongeon
R. O. W. SHEET 6 OF 9 SHEETS	
PLOT DATE:	15-NOV-2002
DRAWN BY:	G. Shangraw
CHECKED BY:	
SHEET 17 OF 87	