


- WET LAND LIMITS
- SILT FENCE
- SNOW FENCE
- NO CONSTRUCTION PERSONNEL OR EQUIPMENT ALLOWED OUTSIDE THESE LIMITS WITHOUT WRITTEN PERMISSION FROM THE PARK DISTRICT.

**FOR R.O.W. USE ONLY**

LINES SHOWN ON THIS PLAN AS EXISTING PROPERTY LINES P/L ARE BELIEVED TO BE ACCURATE BUT SHOULD NOT BE RELIED UPON FOR PURPOSES UNRELATED TO THE CITY OF BURLINGTON AND TOWN OF COLCHESTER'S ACQUISITION OF LAND AND RIGHTS FOR THIS PROJECT.

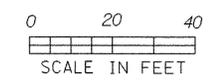

PROJECT NAME:	Burlington - Colchester
PROJECT NUMBER:	STP Bike(45)
FILE NAME:	str5\01f132\sf132bdr.dgn
PROJECT LEADER:	C. Keller
DESIGNED BY:	M. Evans-Mongeon
R. O. W. SHEET 7 OF 9 SHEETS	
PLOT DATE:	15-NOV-2002
DRAWN BY:	G. Shangraw
CHECKED BY:	
SHEET 18 OF 87	