

Prior to construction, the Winooski Valley Park District and Local Motion will coordinate to remove all the boardwalk sections, rubber mat, and the Colchester (northern) dock, out of the construction areas.



Remove & Relocate "Fossil Rock" (size is 53" x 26" x 12")
A representative of Winooski Valley Park District will identify the boulder's current location and it's proposed relocation site. Extreme care must be taken not to damage the top surface.

WINOOSKI VALLEY PARK DISTRICT SIGN AND MAP
STA 10+45 8'-0" LEFT

Delta 28° 18' 36.52"
Dc 22° 55' 05.92"
R 250.00'
T 63.05'
L 123.53'
E 7.83'



STA. 6+51.5
2.0 FT. LEFT
INTERPRETIVE SIGN
PT #2

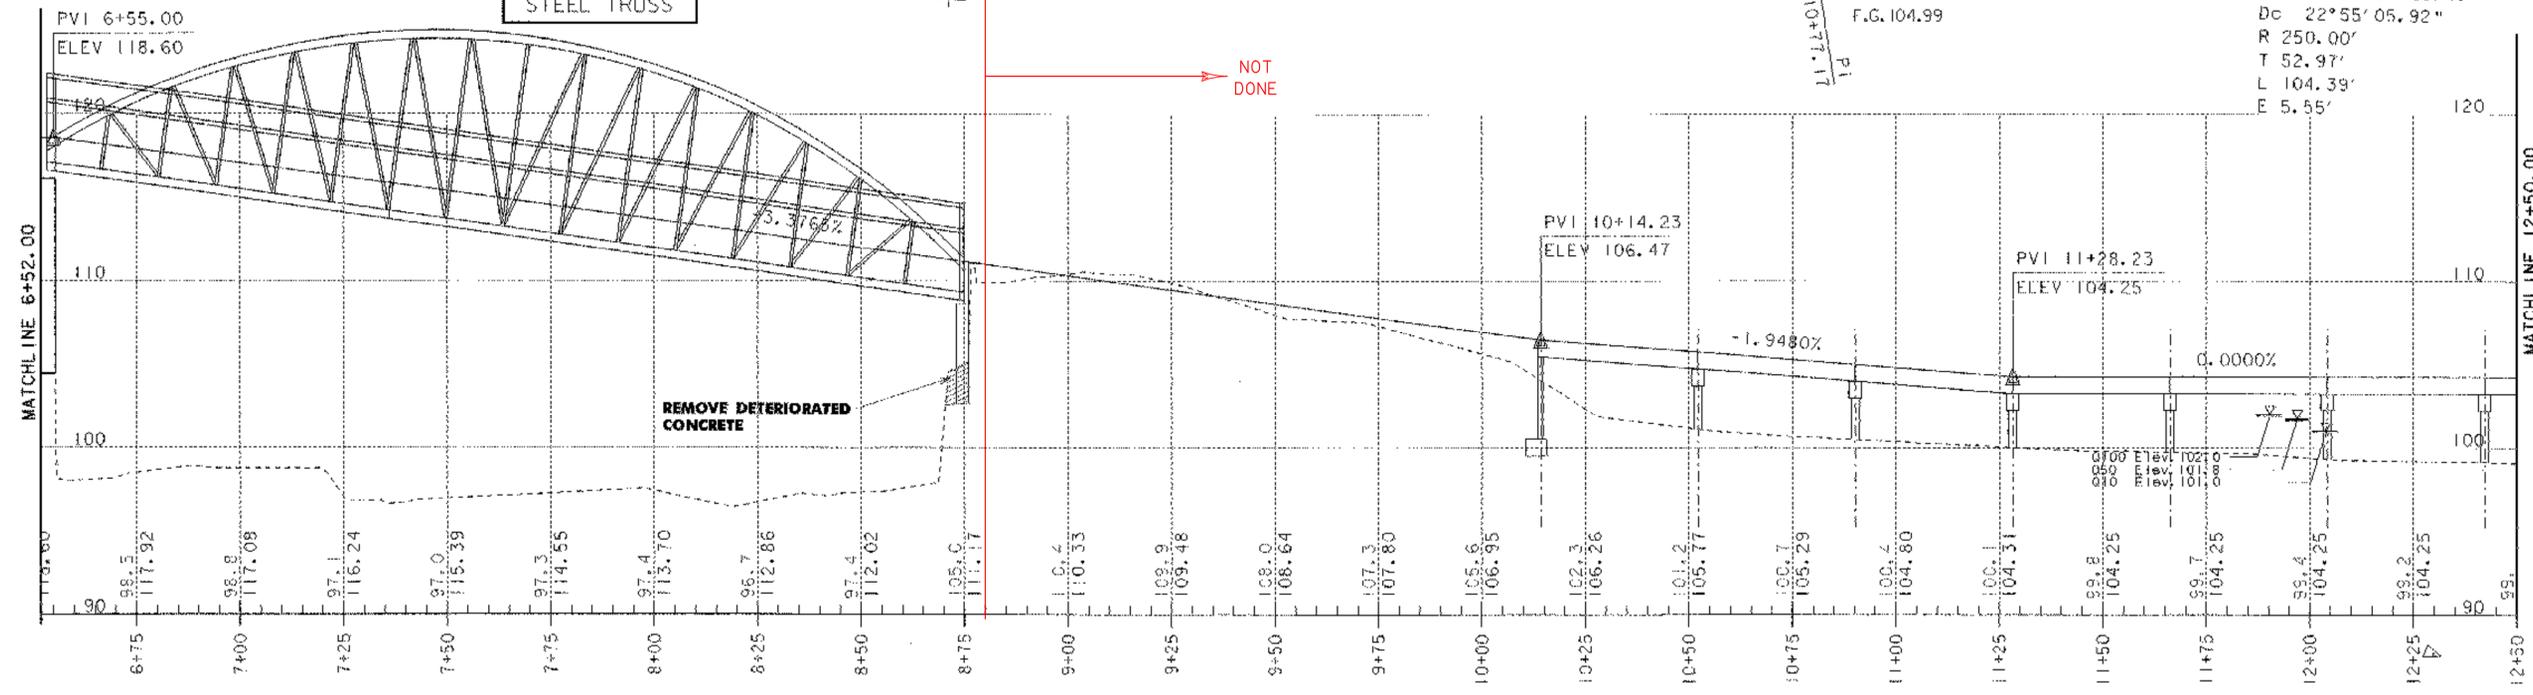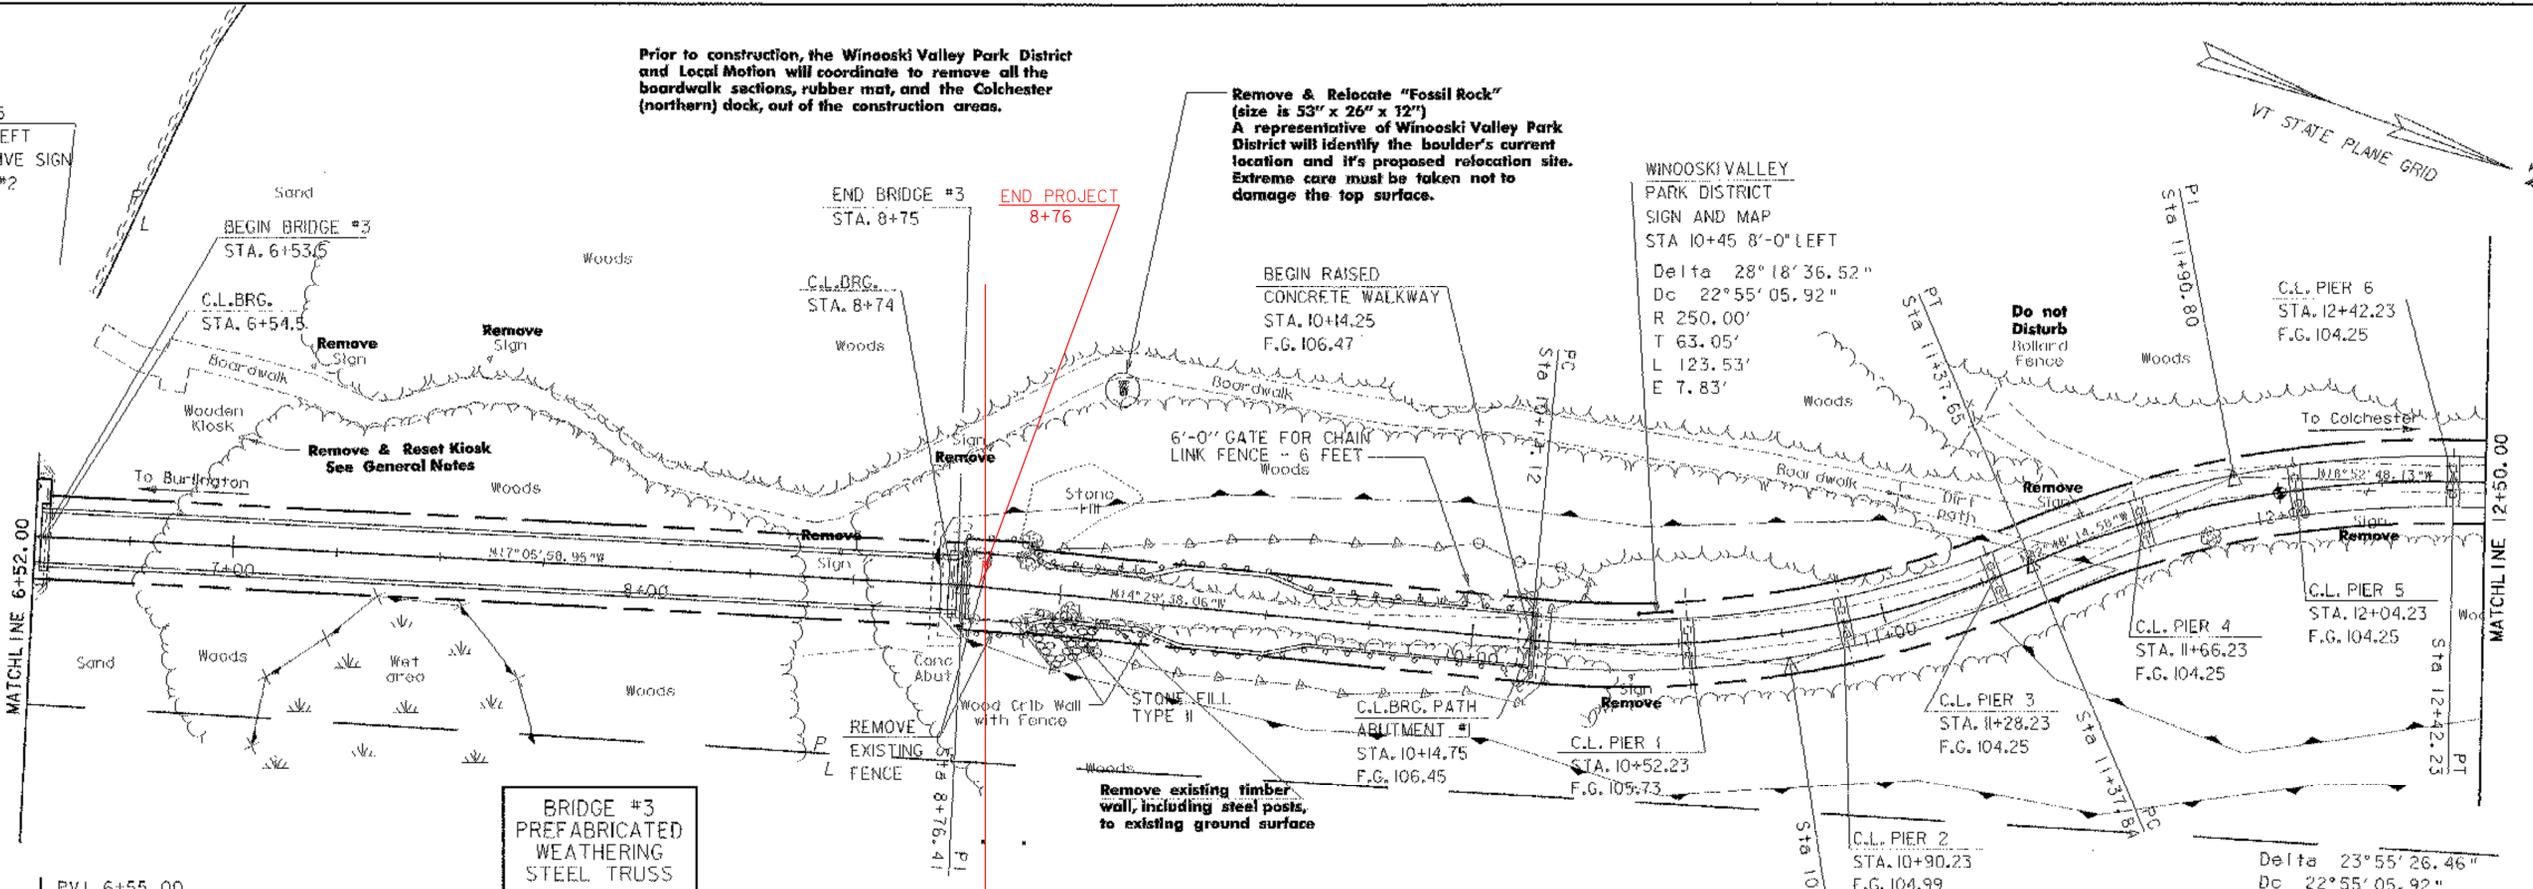

PROJECT NAME: Burlington - Colchester
PROJECT NUMBER: STP Bike(45)
FILE NAME: \str5\01f132\strf132bdr.dgn
PROJECT LEADER: C. Keller
DESIGNED BY: M. Evans-Mongeon
LAYOUT and Profile Sheet 2
PLOT DATE: 15-NOV-2002
DRAWN BY: G. Shangraw
CHECKED BY:
SHEET 22 OF 87

