

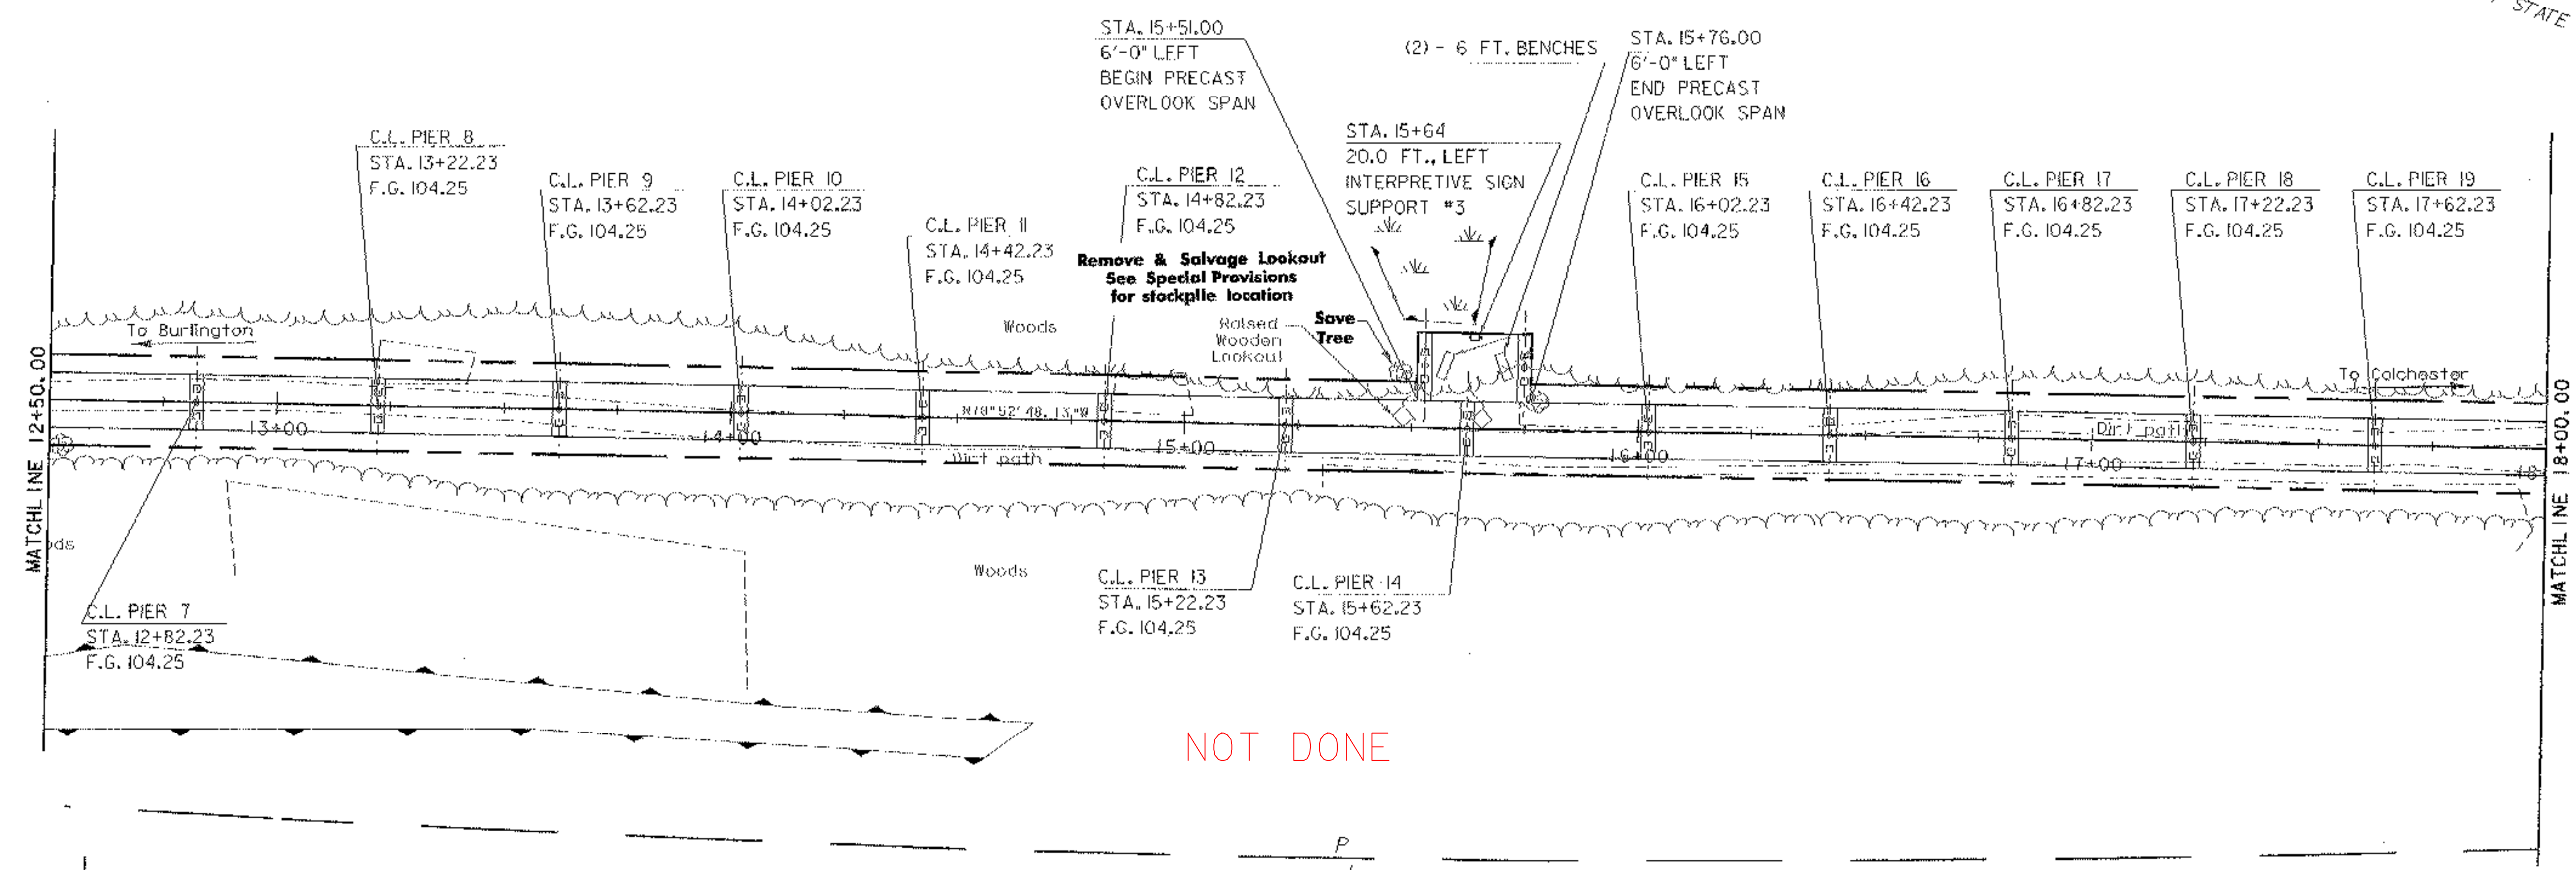
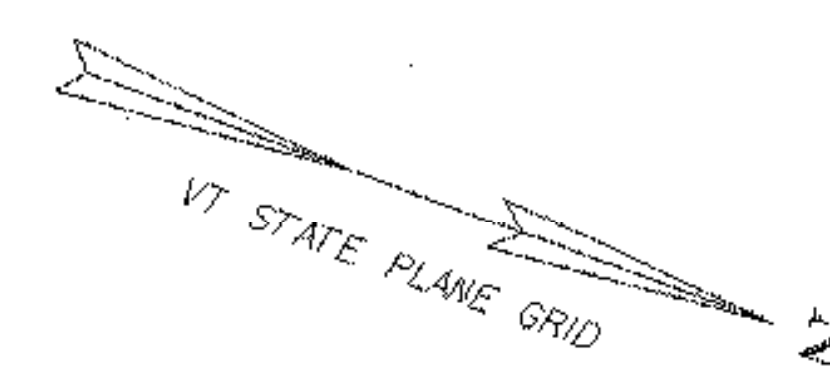


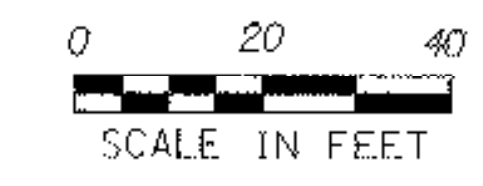

NOT DONE

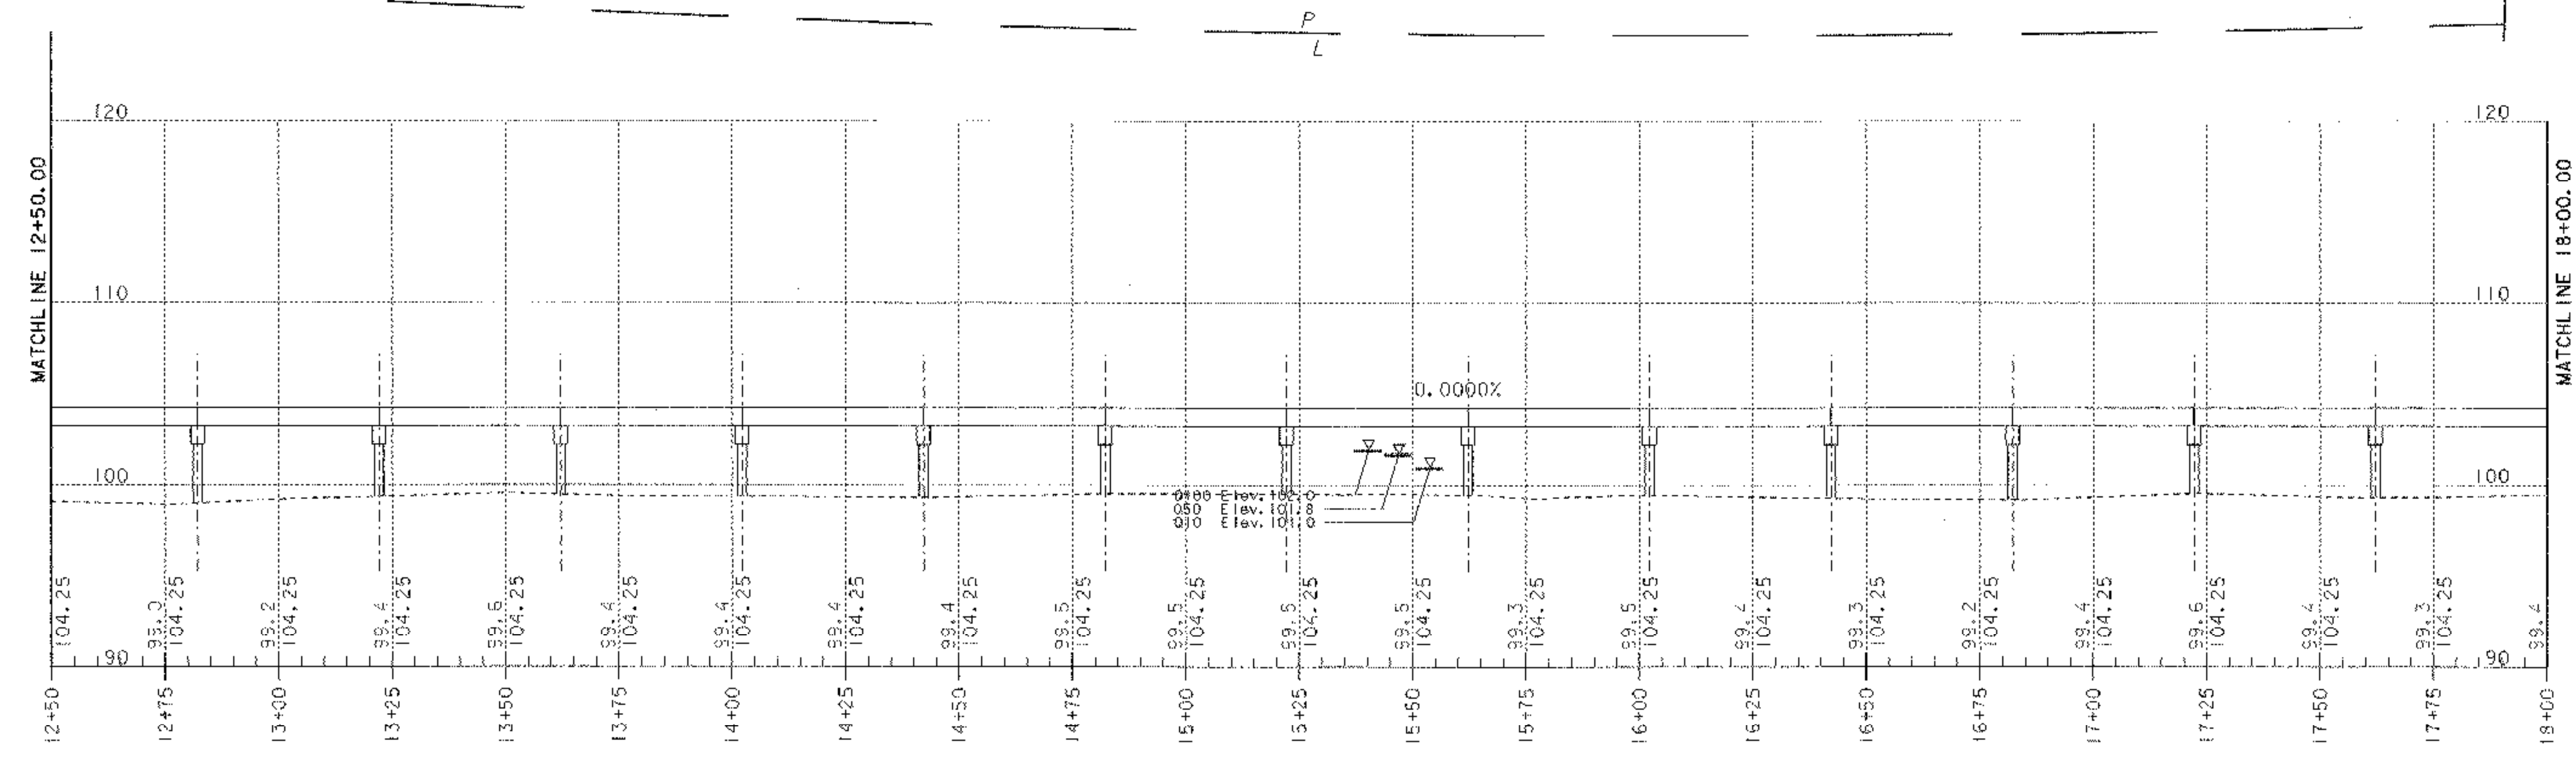

|                            |                            |
|----------------------------|----------------------------|
| PROJECT NAME:              | Burlington - Colchester    |
| PROJECT NUMBER:            | STP Bike(45)               |
| FILE NAME:                 | \\str5\01f132\sf132bdr.dgn |
| PROJECT LEADER:            | C. Keller                  |
| DESIGNED BY:               | M. Evans-Mongean           |
| Layout and Profile Sheet 3 |                            |
| PLOT DATE:                 | 15-NOV-2002                |
| DRAWN BY:                  | G. Shangraw                |
| CHECKED BY:                |                            |
| SHEET                      | 23 OF 87                   |