



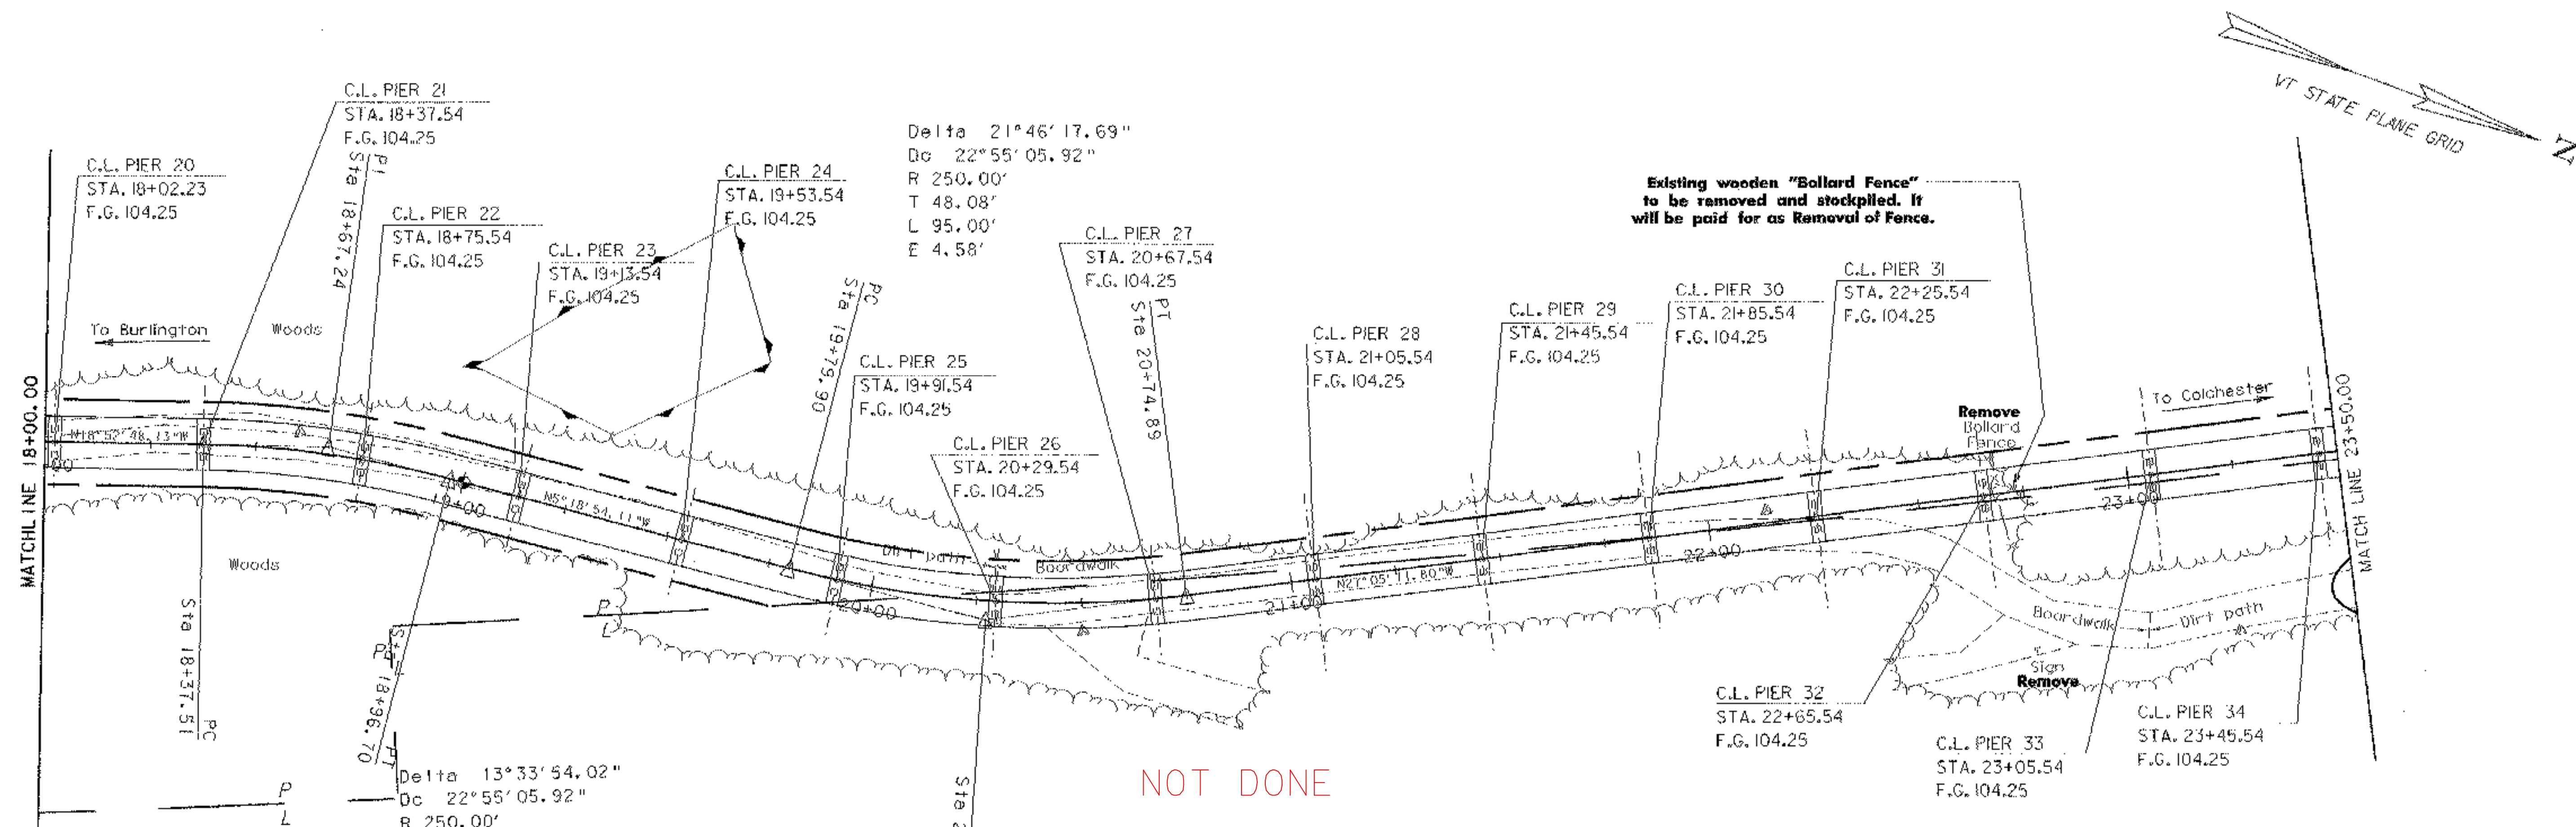

NOT DONE

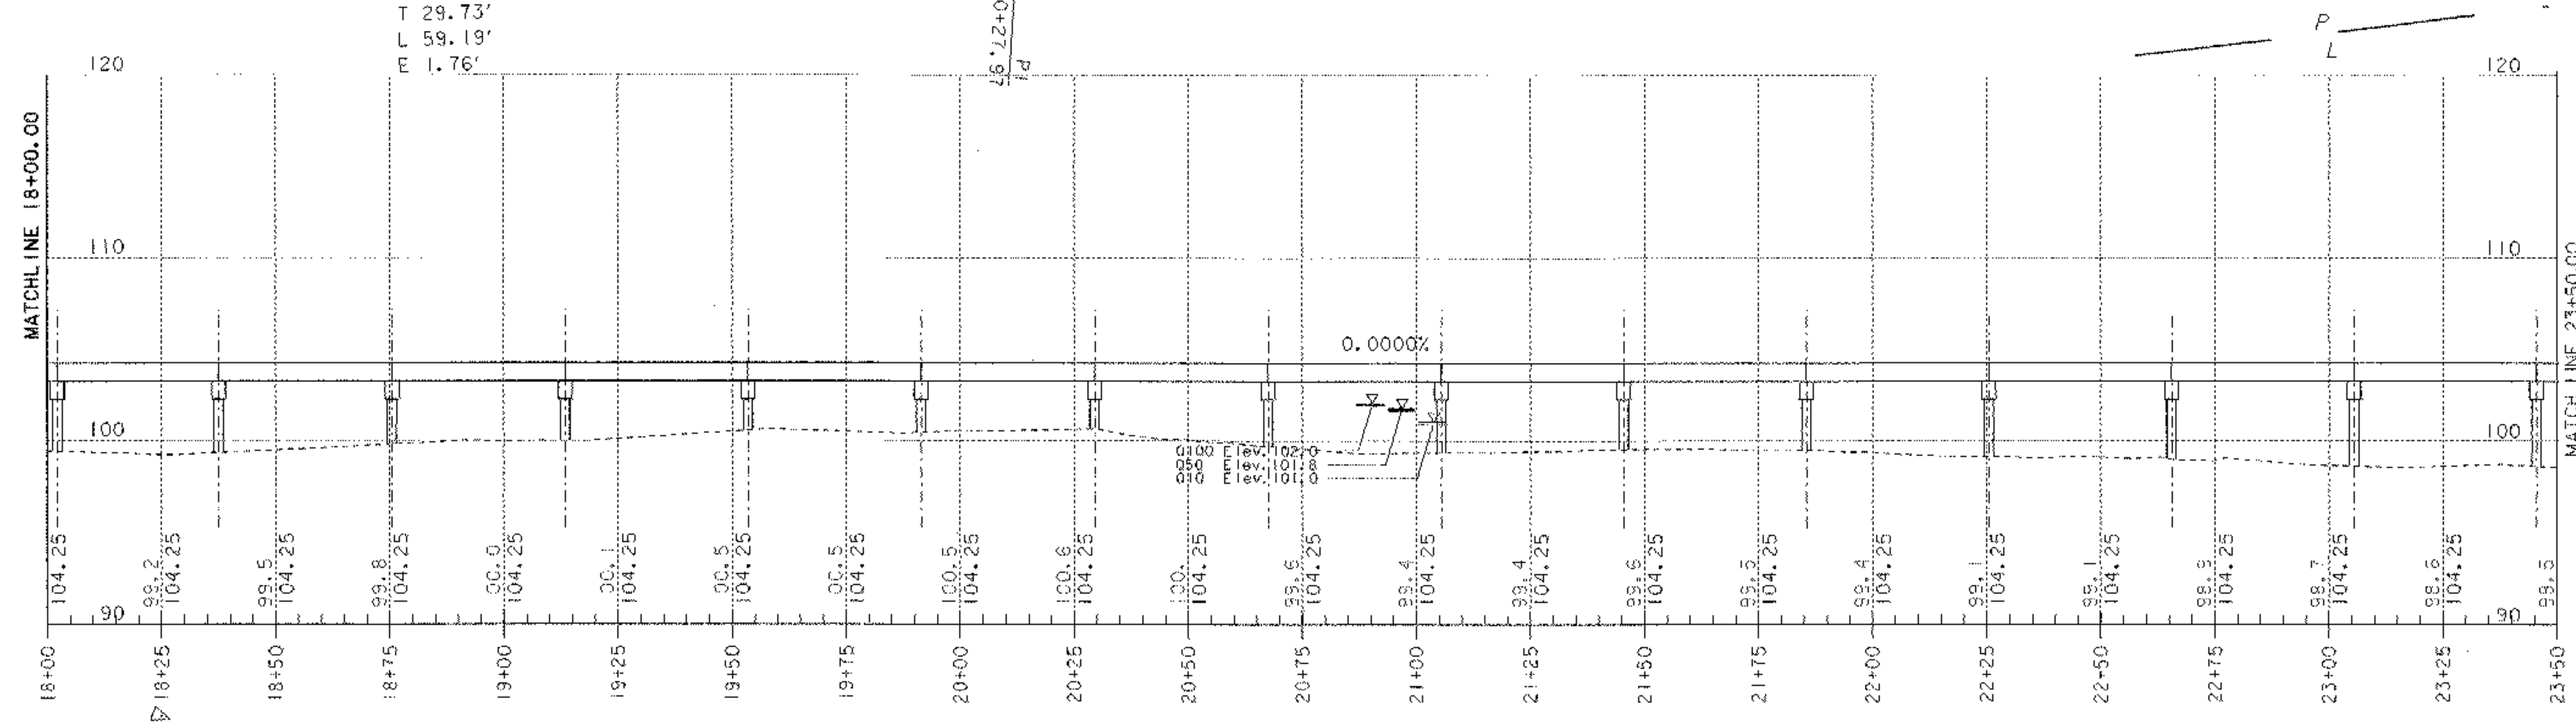

PROJECT NAME: Burlington - Colchester
 PROJECT NUMBER: STP Bike(45)

FILE NAME: \str5\01f132\stf132bdr.dgn PLOT DATE: 15-NOV-2002
 PROJECT LEADER: C. Keller DRAWN BY: G. Shangraw
 DESIGNED BY: M. Evans-Mongeon CHECKED BY:
 Layout and Profile Sheet 4 SHEET 24 OF 87

0 20 40
 SCALE IN FEET