


— WET LAND LIMITS
 X — SILT FENCE
 □ — SNOW FENCE
 NO CONSTRUCTION PERSONNEL OR
 EQUIPMENT ALLOWED OUTSIDE THESE
 LIMITS WITHOUT WRITTEN PERMISSION
 FROM THE PARK DISTRICT.

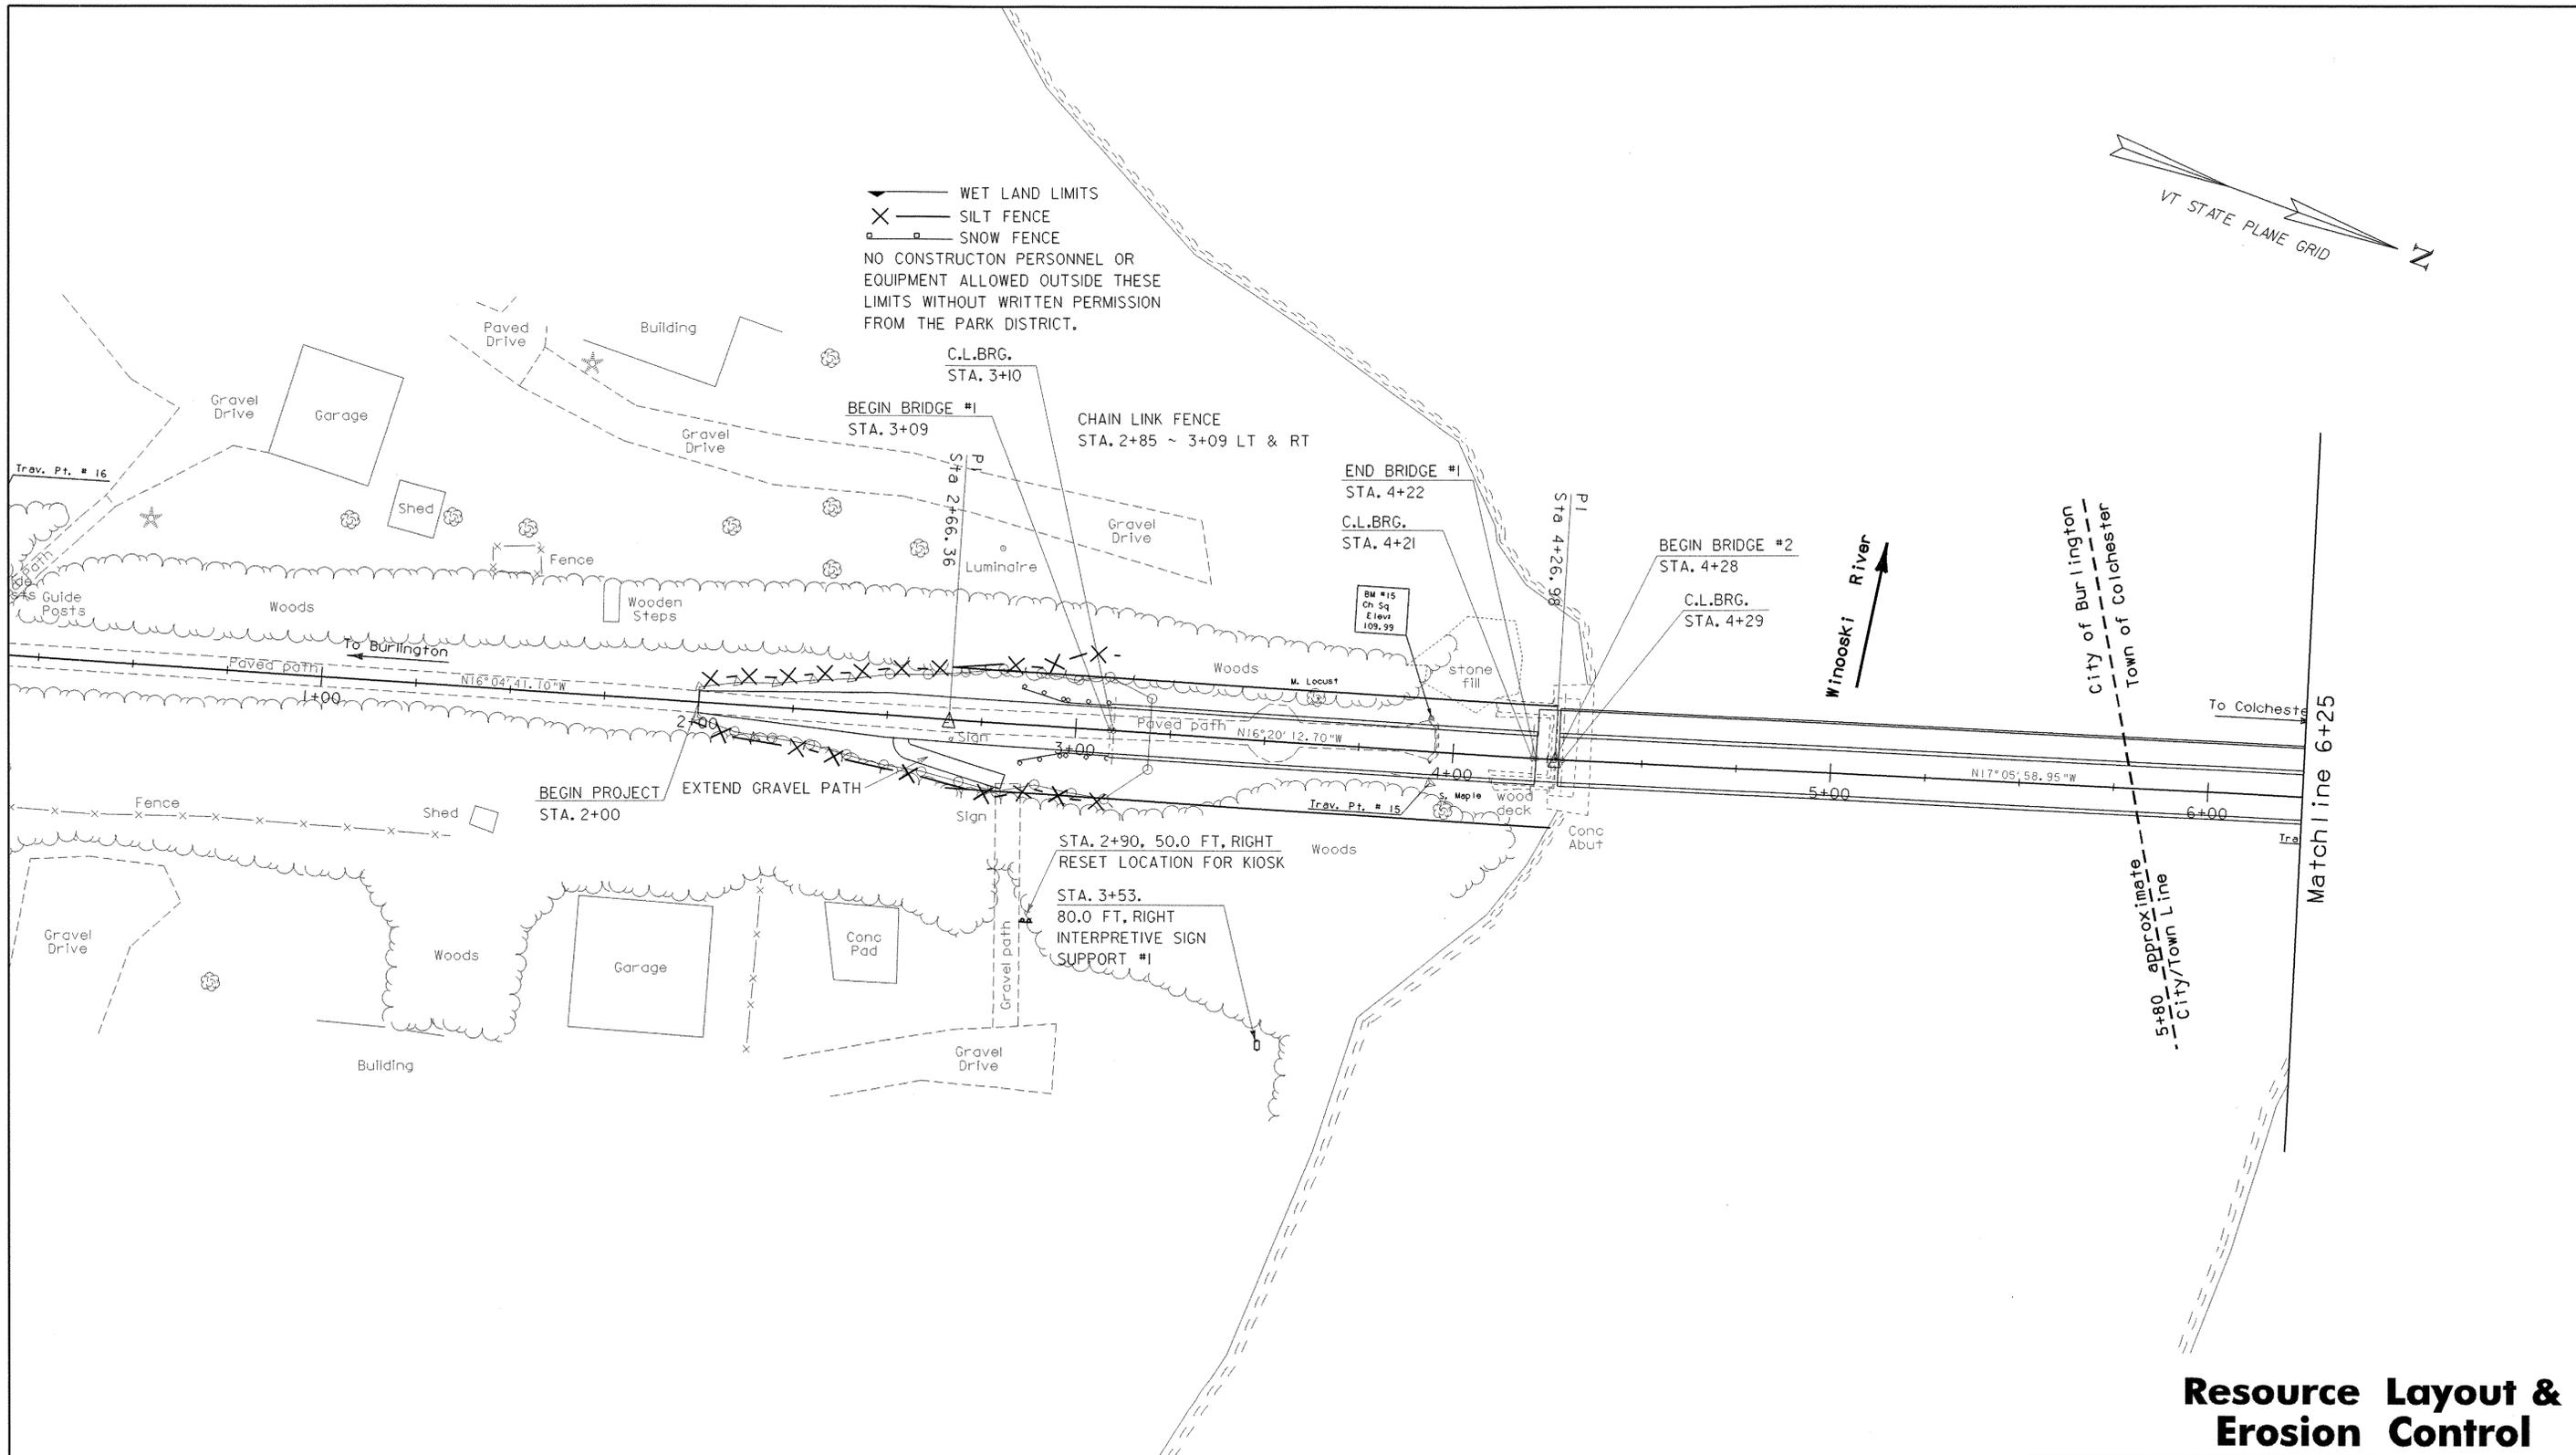

Resource Layout & Erosion Control

PROJECT NAME:	Burlington-Colchester
PROJECT NUMBER:	STP Bike(45)
FILE NAME:	\\str5*f132\resourcebdr.dgn
PROJECT LEADER:	C. Keller
DESIGNED BY:	M. Evans-Mongeon
sf132res5.1	
PL0T DATE:	15-NOV-2002
DRAWN BY:	J. George
CHECKED BY:	
SHEET	26 OF 87