



— WET LAND LIMITS  
 X — SILT FENCE  
 □ — SNOW FENCE  
 NO CONSTRUCTION PERSONNEL OR  
 EQUIPMENT ALLOWED OUTSIDE THESE  
 LIMITS WITHOUT WRITTEN PERMISSION  
 FROM THE PARK DISTRICT.

Delta 21°46' 17.69"  
 Dc 22°55' 05.92"  
 R 250.00'  
 T 48.08'  
 L 95.00'  
 E 4.58'

Delta 13°33' 54.02"  
 Dc 22°55' 05.92"  
 R 250.00'  
 T 29.73'  
 L 59.19'  
 E 1.76'

Delta 38°56' 44.20"  
 Dc 114°33' 29.61"  
 R 50.00'  
 T 17.68'  
 L 33.99'  
 E 3.03'

Delta 29°08' 37.86"  
 Dc 57°17' 44.81"  
 R 100.00'  
 T 26.00'  
 L 50.87'  
 E 3.32'

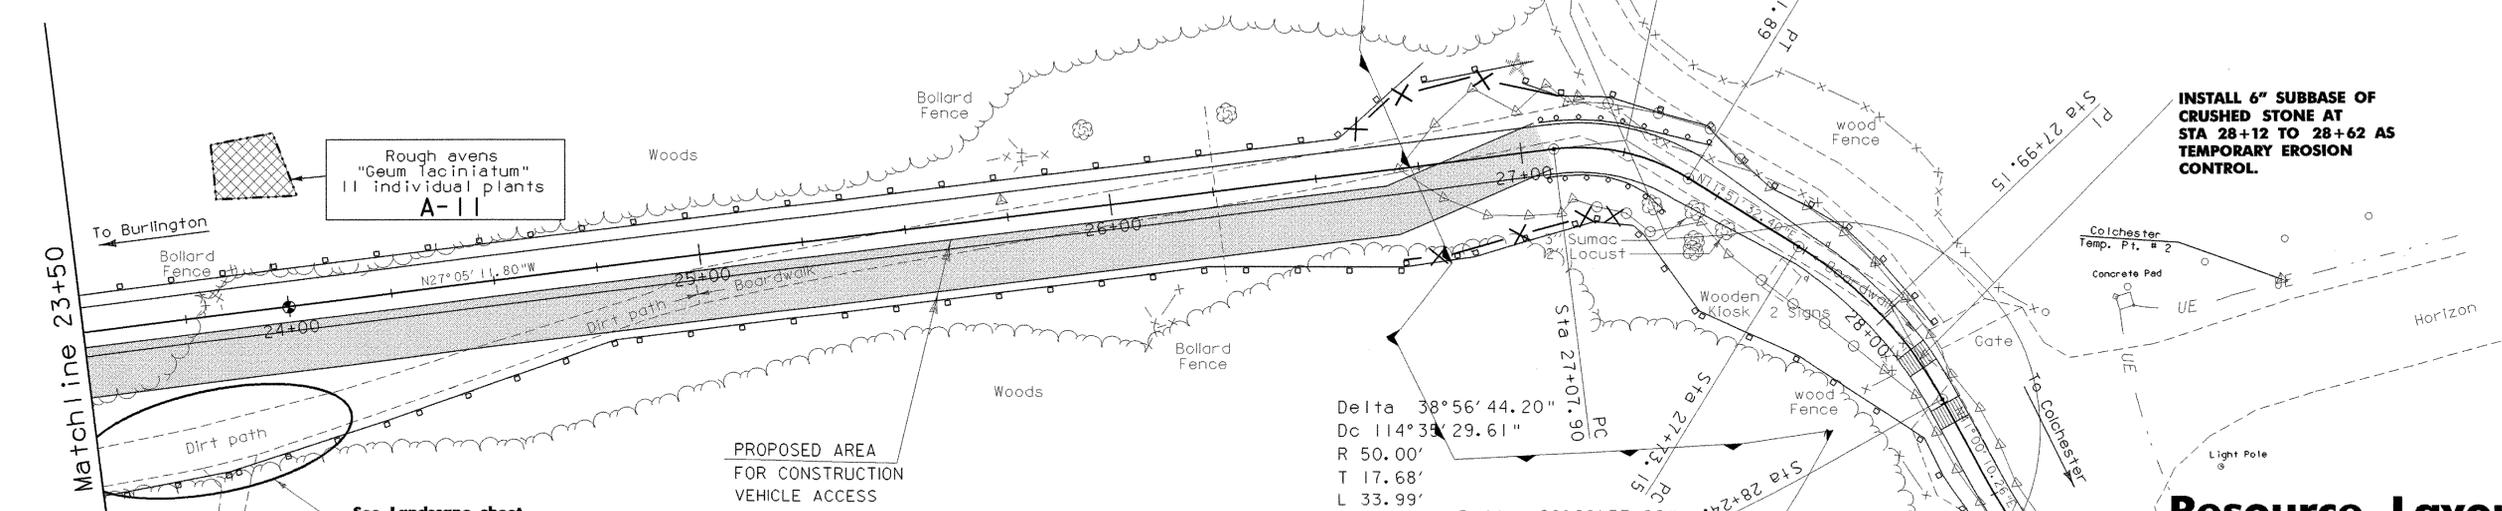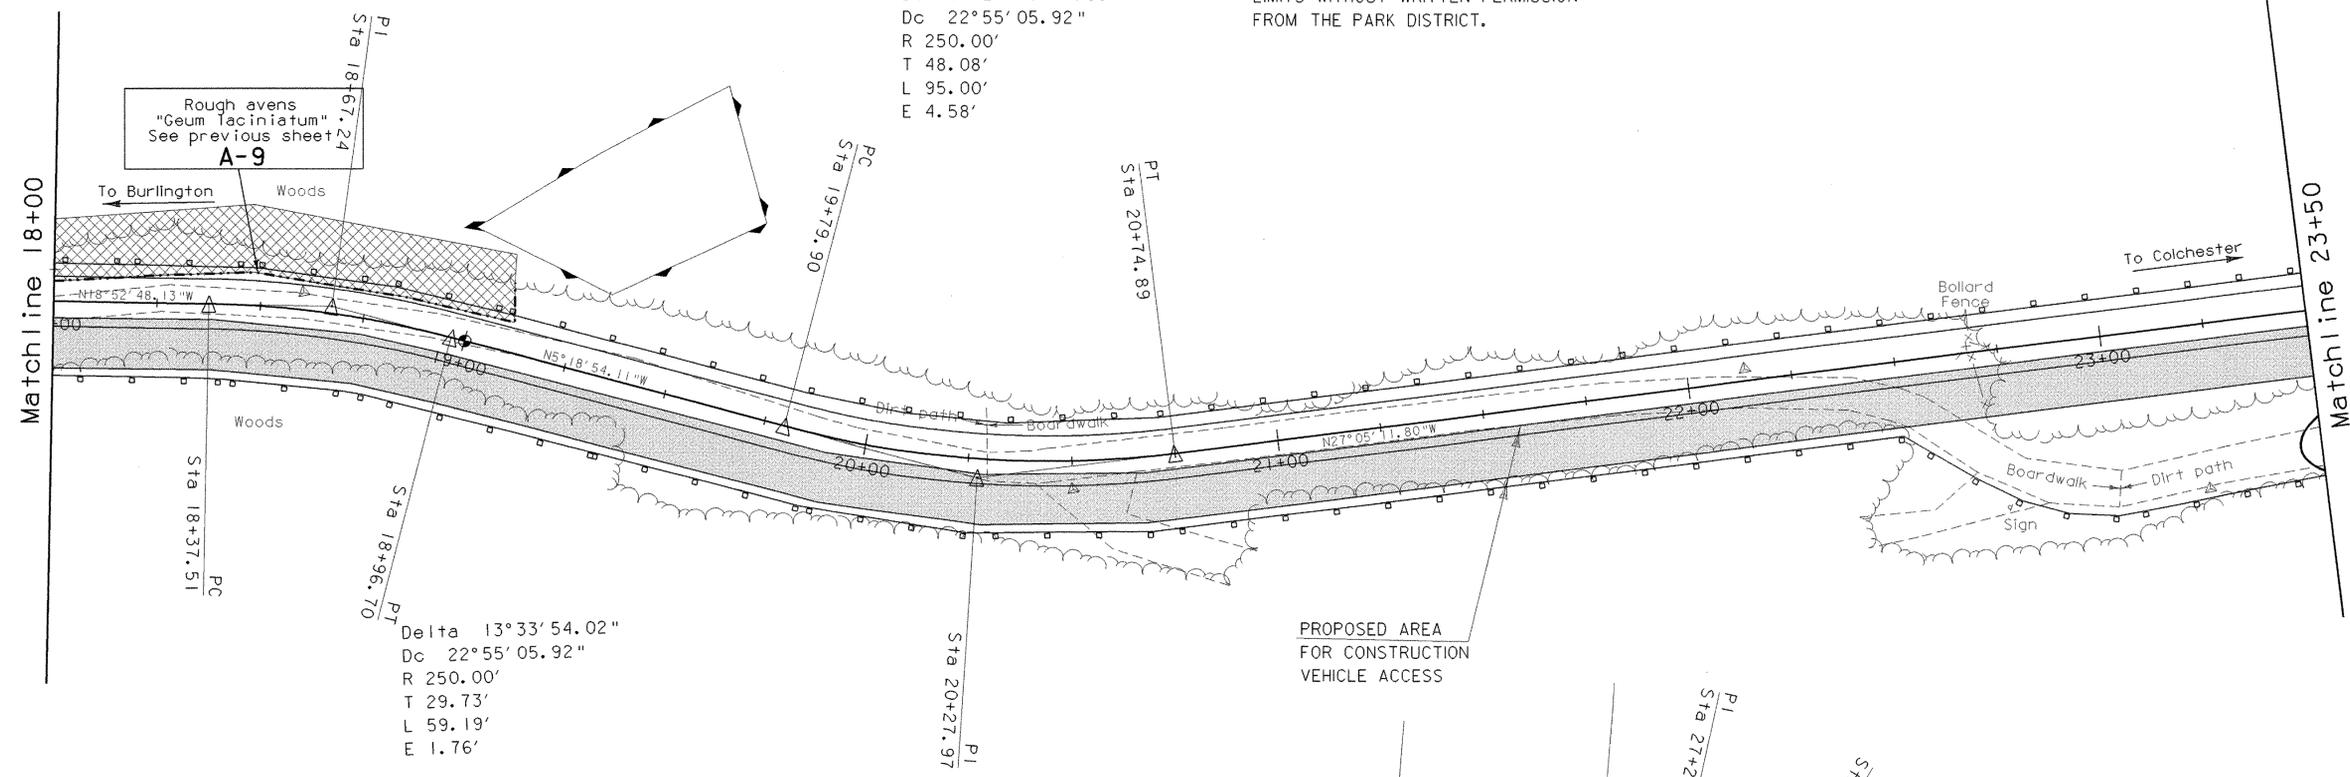

Rough avens  
 "Geum laciniatum"  
 See previous sheet  
**A-9**

Rough avens  
 "Geum laciniatum"  
 11 individual plants  
**A-11**

See Landscape sheet  
 for treatment details  
 of this area.

— WET LAND LIMITS  
 X — SILT FENCE  
 □ — SNOW FENCE  
 NO CONSTRUCTION PERSONNEL OR  
 EQUIPMENT ALLOWED OUTSIDE THESE  
 LIMITS WITHOUT WRITTEN PERMISSION  
 FROM THE PARK DISTRICT.

**INSTALL 6" SUBBASE OF  
 CRUSHED STONE AT  
 STA 28+12 TO 28+62 AS  
 TEMPORARY EROSION  
 CONTROL.**

## Resource Layout & Erosion Control

PROJECT NAME: Burlington - Colchester  
 PROJECT NUMBER: STP Bike(45)  
 FILE NAME: \str5\01f132\resourcebdr.dgn PLOT DATE: 15-NOV-2002  
 PROJECT LEADER: C. Keller DRAWN BY: G. Shangraw  
 DESIGNED BY: M. Evans-Mongeon CHECKED BY:  
 sf132res2.j SHEET 28 OF 87

