


N27° 05' 11.80"W

23+00 23+25 23+50 23+75 24+00 24+25 24+50

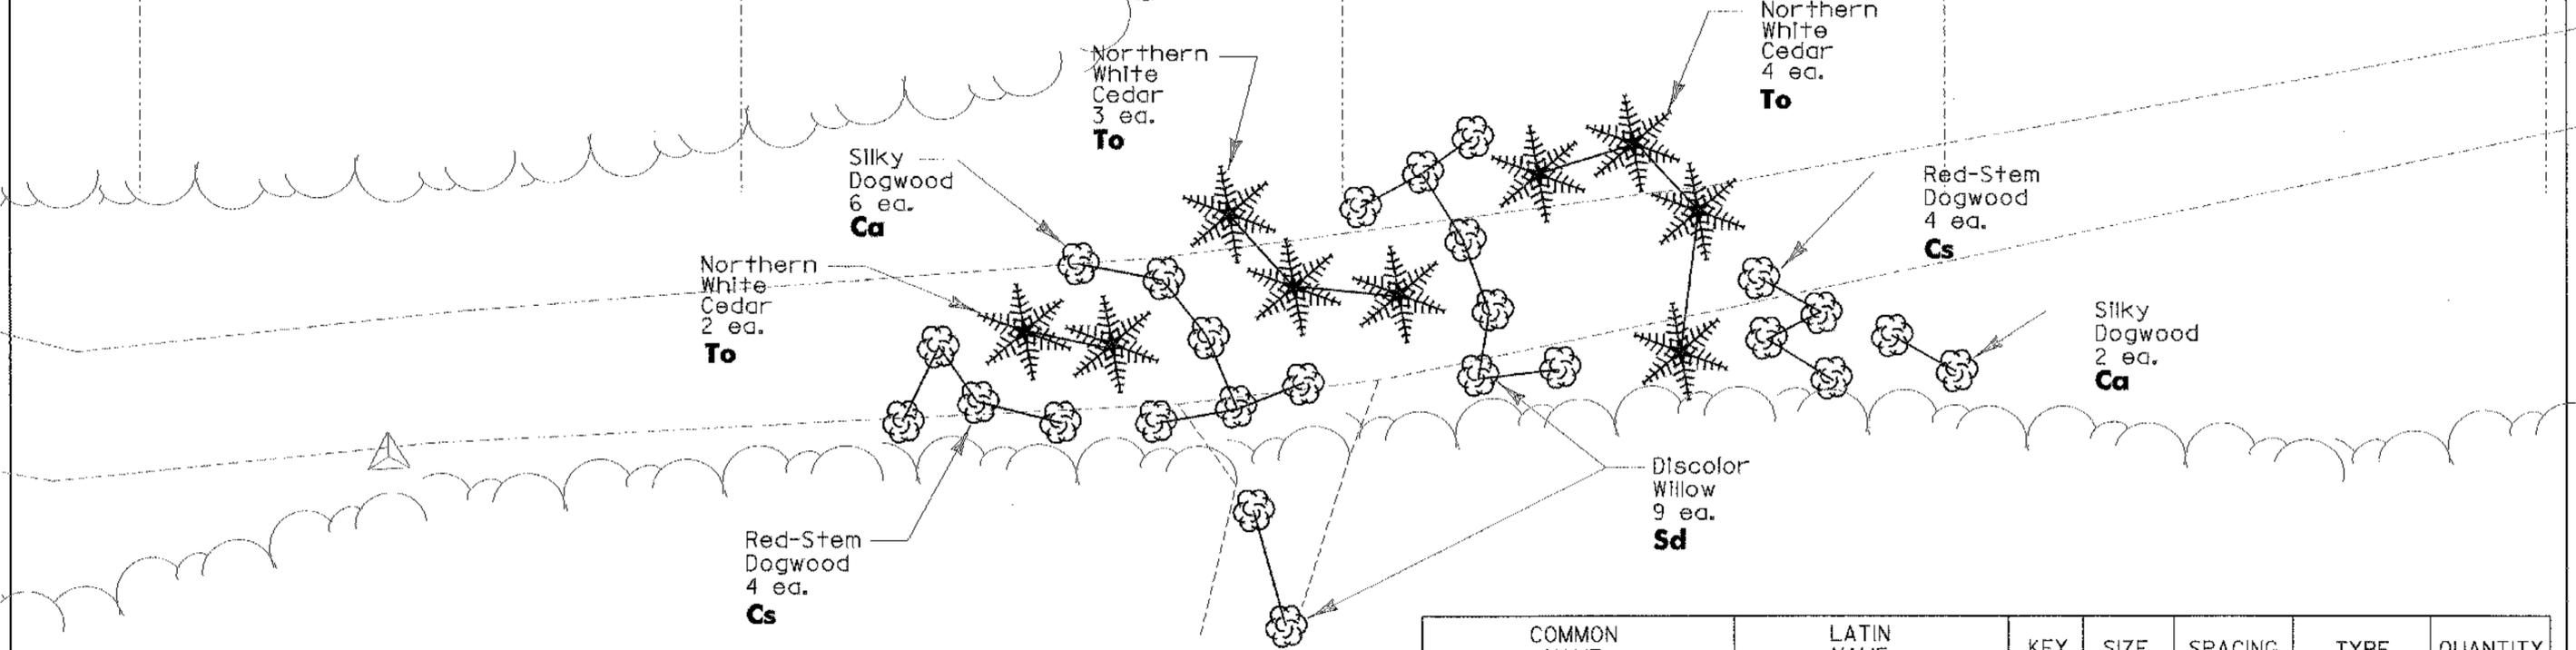

NOT DONE

COMMON NAME	LATIN NAME	KEY	SIZE	SPACING	TYPE	QUANTITY
Northern White Cedar	<i>Thuja occidentalis</i>	To	6'-7'	As Shown	Balled & Burlapped	9
Silky Dogwood	<i>Cornus amomom</i>	Ca	5 Gal. (4'-5')	As Shown	Container	8
Red Stemmed Dogwood	<i>Cornus stoloifera</i>	Cs	5 Gal. (4'-5')	As Shown	Balled & Burlapped	8
Discolor Willow	<i>Salix discolor</i>	Sd	5 Gal. (4'-5')	As Shown	Balled & Burlapped	9

Landscaping Sheet

PROJECT NAME: Burlington - Colchester
 PROJECT NUMBER: STP Bike(45)
 FILE NAME: /str5/01f32/sf132scape.dgn PLOT DATE: 15-NOV-2002
 PROJECT LEADER: C. Keller DRAWN BY: G. Shangraw
 DESIGNED BY: G. Shangraw CHECKED BY:
 sf132scape.t SHEET 29 OF 87

