



**4'' Yellow Line**

27+05 to 27+20 CL (Single Line)

27+20 to 27+30 Lt.

27+20 to 27+30 Rt.

27+30 to 28+09 CL (Single Line)

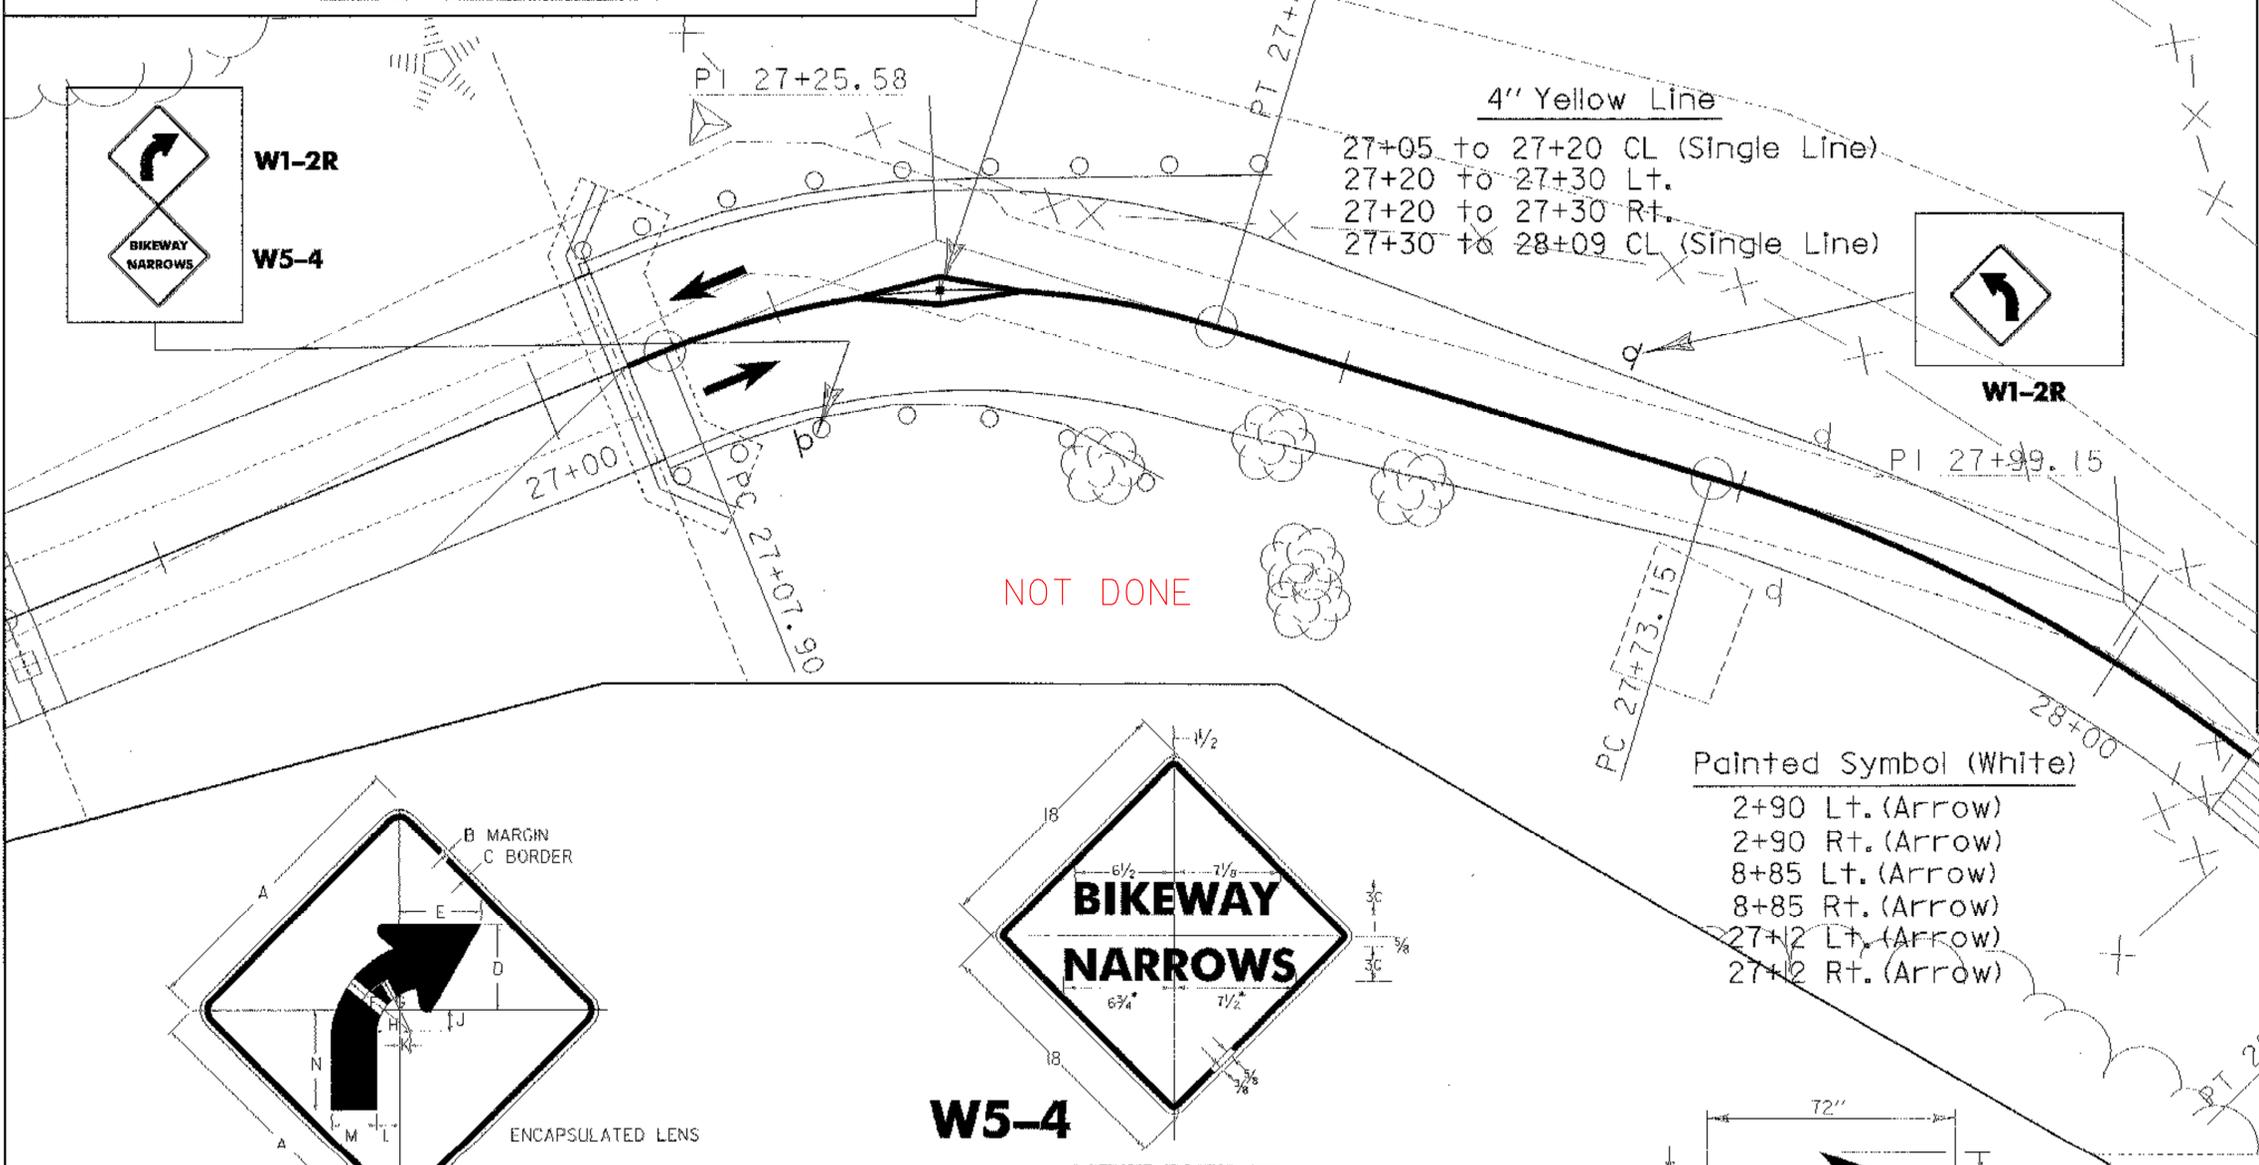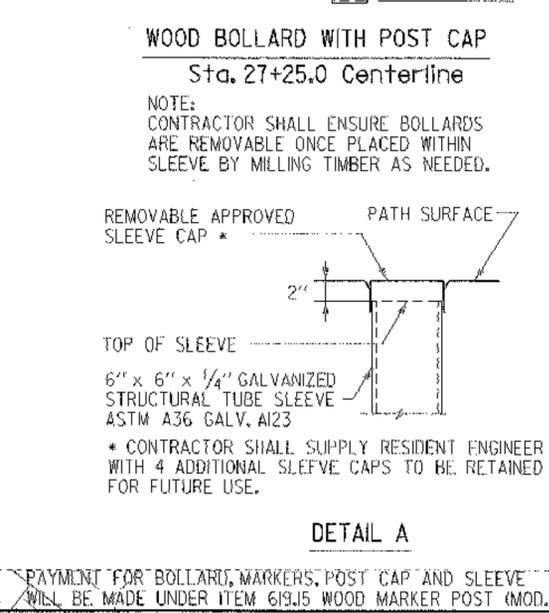

NOT DONE

**Painted Symbol (White)**

2+90 Lt. (Arrow)



2+90 Rt. (Arrow)

8+85 Lt. (Arrow)

8+85 Rt. (Arrow)

27+2 Lt. (Arrow)

27+2 Rt. (Arrow)

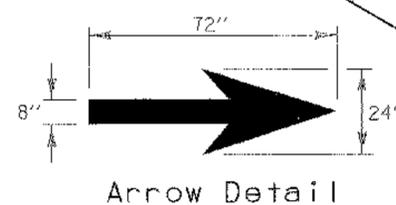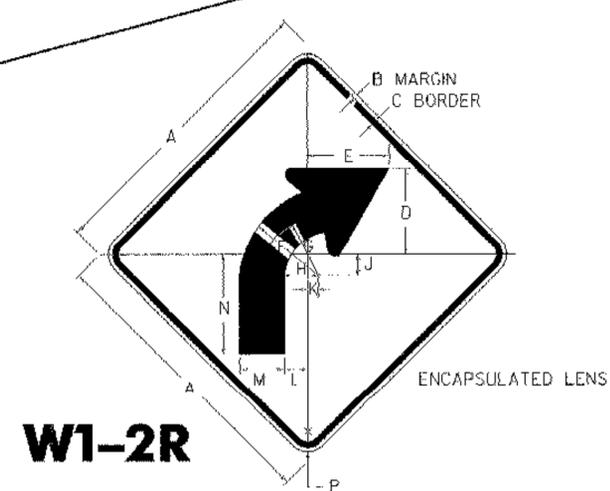

SIGN	DIMENSIONS (INCHES)													
	A	B	C	D	E	F	G	H	J	K	L	M	N	P
PATH	18	3/8	3/8	5 3/8	5 1/2	6	4 3/4	3 3/8	1 3/4	1 1/4	2	2 5/8	6 1/4	1 1/2

SIGN	DIMENSIONS (INCHES)					
	A	B	C	D	E	F
PATH	18	3/8	3/8	5 3/8	5 1/2	6

**GENERAL**

SEE STANDARD E-144 FOR ARROW HEAD DETAILS



**Signs & Markings**

PROJECT NAME: **Burlington-Colchester STP Bike(45)**

PROJECT NUMBER:

FILE NAME: s:\str5\01c132\sf132signs.dgn

PROJECT LEADER: C. Keller

DESIGNED BY: G. Shangraw

PLOT DATE: 15-NOV-2002

DRAWN BY: G. Shangraw

CHECKED BY:

SHEET 33 OF 87