


SECTION A-A
SCALE 1/2" = 1'-0"
1 0 1 2

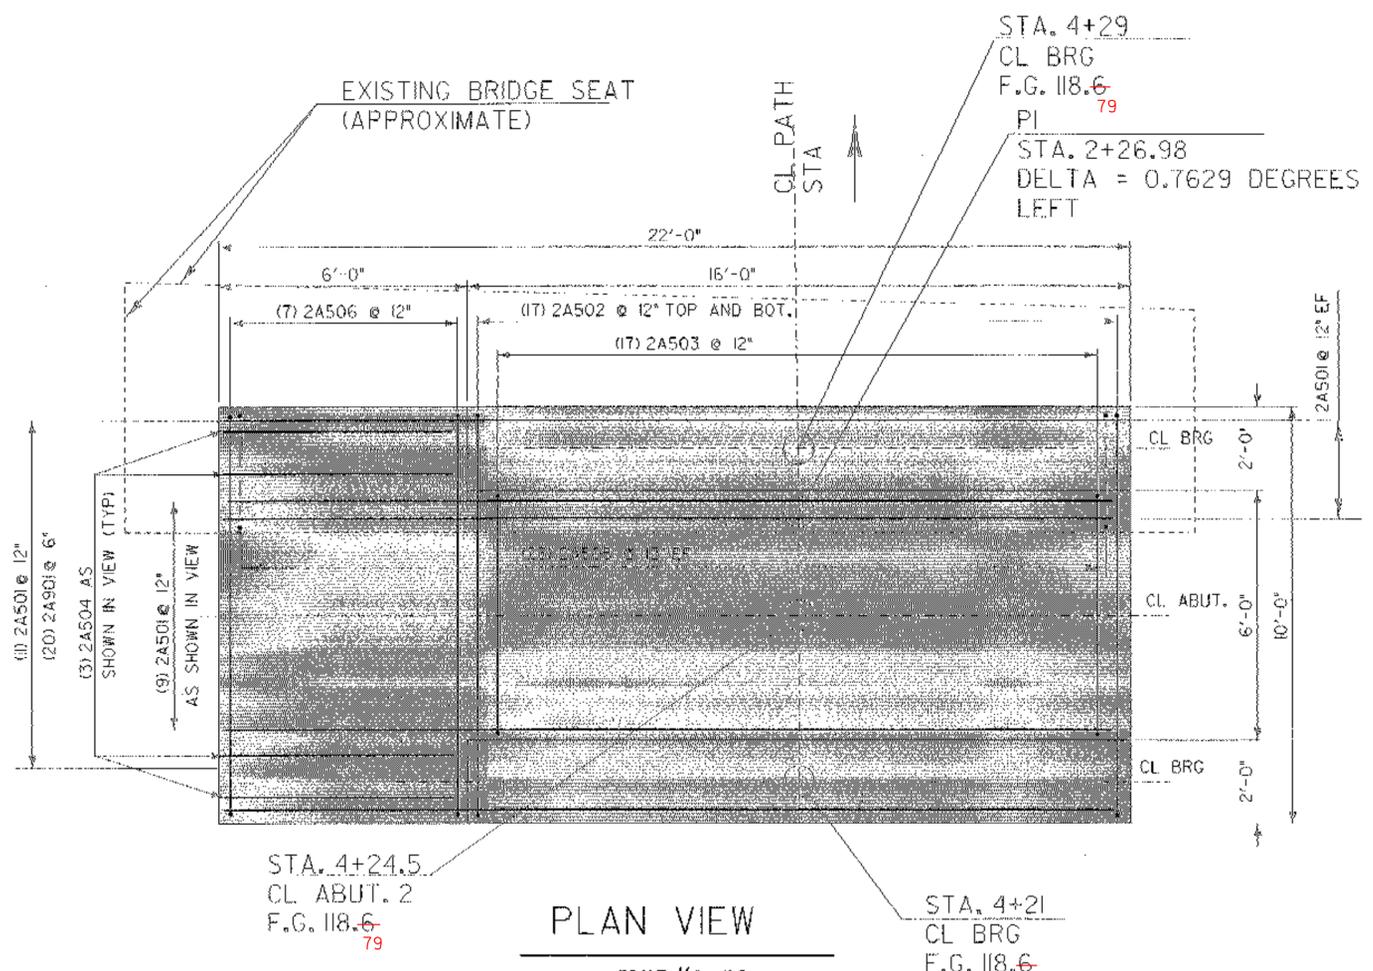

PLAN VIEW
SCALE 1/2" = 1'-0"
1 0 1 2

* NOTE: BRIDGE SEAT ELEVATIONS SUBJECT TO CHANGE AFTER SHOP DRAWINGS FOR THE PREFABRICATED MULTI-MODULAR BRIDGE ARE APPROVED.

NOTE:
NF - NEAR FACE
FF - FAR FACE
EF - EACH FACE
▲ - CUT TO FIT IN FIELD
3" CLR. UNLESS OTHERWISE SPECIFIED ON THE PLANS.

STATE OF VERMONT AGENCY OF TRANSPORTATION	
Town Of BURLINGTON-COLCH.	Bridge No. 4-27
Highway No. BIKE PATH	Log. Sta. _____ Surv. Sta. _____
ABUTMENT 2 (STA. 4 +27)	
LAYOUT AND REINFORCING	
Designed By M. EVANS-MORFON	Drawn By J. GEORGE
Checked By _____ Date _____	Bridge Design Supervisor G.S. KELLER Date _____
PROJECT BURLINGTON-COLCH.	PROJECT NO. STP BIKE (45)
I.G.C. \vms\cadd\11\bridge\plans\01132\structures\st132abi.dgn sf132abi.dwg	
Bridge Sheet No. _____	Sheet 61 of 87