


SIDE VIEW

SCALE 1/2" = 1'-0"
 1 0 1 2

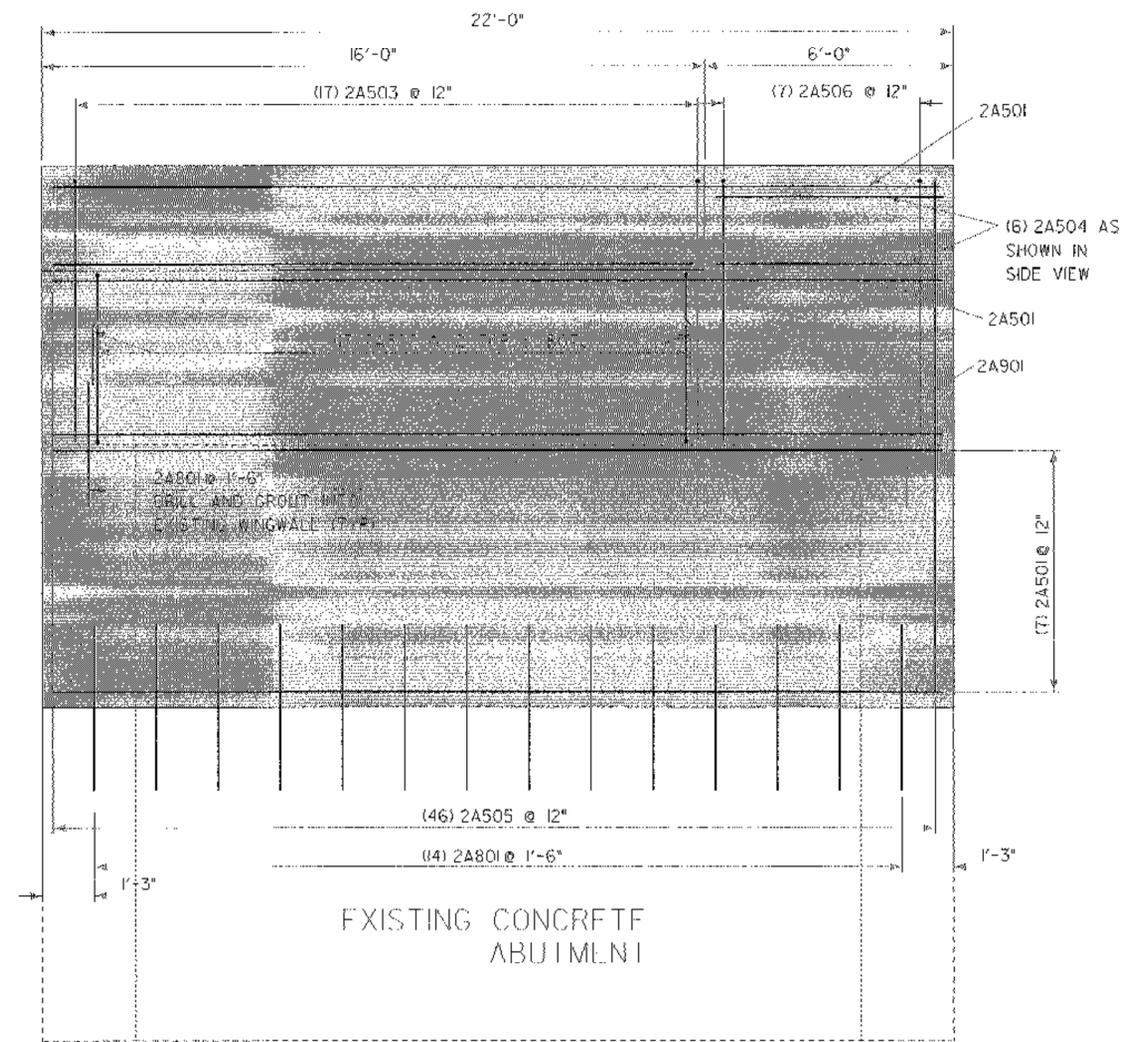

ELEVATION VIEW

SCALE 1/2" = 1'-0"
 1 0 1 2

NOTE: BRIDGE SEAT ELEVATIONS SUBJECT TO CHANGE AFTER SHOP DRAWINGS FOR THE PREFABRICATED MULTI-MODULAR BRIDGE ARE APPROVED.

* NOTE: BRIDGE SEAT ELEVATIONS SUBJECT TO CHANGE AFTER SHOP DRAWINGS FOR THE PREFABRICATED MULTI-MODULAR BRIDGE ARE APPROVED.

NOTE:
 NF - NEAR FACE
 FF - FAR FACE
 EF - EACH FACE
 ▲ - CUT TO FIT IN FIELD
 3" CLR. UNLESS OTHERWISE SPECIFIED ON THE PLANS.

| | |
|---|---|
| STATE OF VERMONT AGENCY OF TRANSPORTATION | |
| Town of BURLINGTON-COLCH. | Bridge No. 4-27 |
| Highway No. BIKE PATH | Log Sta. _____ Surv. Sta. _____ |
| ABUTMENT #2 (STA 4+27) | |
| ELEVATION AND SIDE VIEW | |
| Designed By M. EVANS-MONGEON | Drawn By J. GEORGE |
| Checked By _____ Date _____ | Bridge Design Supervisor C.S. KELLER Date _____ |
| PROJECT BURLINGTON-COLCH. | PROJECT NO. STP BIKE (45) |
| I.G.C.:\work\road\11\figcab\net\4\01132\structures\stf132ab02.dgn sf132ab02.dgn | |
| Bridge Sheet No. _____ | Sheet 62 of 87 |