



PIER REINFORCING LAYOUT

SCALE 1/2" = 1'-0"

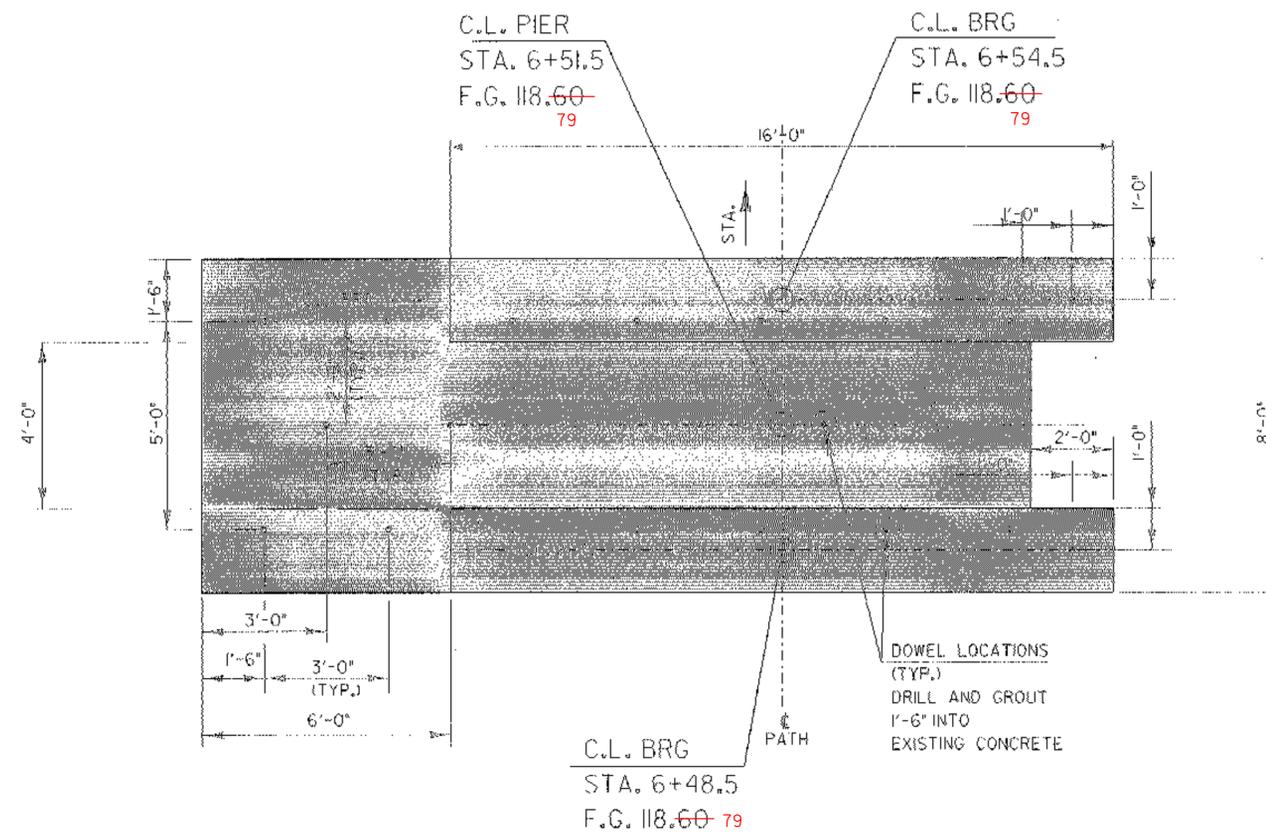

PIER PLAN VIEW

SCALE 1/2" = 1'-0"

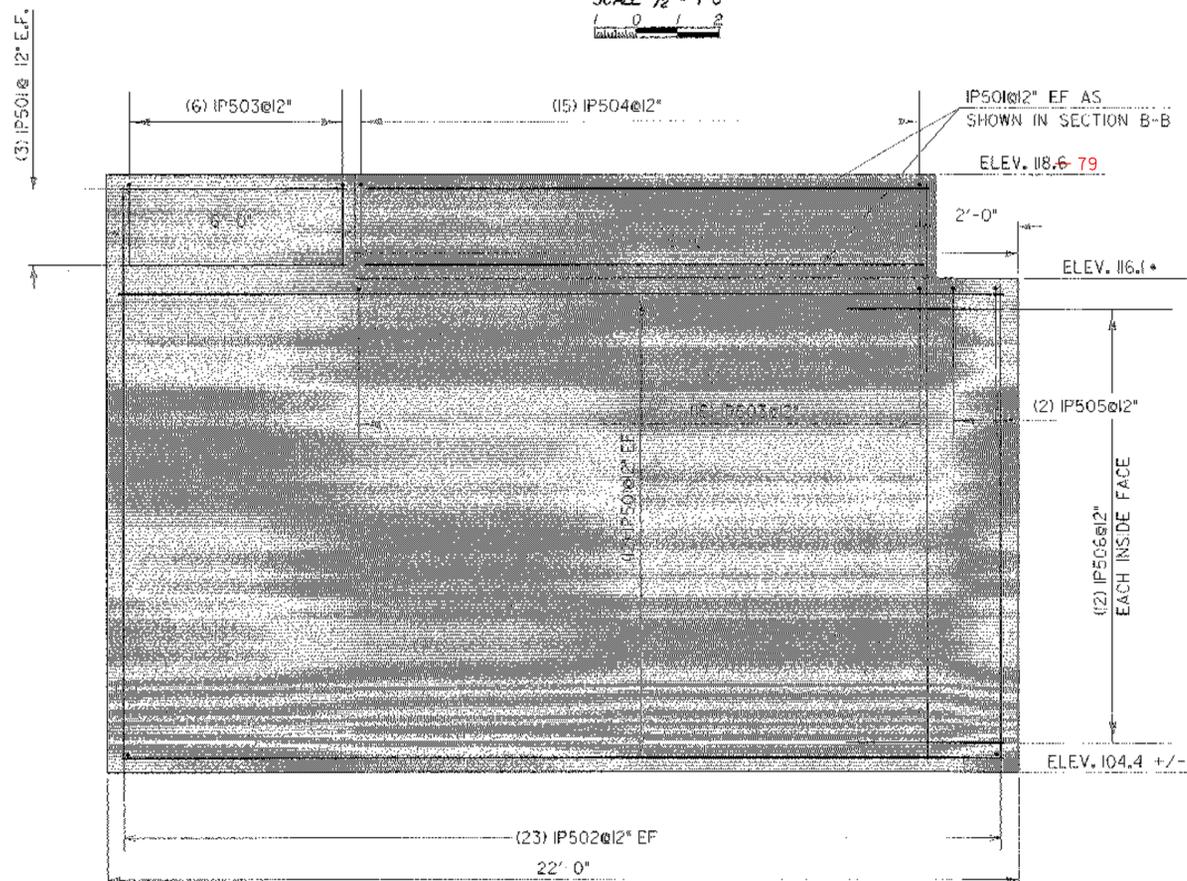

PIER ELEVATION VIEW

SCALE 1/2" = 1'-0"

**NOTE:**

- NF = NEAR FACE
- FF = FAR FACE
- EF = EACH FACE
- ▲ = CUT TO FIT IN FIELD
- 3" CLR. UNLESS OTHERWISE SPECIFIED ON THE PLANS.

\* NOTE: BRIDGE SEAT ELEVATIONS SUBJECT TO CHANGE AFTER SHOP DRAWINGS FOR THE PREFABRICATED MULTI-MODULAR BRIDGE ARE APPROVED.

**STATE OF VERMONT  
AGENCY OF TRANSPORTATION**

Town of <b>BURLINGTON-COLCH.</b>	Bridge No. <b>6-51</b>
Highway No. <b>BIKE PATH</b>	Log Sta. <b>PIER (STA. 6+51)</b>
<b>DETAILS</b>	
Designed By <b>M. EVANS-MONGEON</b>	Drawn By <b>M. EVANS-MONGEON</b>
Checked By <b>Date</b>	Bridge Design Supervisor <b>G.S. KELLER Date</b>
PROJECT <b>BURLINGTON-COLCH.</b>	PROJECT NO. <b>STP BIKE (45)</b>
I.G.C. \code\VT\logcab\ner\01132\Structures\st132\br.dgn st132\pl1.d	
Bridge Sheet No.	Sheet <b>64</b> of <b>87</b>