




2+85
Begin Fence Lt. & Rt.

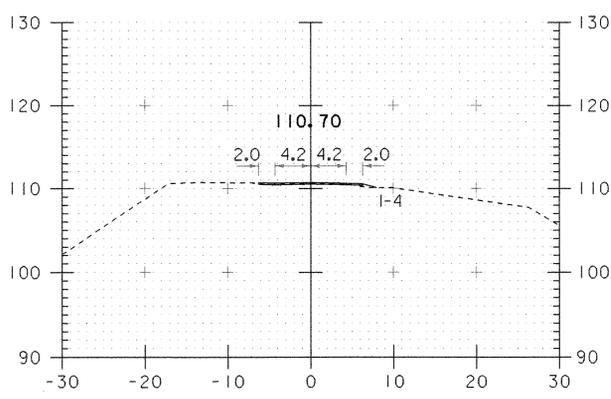


2+20
Begin Subbase Taper

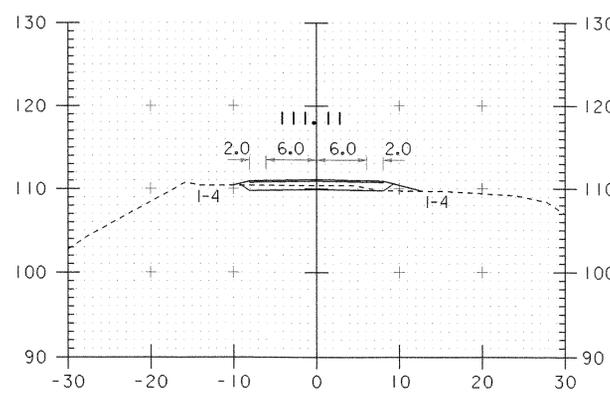


2+50

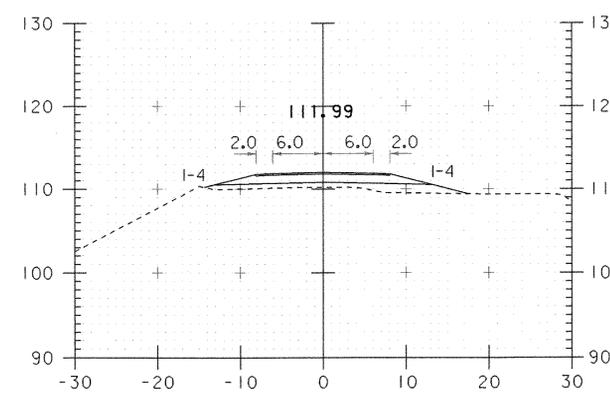


2+80

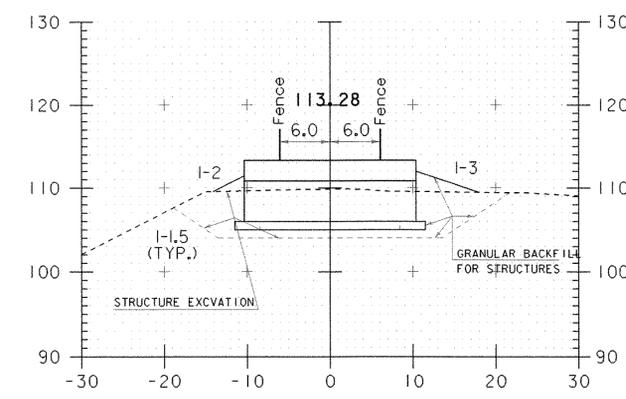

3+09
Stop Path
Begin Bridge

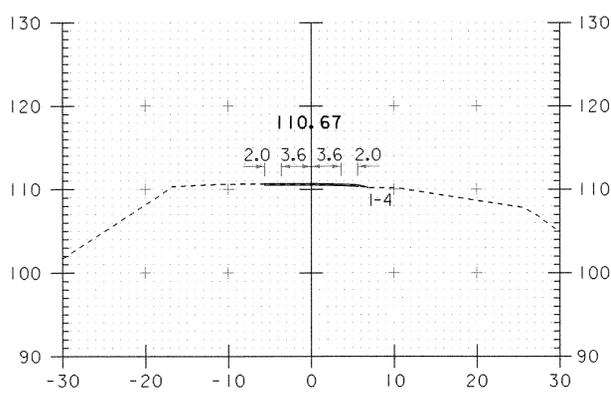


2+10

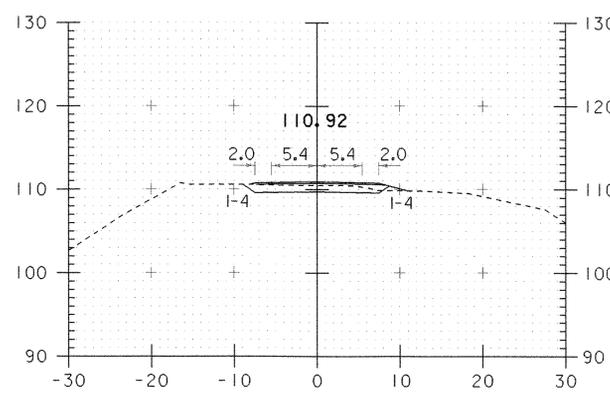


2+40


Begin Full Depth Subbase

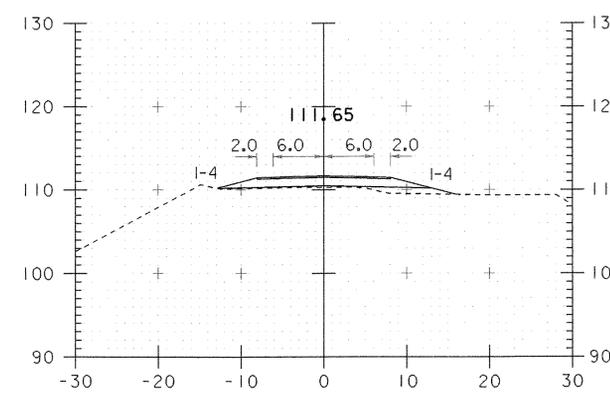

2+70

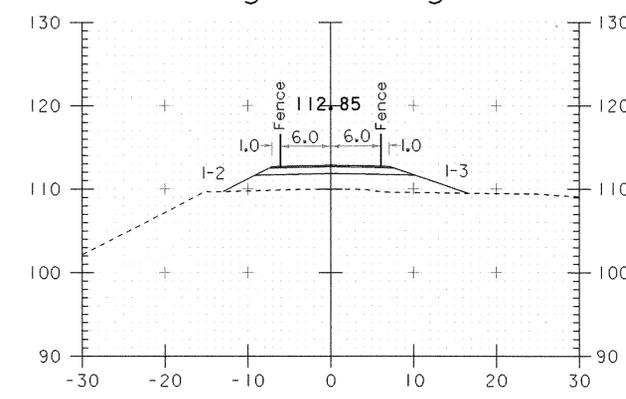


3+00

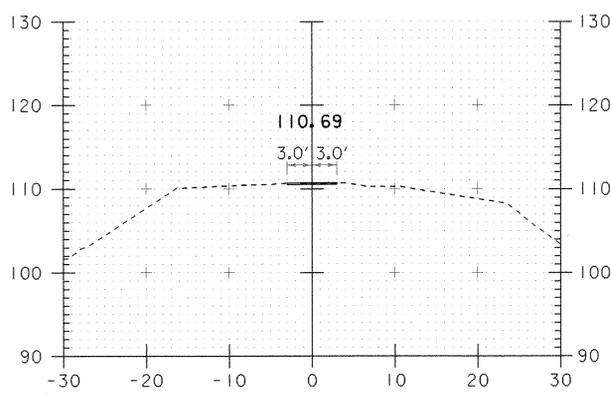


2+00


Begin Pavement Removal

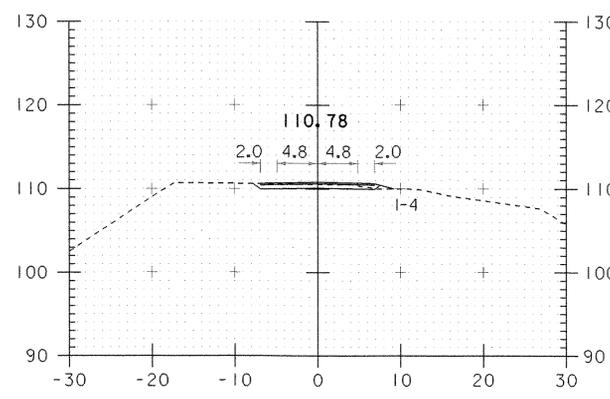

2+30

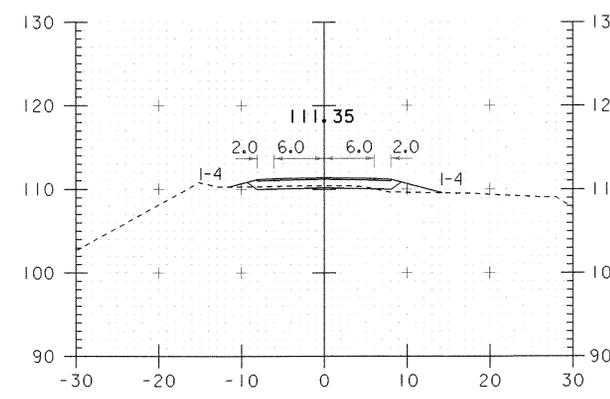

2+60

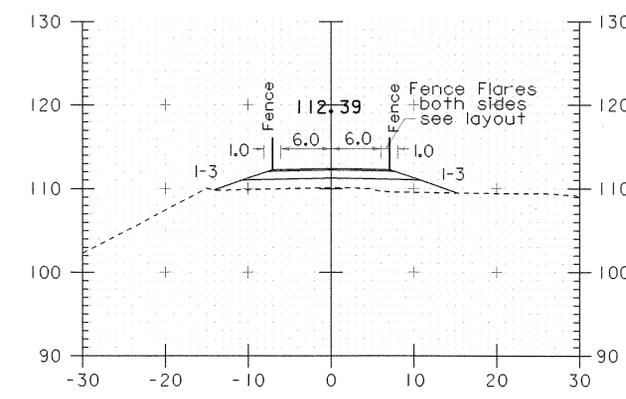

2+90

2+00 - 3+09

PROJECT NAME:	Burlington - Colchester
PROJECT NUMBER:	STP Bike(45)
FILE NAME:	/str5/01f32/sf132xsl.dgn
PROJECT LEADER:	C. Keller
DESIGNED BY:	G. Shangraw
PLOT DATE:	15-NOV-2002
DRAWN BY:	G. Shangraw
CHECKED BY:	
SHEET	70 OF 87