
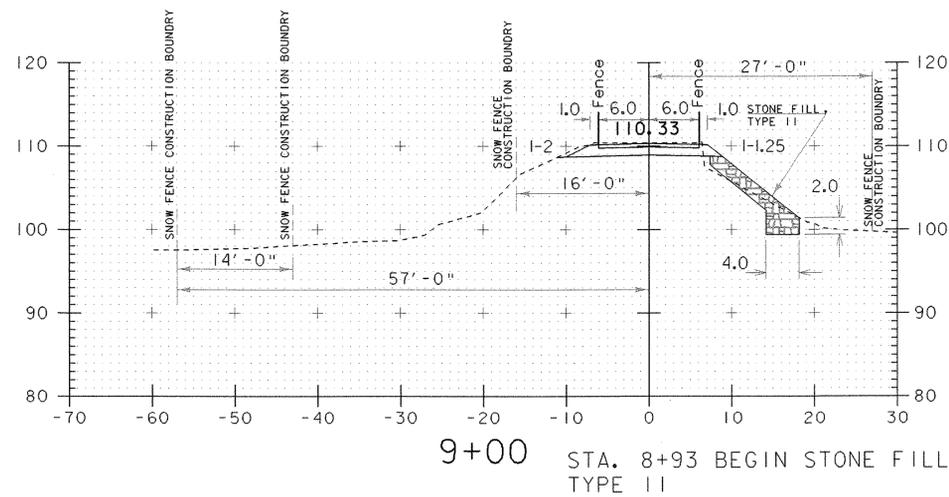
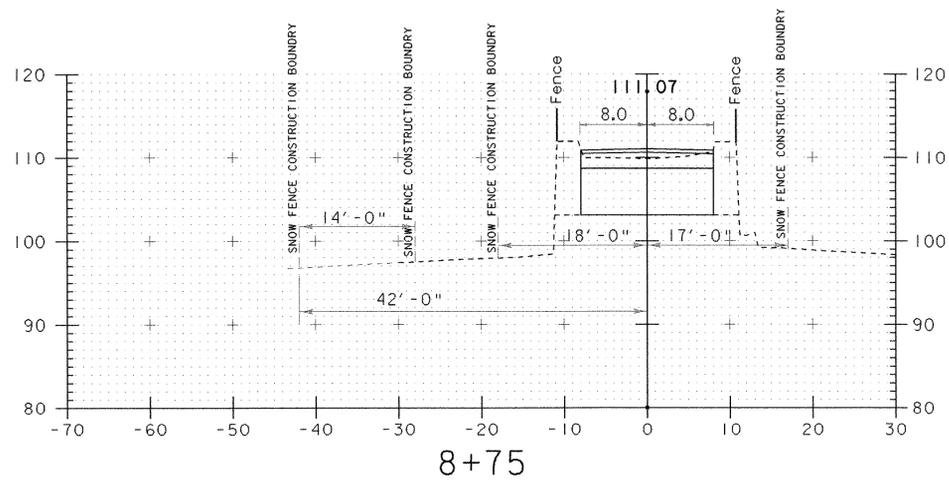
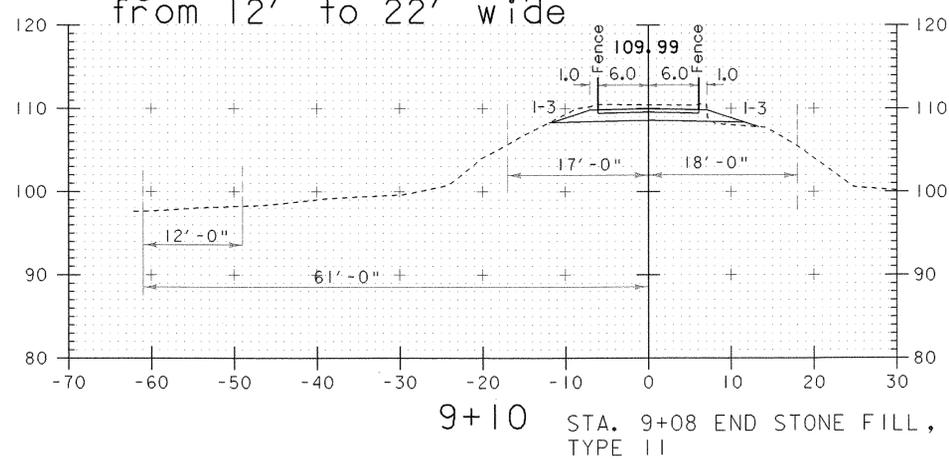


Begin Path Width Taper  
from 12' to 22' wide

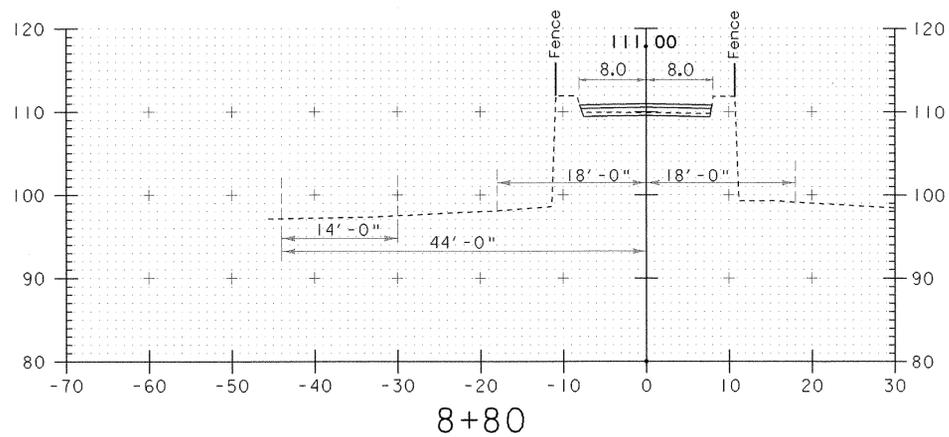

**8+75 - 9+20**

PROJECT NAME:	Burlington - Colchester
PROJECT NUMBER:	STP Bike(45)
FILE NAME: /str5/01f132/sf132xsl.dgn	PLOT DATE: 15-NOV-2002
PROJECT LEADER: C. Keller	DRAWN BY: G. Shangraw
DESIGNED BY: G. Shangraw	CHECKED BY:
sf132xs2.1	SHEET 71 OF 87