
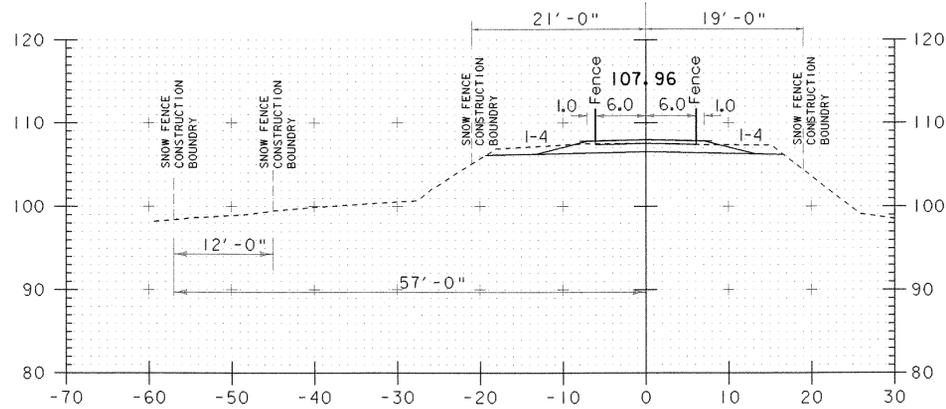




9+50 9+50
 End 22' Wide Path
 Begin Taper 22' to 12' wide

9+80

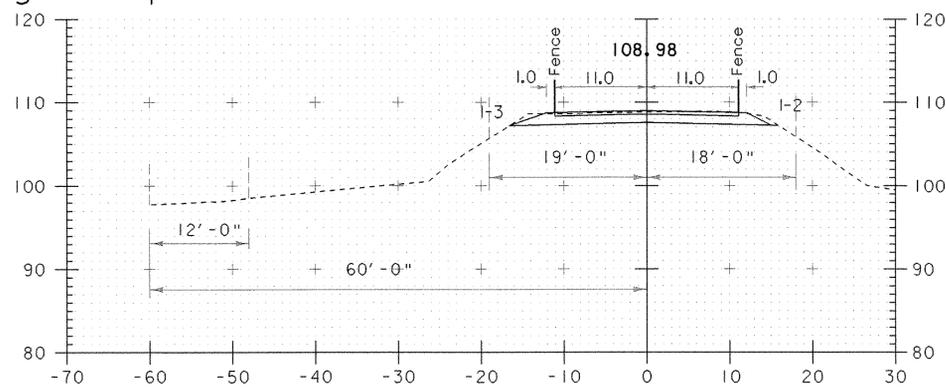

9+40

9+70

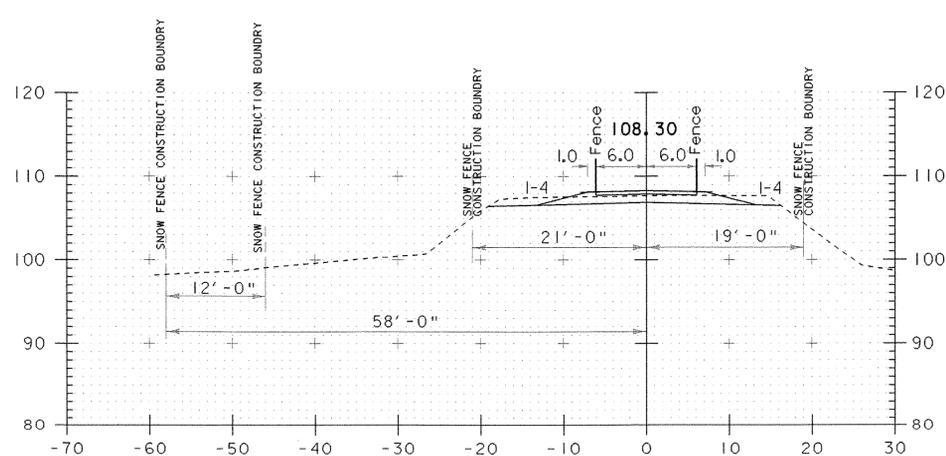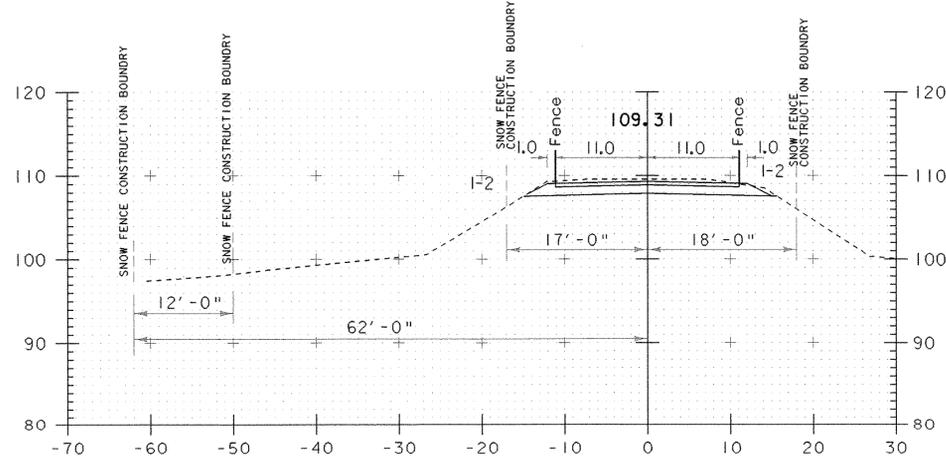

9+30

9+60 9+60
 End Width Taper
 Resume 12' Wide Path

9+30 - 9+80

PROJECT NAME:	Burlington - Colchester	PLOT DATE:	15-NOV-2002
PROJECT NUMBER:	STP Bike(45)	DRAWN BY:	G. Shangraw
FILE NAME:	/str5/01f132/sf132xsl.dgn	DESIGNED BY:	G. Shangraw
PROJECT LEADER:	C. Keller	CHECKED BY:	
DESIGNED BY:	G. Shangraw	SHEET	72 OF 87
FILE NAME:	sf132xs3.1		