




16+00

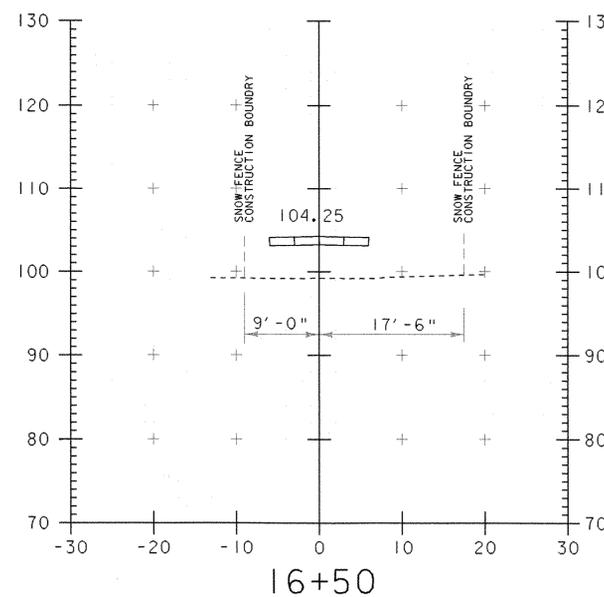


16+50

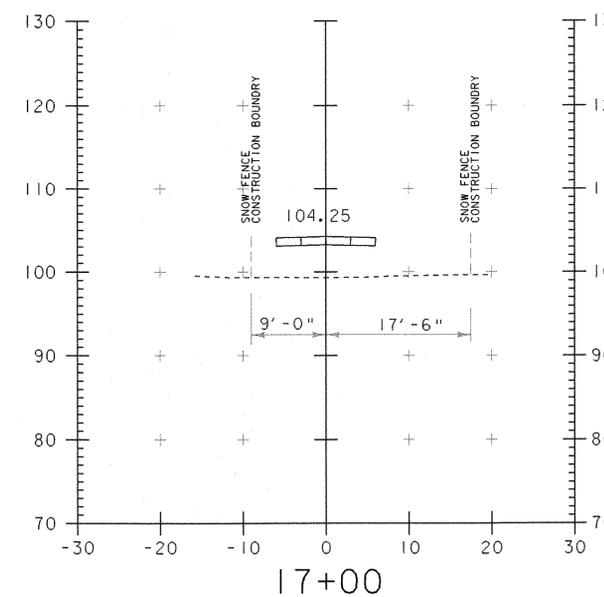


17+00

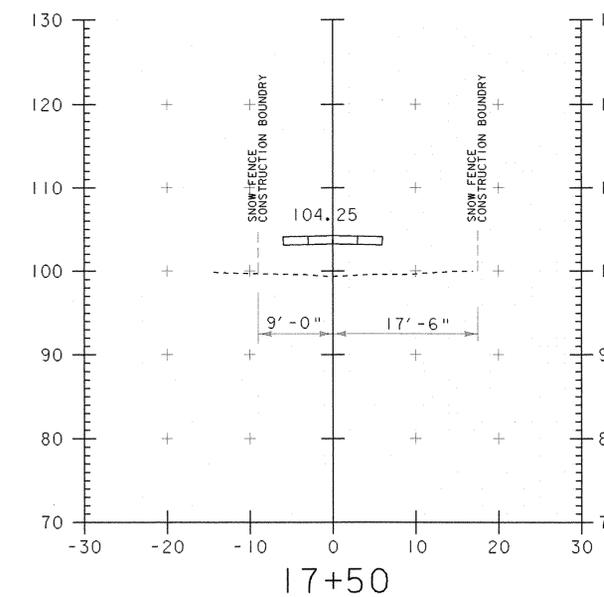


17+50

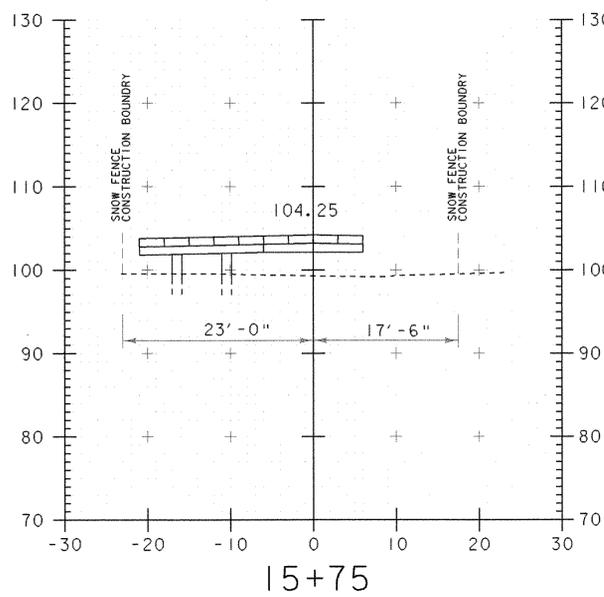


15+75

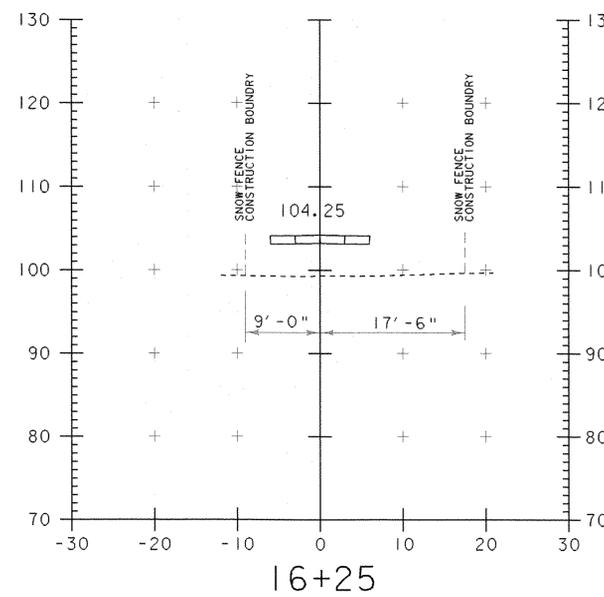

16+25

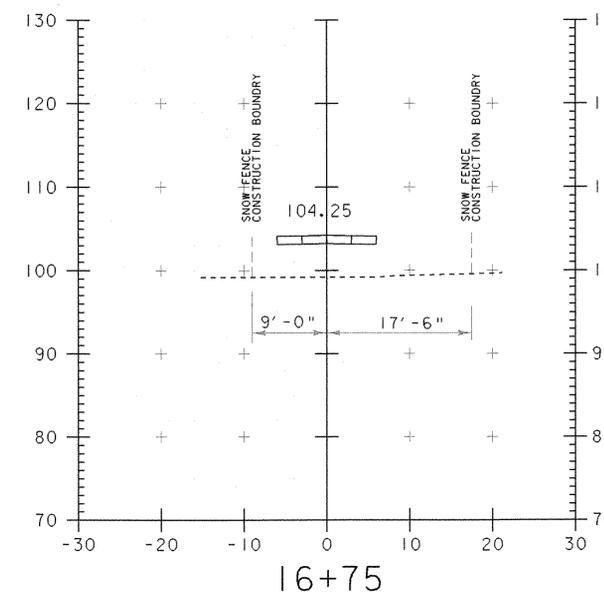

16+75

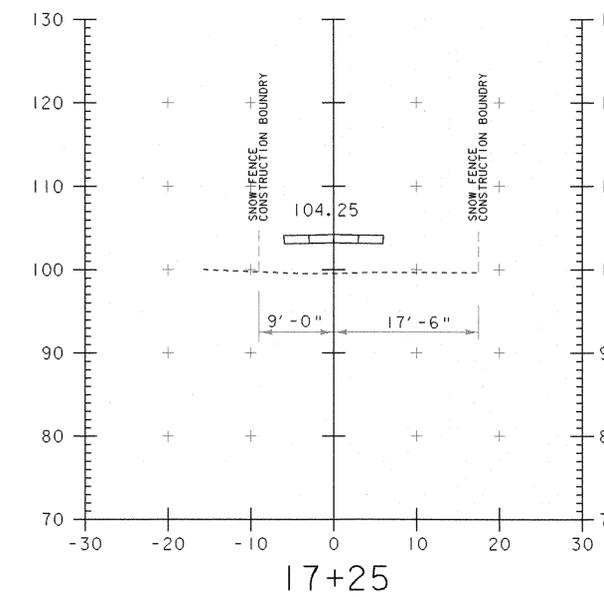

17+25

15+75 - 17+50

PROJECT NAME:	Burlington - Colchester
PROJECT NUMBER:	STP Bike(45)
FILE NAME: /str5/01f132/sf132xsl.dgn	PLOT DATE: 15-NOV-2002
PROJECT LEADER: C. Keller	DRAWN BY: G. Shangraw
DESIGNED BY: G. Shangraw	CHECKED BY:
sf132xs9.i	SHEET 78 OF 87