




26+80 Sta. 26+70 BEGIN COMMON EXCAVATION
BEGIN STONE FILL TYPE I

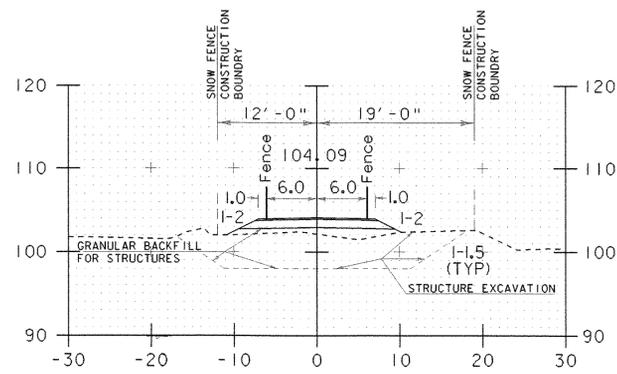


27+10
Sta. 27+05 END STONE FILL TYPE I

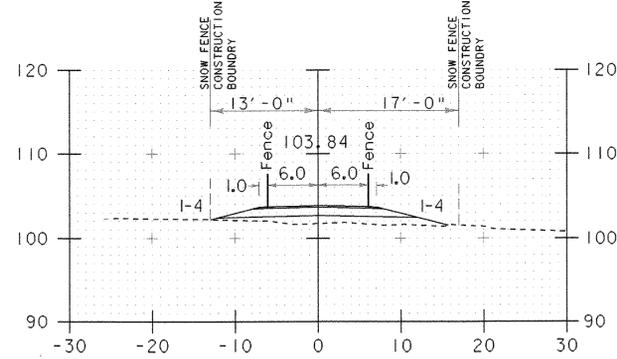


27+40
End Fence Lt. & Rt.
Begin Path Width Taper

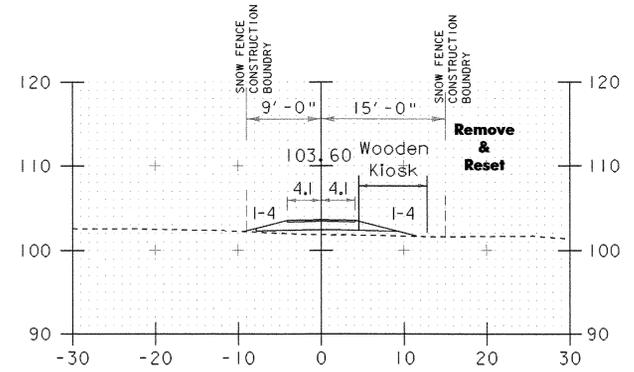


27+70

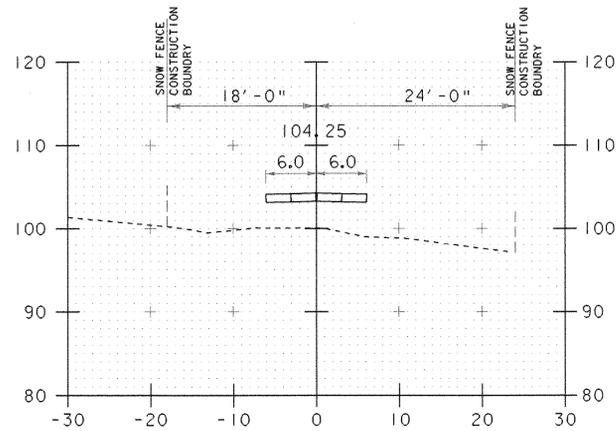


26+70

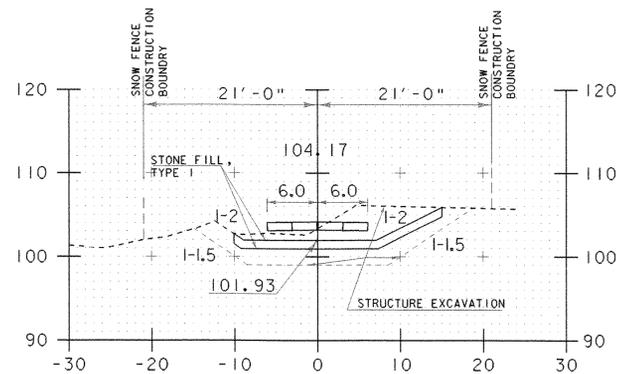


27+00 Sta. 27+00 END COMMON EXCAVATION

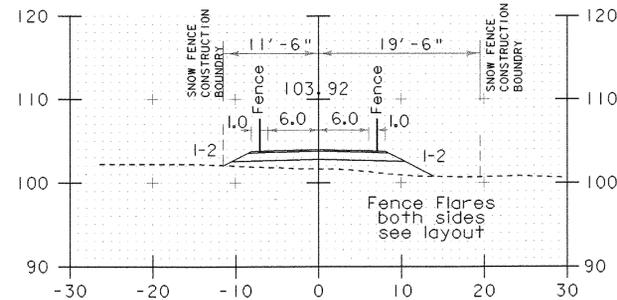


27+30

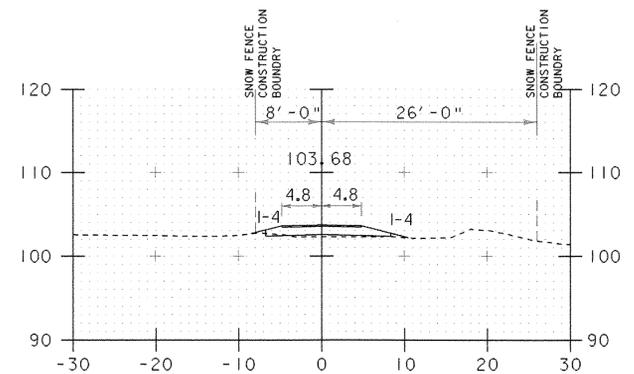


27+60

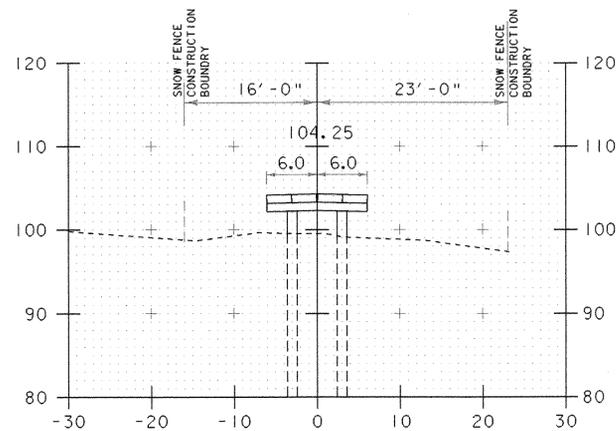


26+66

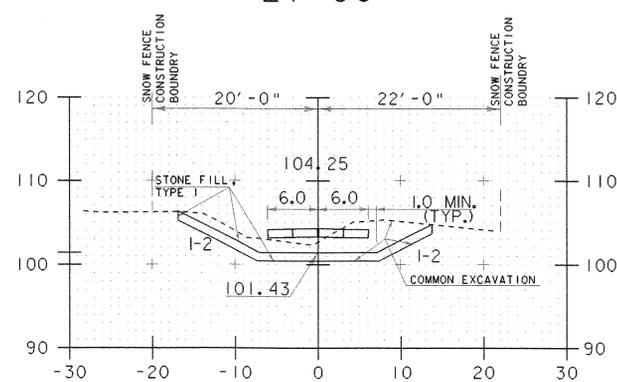

26+90

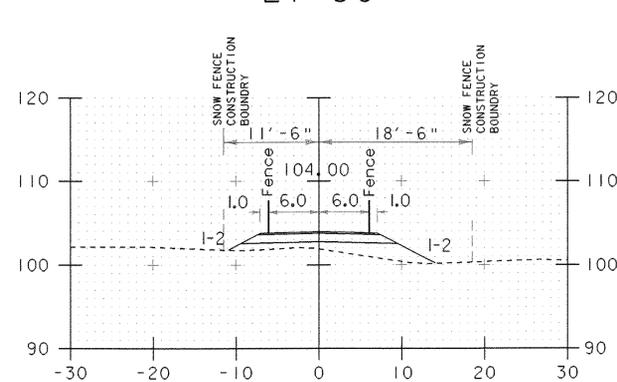

27+20

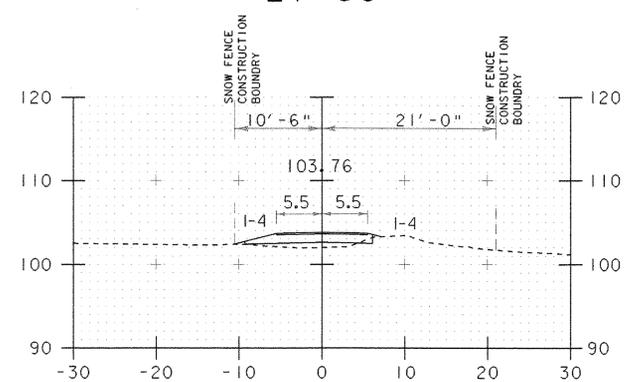

27+50

26+66 - 27+70

PROJECT NAME:	Burlington - Colchester
PROJECT NUMBER:	STP Bike(45)
FILE NAME:	/str5/01f132/sf132xsl.dgn
PROJECT LEADER:	C. Keller
DESIGNED BY:	G. Shangraw
PLLOT DATE:	15-NOV-2002
DRAWN BY:	G. Shangraw
CHECKED BY:	
SHEET	85 OF 87