



28+00

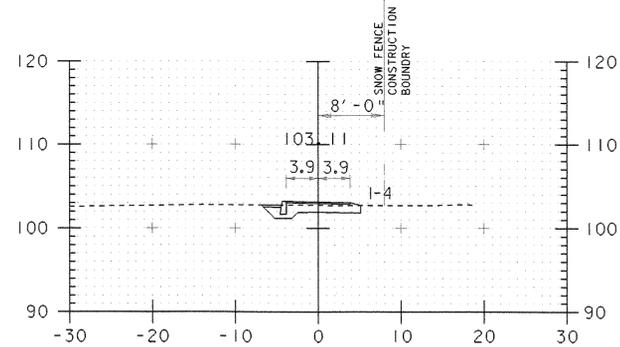


28+30

28+25 Begin Curbed Typical  
28+25 to 28+30 Construct Ramp

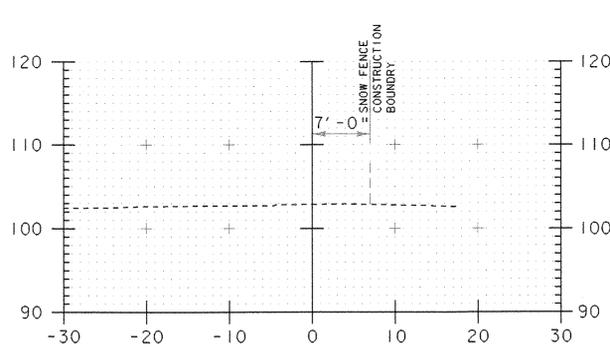


28+60


Match Existing Path

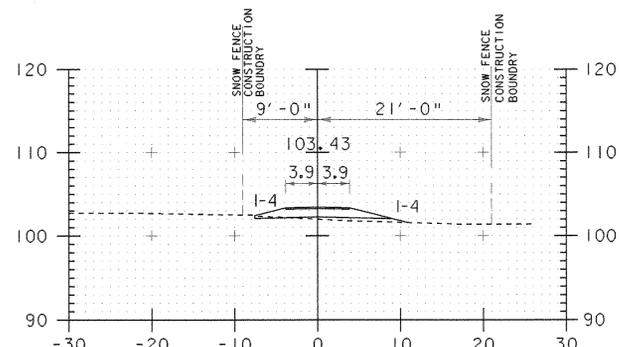


27+90

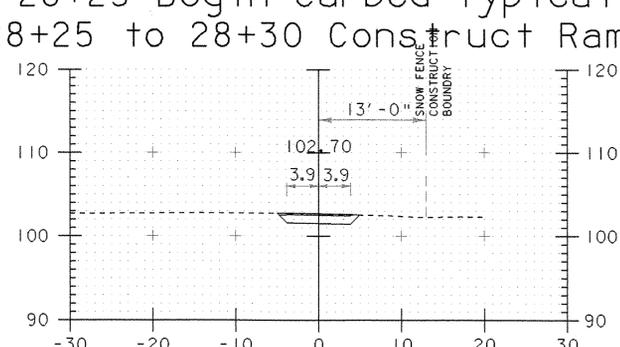

28+20

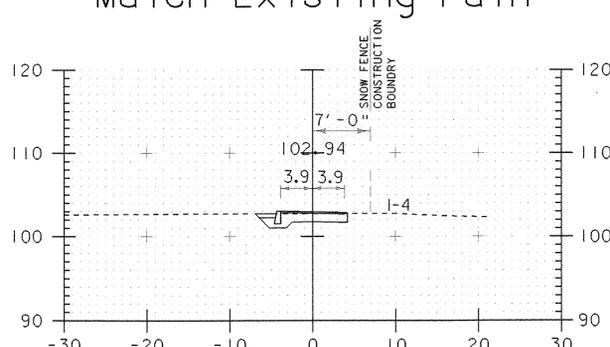


28+50

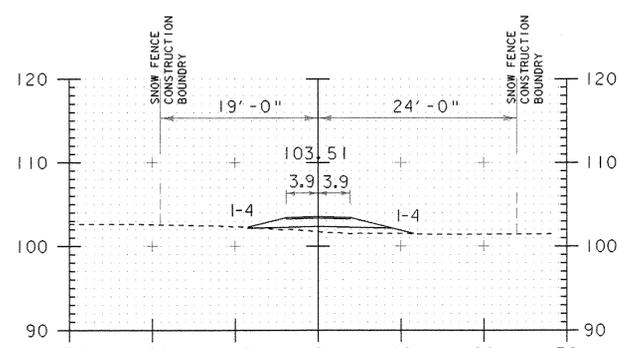


27+80

End Path Width Taper

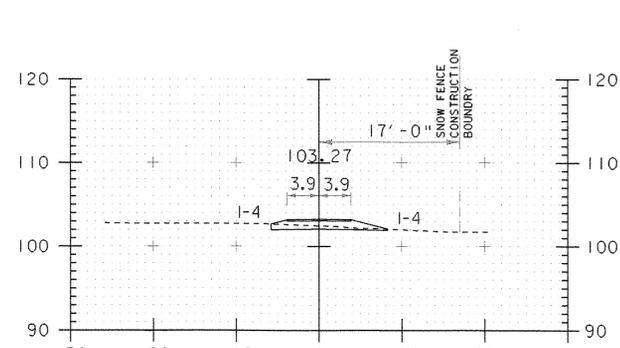

28+10

28+10 to 28+15  
Construct Ramp

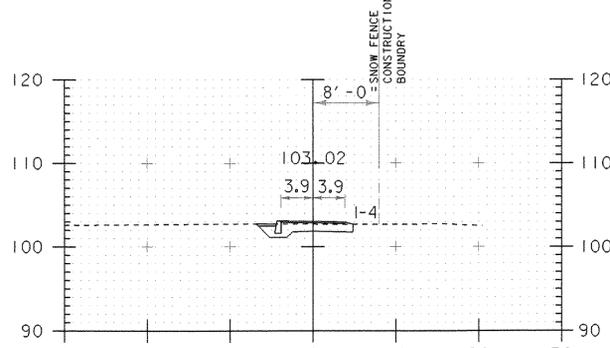

28+40

**27+80 - 28+60**

PROJECT NAME:	BURLINGTON - COLCHESTER
PROJECT NUMBER:	STP Bike(45)
FILE NAME:	/str5/01f132/sf132xsl.dgn
PROJECT LEADER:	C. Keller
DESIGNED BY:	G. Shangraw
PLOT DATE:	15-NOV-2002
DRAWN BY:	
CHECKED BY:	
SHEET	86 OF 87