




ANCHOR BOLT LAYOUT

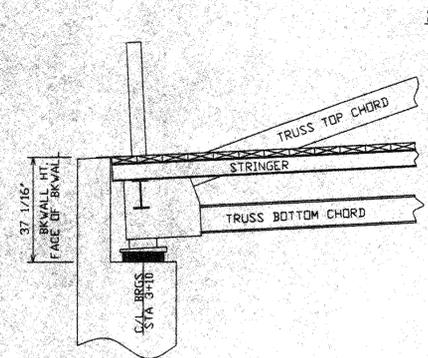


BACKWALL HEIGHT  
REAR (SOUTH) ABUTMENT

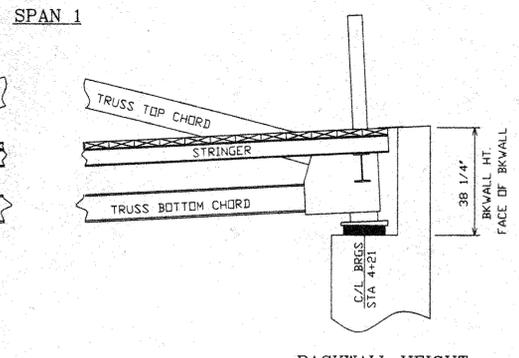


BACKWALL HEIGHT  
PIER 1

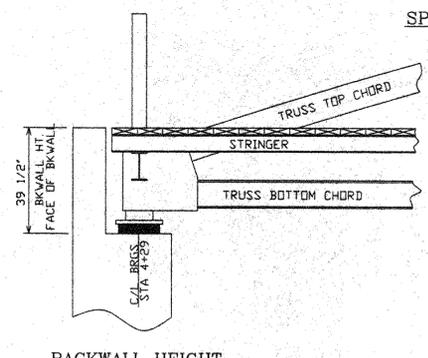


BACKWALL HEIGHT  
PIER 1

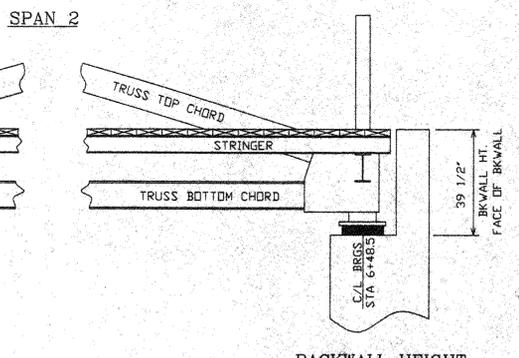

BACKWALL HEIGHT  
PIER 2

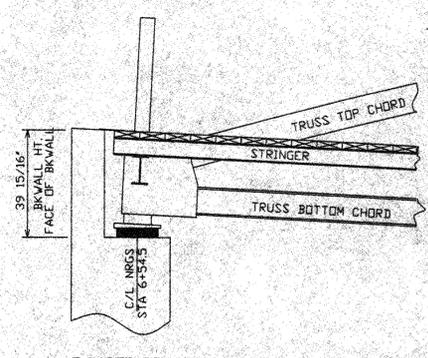

BACKWALL HEIGHT  
PIER 2

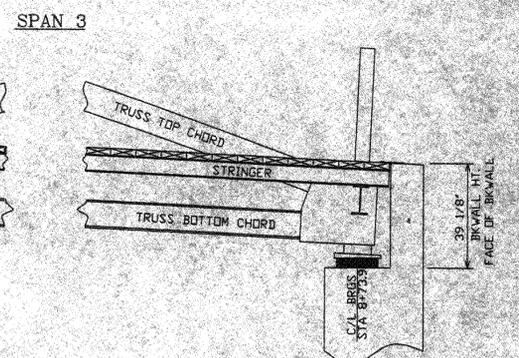

BACKWALL HEIGHT  
FORWARD (NORTH) ABUTMENT

RECEIVED  
 CWD BY: *W. Hill*  
 SEP 09 2003  
 RESUBMIT APPROVED  
 BY: *[Signature]* DATE: 9/12/03

NOTE: DRAWINGS RELATIVE DO NOT SCALE

*[Signature]*  
 9/15/03

NO.	DATE	REVISIONS	BY	564' X 12' THREE SPAN PEDESTRIAN BRIDGE BEARING & ABUTMENT DETAILS BURLINGTON - COLCHESTER BIKE PATH CHITTENDEN COUNTY, VERMONT
1	09/02/03	CHANGE BACKWALL HGT.	RES	
				DESIGN SAF
				DRAWN RES
				DATE AUG. 04, 2003
				DRAWING NO. VERMONT
				CHECK/DATE SAF
				FABRICATOR US BRIDGE
				089
				SHEET 2 OF 2