


WELD DETAILS AT BOTTOM CHORD PANEL POINTS
VERTICAL AND DIAGONAL CONNECTIONS AT BOTTOM CHORD
6 LOCATIONS
1 SIMILAR LOCATION (2 DIAGONALS)
2 SIMILAR LOCATIONS (VERTICAL ONLY)

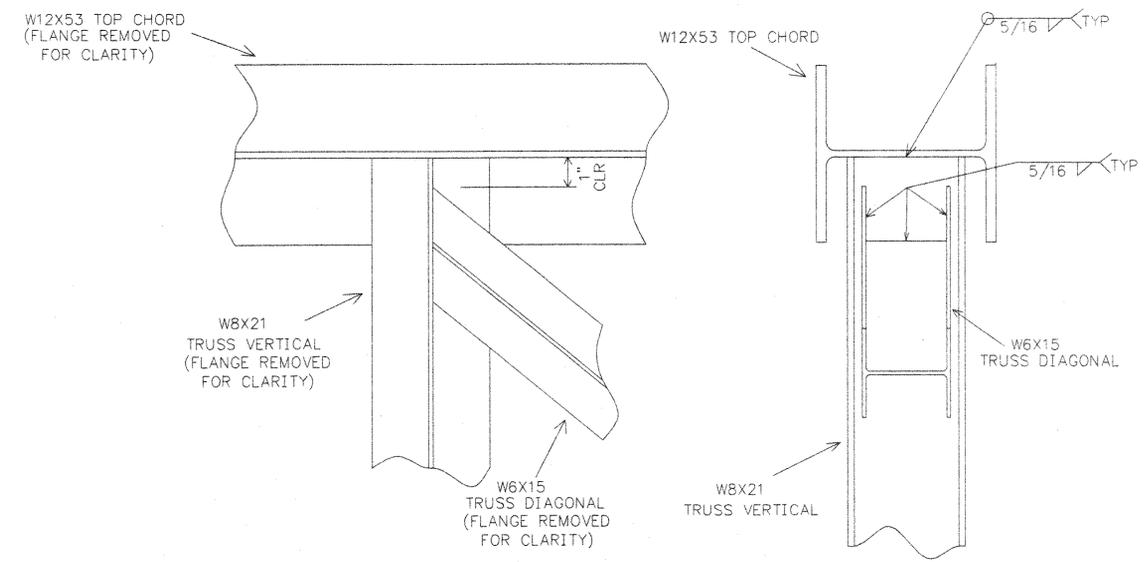

WELD DETAILS AT TOP CHORD PANEL POINTS
VERTICAL AND DIAGONAL CONNECTIONS AT TOP CHORD
8 LOCATIONS
1 SIMILAR LOCATION (NO DIAGONAL)

RECEIVED
CHKD BY: *MEM* OK'D BY: _____
APR 23 2003
RESUBMIT _____ APPROVED _____
BY: _____ DATE: 4/29/03

NOTE: DRAWINGS RELATIVE (DO NOT SCALE)

| NO. | DATE | REVISIONS | BY |
|-----|------|-----------|----|
| | | | |
| | | | |
564' X 12' THREE SPAN PEDESTRIAN BRIDGE
BURLINGTON - COLCHESTER
SPAN 1 - 111'-1 1/2"
CHITTENDEN COUNTY, VERMONT

| | | | | |
|------------|----------------------|--------------------|------------------------|---------|
| DESIGN SAF | DRAWN SAF | DATE MAR. 13, 2003 | DRAWING NO. BURLINGTON | SHEET |
| CHECK/DATE | FABRICATOR US BRIDGE | | 095 | 6 OF 18 |