



REAR (SOUTH) ABUTMENT

BRIDGE AND RAIL SPLICES


PIER 1

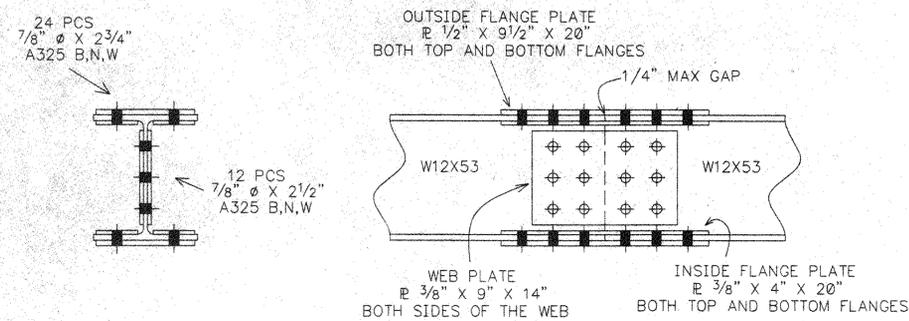


U5U6 TOP CHORD SPLICE

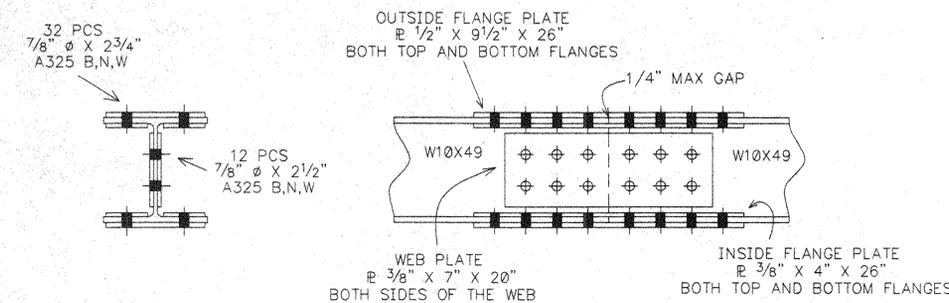


L5L6 BOTTOM CHORD SPLICE

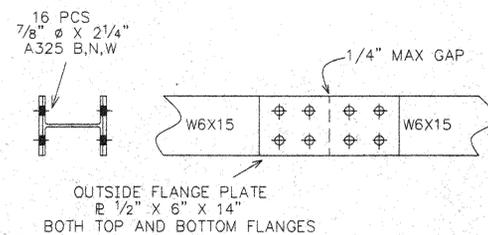


U5L6 DIAGONAL SPLICE

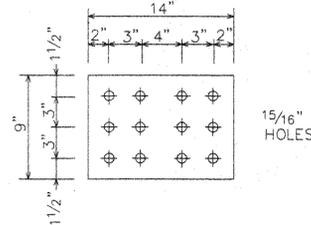


U5U6 TOP CHORD WEB SPLICE PLATES

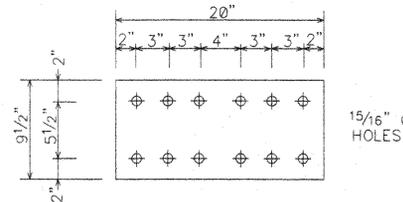


U5U6 TOP CHORD OUTSIDE FLANGE SPLICE PLATES

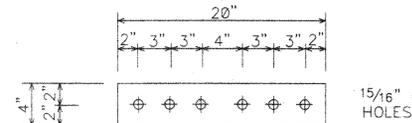


U5U6 TOP CHORD INSIDE FLANGE SPLICE PLATES

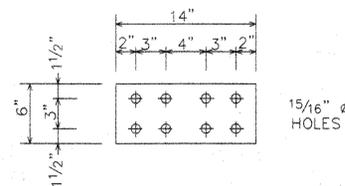


U5L6 DIAGONAL FLANGE SPLICE PLATES

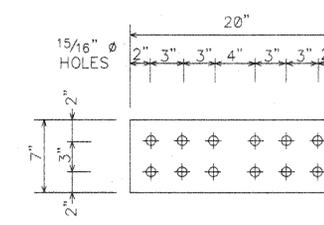

L5L6 BOTTOM CHORD WEB SPLICE PLATES

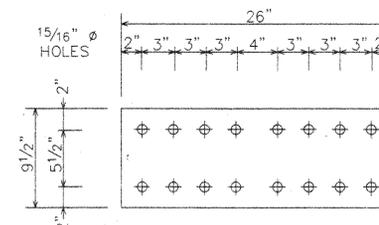

L5L6 BOTTOM CHORD OUTSIDE FLANGE SPLICE PLATES

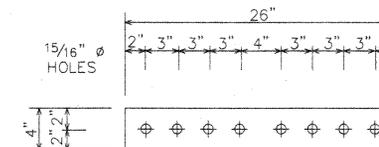

L5L6 BOTTOM CHORD INSIDE FLANGE SPLICE PLATES

NOTE: DRAWINGS RELATIVE (DO NOT SCALE)

RECEIVED
 OK'D BY: *MEM*
 APR 23 2003
 RESUBMIT APPROVED
 BY: *MEM* DATE: 4/20/03

NO.	DATE	REVISIONS	BY	564' X 12' THREE SPAN PEDESTRIAN BRIDGE BURLINGTON - COLCHESTER SPAN 1 - 111'-1 1/2" CHITTENDEN COUNTY, VERMONT			
				DESIGN SAF	DRAWN SAF	DATE MAR. 13, 2003	DRAWING NO. BURLINGTON
				CHECK/DATE	FABRICATOR US BRIDGE		SHEET 7 OF 16