




BRIDGE FLOOR FRAMING PLAN

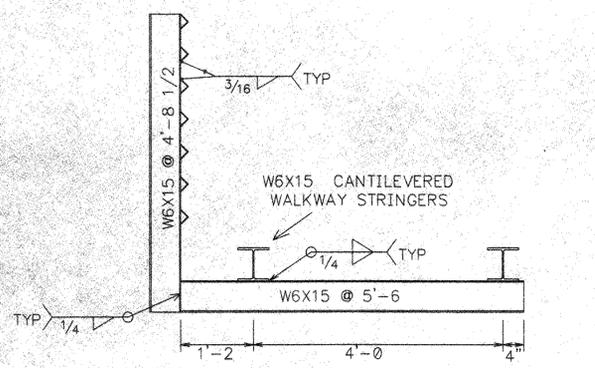

SIDEWALK POST AND POST SUPPORT DETAIL
32 LOCATIONS

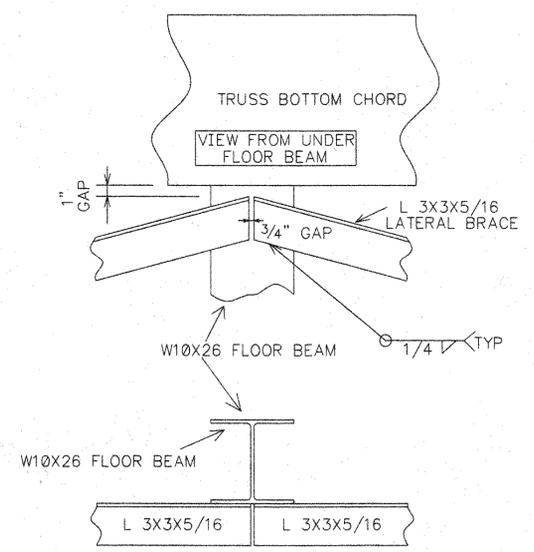

**DETAIL 1
LATERAL BRACE DETAIL**
10 LOCATIONS AS SHOWN
4 LOCATIONS SIMILAR (1 LATERAL)

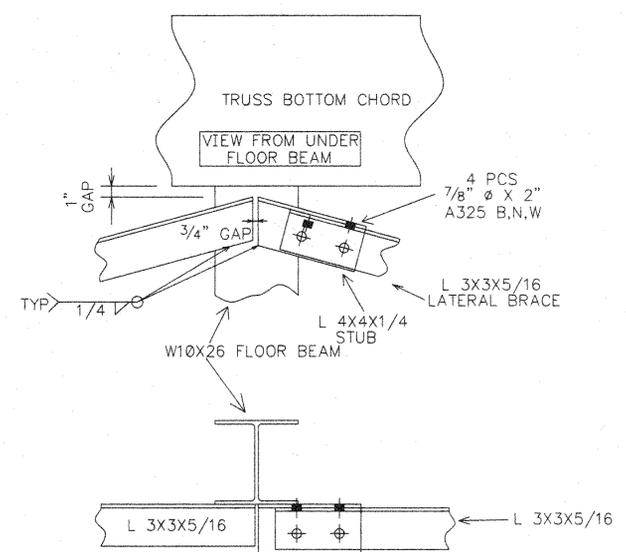

**DETAIL 2
LATERAL BRACE DETAIL**
4 LOCATIONS AS SHOWN
AT TRUSS BOLTED CONNECTION PANELS

RECEIVED
CHK'D BY *Wem* OK'D BY _____
APR 23 2003
RESUBMIT _____ APPROVED _____
BY _____ DATE 4/29/03

NO.	DATE	REVISIONS	BY

564' X 12' THREE SPAN PEDESTRIAN BRIDGE
BURLINGTON - COLCHESTER
SPAN 2 - 219'-6"
CHITTENDEN COUNTY, VERMONT

DESIGN SAF	DRAWN SAF	DATE MAR. 26, 2003	DRAWING NO. BURLINGTON
CHECK/DATE	FABRICATOR US BRIDGE		SHEET 098 9 OF 16

NOTE: DRAWINGS RELATIVE (DO NOT SCALE)