



PIER 1

BRIDGE AND RAIL SPLICES

PIER 2

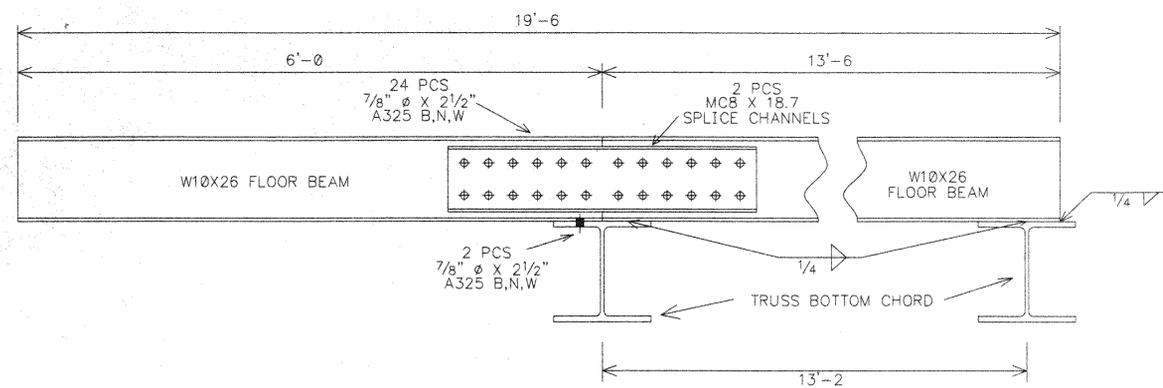

FLOOR BEAM DETAILS

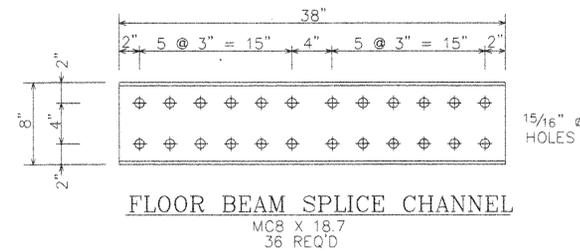

RECEIVED
 CHK'D BY: *[Signature]*
 APR 23 2003
 RESUBMIT: _____ APPROVED: *[Signature]*
 BY: _____ DATE: 4/29/03

NOTE: DRAWINGS RELATIVE (DO NOT SCALE)

NO.	DATE	REVISIONS	BY	564' X 12' THREE SPAN PEDESTRIAN BRIDGE BURLINGTON - COLCHESTER SPAN 2 - 219'-6" CHITTENDEN COUNTY, VERMONT			
				DESIGN SAF	DRAWN SAF	DATE MAR. 26, 2003	DRAWING NO. BURLINGTON
				CHECK/DATE	FABRICATOR US BRIDGE		SHEET 12 OF 15

101