



TOP CHORD CAMBER DIAGRAM

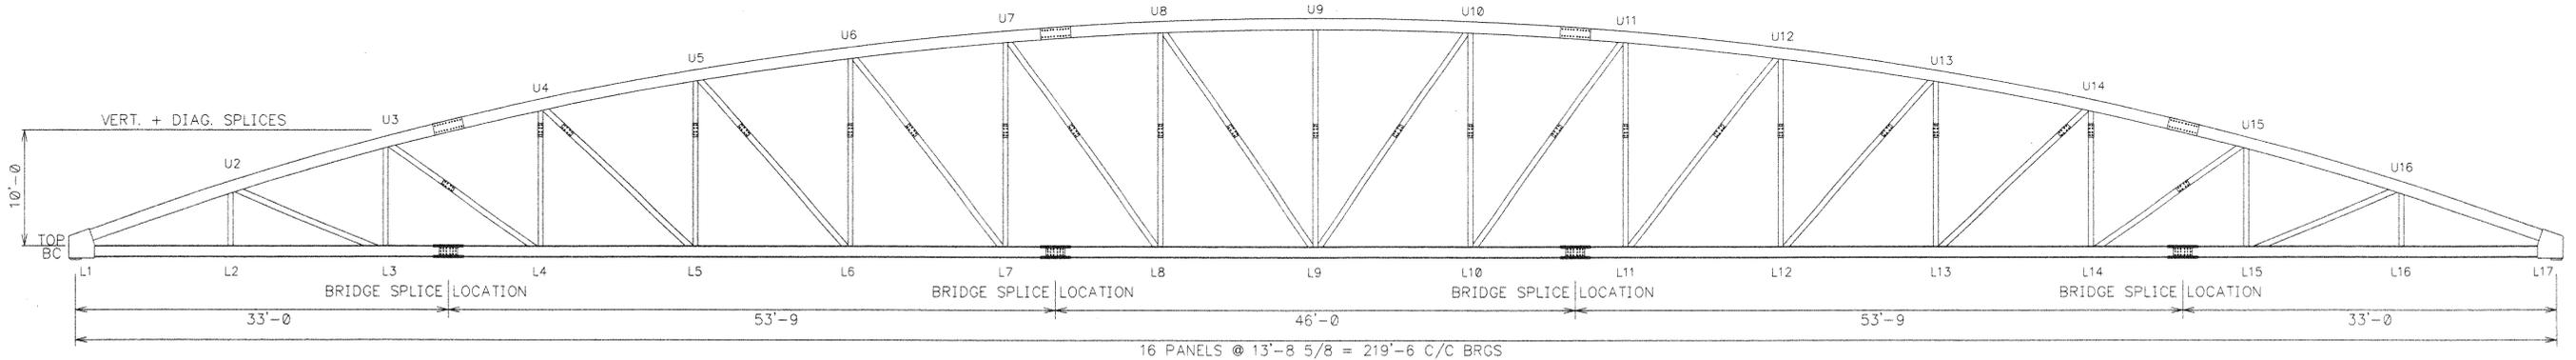


TRUSS BRIDGE ELEVATION VIEW - SPAN 3

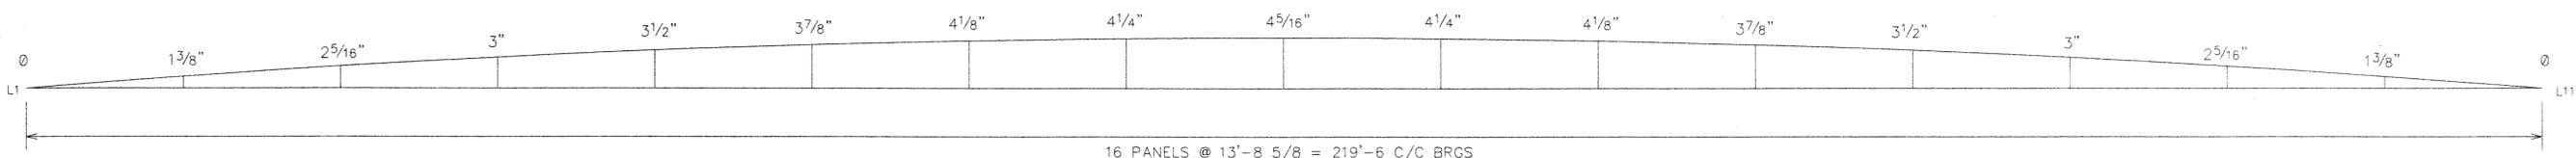

BOTTOM CHORD CAMBER DIAGRAM

CAMBER TO OFFSET DEAD LOAD ONLY

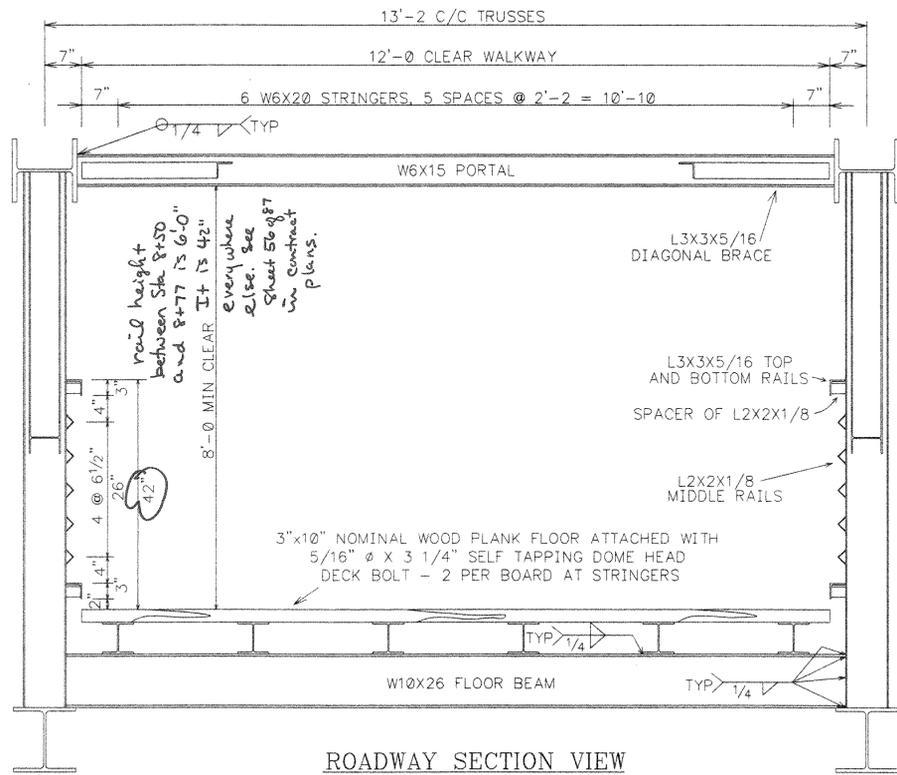

ROADWAY SECTION VIEW

NOTE: DRAWINGS RELATIVE (DO NOT SCALE)

TRUSS MEMBER CHART	
TRUSS MEMBER	SIZE
TOP CHORD	W12X65
BOTTOM CHORD	W12X58
VERTICALS	W8X21
DIAGONALS	W6X15

GENERAL NOTES

- ALL WELDED WEATHERING STEEL TRUSS BRIDGE
- ALL SUPERSTRUCTURE STRUCTURAL STEEL ASTM A709 GR 50W WEATHERING TYPE STEEL (A588)
- ALL WELDING PERFORMED IN COMPLIANCE WITH AMERICAN WELDING SOCIETY D1.5 BRIDGE WELDING CODE.
- 3" X 10" NOMINAL WOOD PLANK FLOORING SOUTHERN YELLOW PINE GRADE NO. 1, CCA TREATED 0.4 LBS PENETRATION.
- TRUSS TOP AND BOTTOM CHORD CAMBER TOLERANCES SHALL BE AS SPELLED OUT IN AWS D1.5 (2002) TABLE 1.5. CAMBER TOLERANCE FOR TYPICAL GIRDER

APPROVED BY: *[Signature]*
 APR 23 2003
 RESUBMIT X APPROVED BY: *[Signature]*
 DATE 4/23/03

NO.	DATE	REVISIONS	BY

564' X 12' THREE SPAN PEDESTRIAN BRIDGE			
BURLINGTON - COLCHESTER			
SPAN 3 - 219'-6"			
CHITTENDEN COUNTY, VERMONT			
DESIGN SAF	DRAWN SAF	DATE MAR. 27, 2003	DRAWING NO. BURLINGTON
CHECK/DATE	FABRICATOR US BRIDGE		SHEET 103 OF 18