




**BRIDGE PORTAL DETAILS**

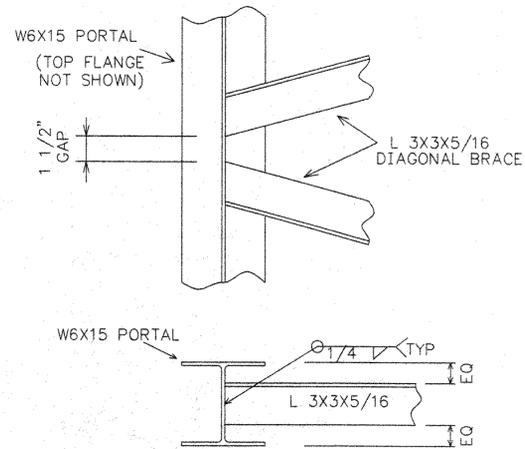


**DETAIL 1**  
WELDED DIAGONAL BRACE CONNECTION  
8 LOCATIONS

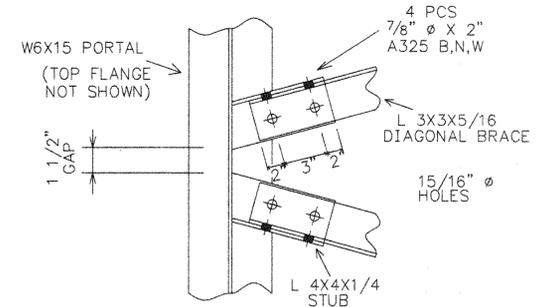

**DETAIL 3**  
BOLTED DIAGONAL BRACE CONNECTION  
AT TRUSS BOLTED BAY LOCATIONS  
2 LOCATIONS

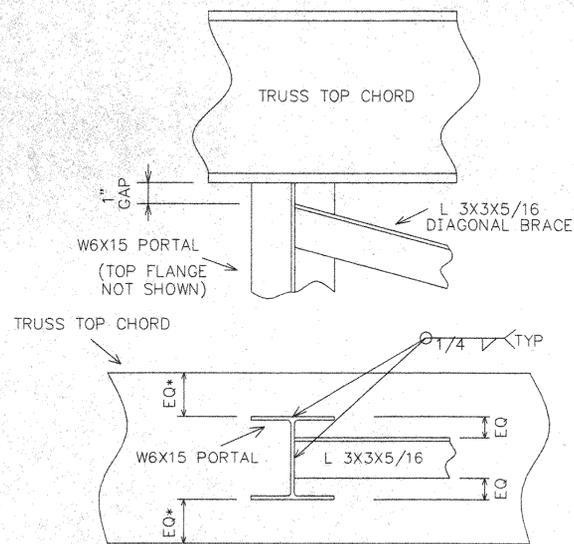

**DETAIL 2**  
WELDED DIAGONAL BRACE AND PORTAL CONNECTION  
16 LOCATIONS

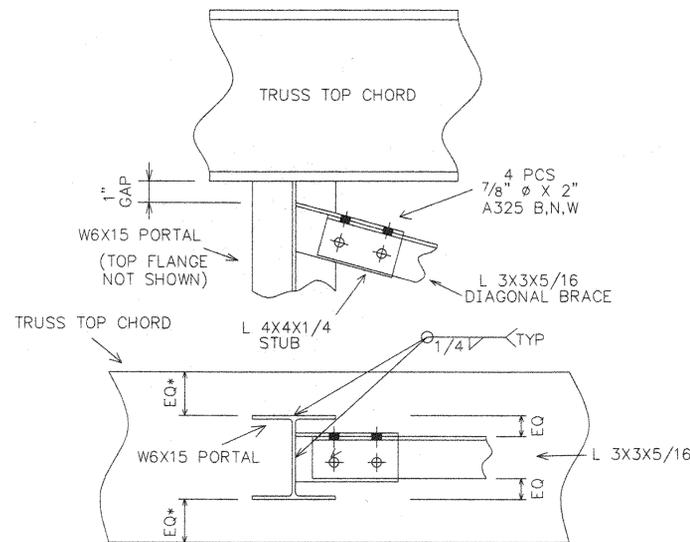

**DETAIL 4**  
BOLTED DIAGONAL BRACE CONNECTION  
AT TRUSS BOLTED BAY LOCATIONS  
4 LOCATIONS

NOTE: DRAWINGS RELATIVE (DO NOT SCALE)

RECEIVED  
OK'D BY *MEM* OK'D BY \_\_\_\_\_  
APR 23 2003  
RESUBMIT \_\_\_\_\_ APPROVED \_\_\_\_\_  
BY \_\_\_\_\_ DATE 4/21/03

NO.	DATE	REVISIONS	BY

564' X 12' THREE SPAN PEDESTRIAN BRIDGE			
BURLINGTON - COLCHESTER			
SPAN 3 - 219'-6"			
CHITTENDEN COUNTY, VERMONT			
DESIGN	DRAWN	DATE	DRAWING NO.
SAF	SAF	MAR. 27, 2003	BURLINGTON
CHECK/DATE	FABRICATOR	US BRIDGE	SHEET
			105 16 OF 18