



SECTION A-A

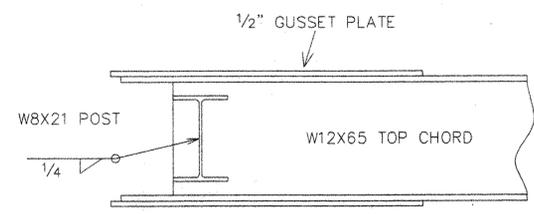


SECTION B-B
DETAIL SIMILAR AT U2 PANEL POINT

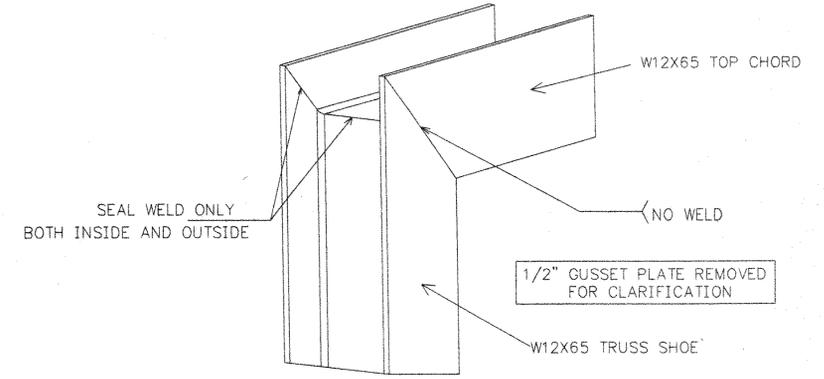


DETAIL 1

TRUSS SHOE TO TOP CHORD CONNECTION
2 LOCATIONS

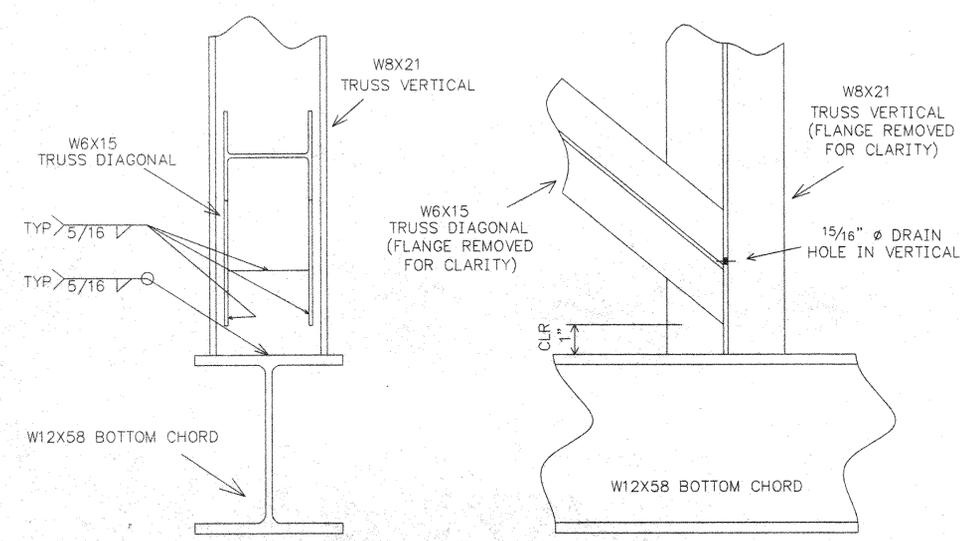

WELD DETAILS AT BOTTOM CHORD PANEL POINTS

VERTICAL AND DIAGONAL CONNECTIONS AT BOTTOM CHORD
12 LOCATIONS
1 SIMILAR LOCATION (2 DIAGONALS)
2 SIMILAR LOCATIONS (VERTICAL ONLY)

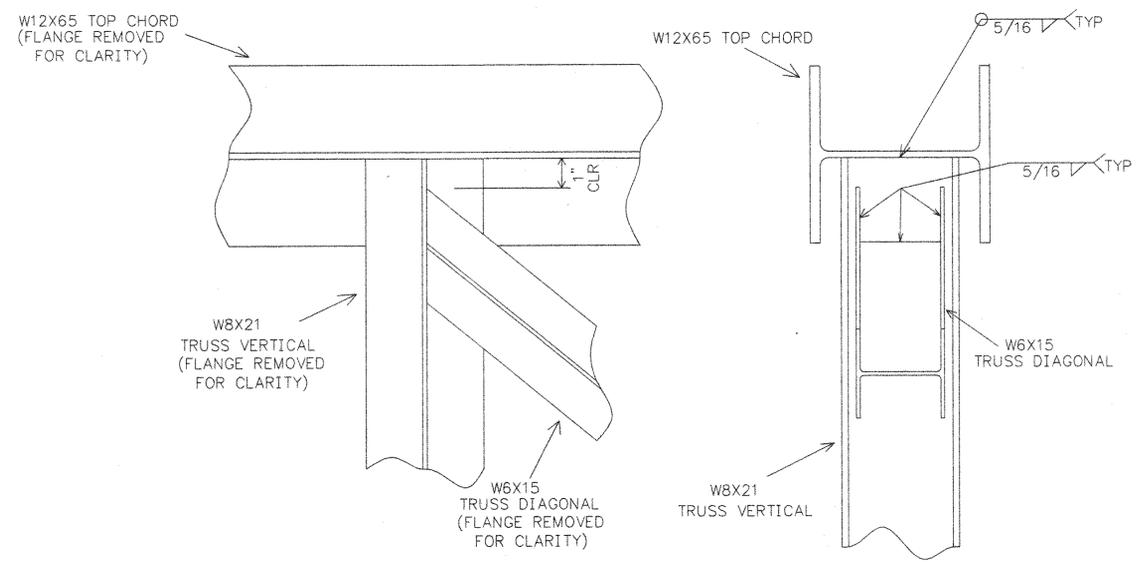

WELD DETAILS AT TOP CHORD PANEL POINTS

VERTICAL AND DIAGONAL CONNECTIONS AT TOP CHORD
14 LOCATIONS
1 SIMILAR LOCATION (NO DIAGONAL)

RECEIVED
OK'D BY: *meat* OK'D BY: _____
APR 23 2003
RESUBMIT _____ APPROVED _____
BY: _____ DATE: 4/29/03

NO.	DATE	REVISIONS	BY	564' X 12' THREE SPAN PEDESTRIAN BRIDGE BURLINGTON - COLCHESTER SPAN 3 - 219'-6" CHITTENDEN COUNTY, VERMONT			
				DESIGN	DRAWN	DATE	DRAWING NO.
				SAF	SAF	MAR. 27, 2003	BURLINGTON
				CHECK/DATE	FABRICATOR		
					US BRIDGE		
							SHEET
							106
							17 OF 18

NOTE: DRAWINGS RELATIVE (DO NOT SCALE)